



October 2016

Dynergy Zimmer, LLC
1781 US Route 52
Moscow, OH 45153

**RE: History of Construction
USEPA Final CCR Rule, 40 CFR § 257.73(c)
Zimmer Power Station
Moscow, Ohio**

On behalf of Dynergy Zimmer, LLC, AECOM has prepared the following history of construction for the Coal Pile Runoff Pond and D Basin at the Zimmer Power Station in accordance with 40 CFR § 257.73(c). The Gypsum Recycle Pond is an incised pond with a storage volume of less than 20 acre-feet. A history of construction is not required for Gypsum Recycle Pond as specified in § 257.73(b).

BACKGROUND

40 CFR § 257.73(c)(1) requires the owner or operator of an existing coal combustion residual (CCR) surface impoundment that either (1) has a height of five feet or more and a storage volume of 20 acre-feet or more, or (2) has a height of 20 feet or more to compile a history of construction by October 17, 2016 that contains, to the extent feasible, the information specified in 40 CFR § 257.73(c)(1)(i)–(xii).

The history of construction presented herein was compiled based on existing documentation, to the extent that it is reasonably and readily available (see 80 Fed. Reg. 21302, 21380 [April 17, 2015]), and AECOM's site experience. AECOM's document review included record drawings, geotechnical investigations, pipe inspection reports, etc. for the Coal Pile Runoff Pond and D Basin at the Zimmer Power Station.

HISTORY OF CONSTRUCTION

§ 257.73(c)(1)(i): The name and address of the person(s) owning or operating the CCR unit; the name associated with the CCR unit; and the identification number of the CCR unit if one has been assigned by the state.

Operator: Dynegy Zimmer, LLC

Address: 1500 Eastport Plaza Drive
Collinsville, IL 62234

CCR Units: Coal Pile Runoff Pond, ODNR Dam ID No. 8741-010, NID ID No. OH01393
D Basin

The D Basin does not have a state assigned identification number.

§ 257.73(c)(1)(ii): The location of the CCR unit identified on the most recent USGS 7¹/₂ or 15 minute topographic quadrangle map or a topographic map of equivalent scale if a USGS map is not available.

The locations of the Coal Pile Runoff Pond and D Basin have been identified on an USGS 7-1/2 minute topographic quadrangle map in **Appendix A**.

§ 257.73(c)(1)(iii): A statement of the purpose for which the CCR unit is being used.

The following captures the purpose of the CCR unit:

- The Coal Pile Runoff Pond is being used to clarify D Basin discharge water, FGD waste streams, landfill leachate water, and other non-CCR wastewater.
- The D Basin is being used to dewater dredged CCR and non-CCR material from other ponds. The dewatered material is excavated and transported to the Zimmer landfill.

§ 257.73(c)(1)(iv): The name and size in acres of the watershed where the CCR unit is located.

The Coal Pile Runoff Pond and D Basin are located in the Little Indian Creek-Ohio River Watershed with a 12-digit Hydrologic Unit Code (HUC) of 050902011107 with a drainage area of 15,657 acres (USGS, 2016).

§ 257.73(c)(1)(v): A description of the physical and engineering properties of the foundation and abutment materials on which the CCR unit is constructed.

The foundation materials for the Coal Pile Runoff Pond and D Basin consists of, from top to bottom, fine grained alluvial soils, coarse grained soils, and bedrock. The physical properties of the fine grained alluvial soil are described as soft to stiff, moist, lean clay. The coarse grained foundation soils are described as medium dense to very dense, fine sand, silty sand, and gravelly sand. Portions of the fine grained soil and coarse grained soil are separated by a layer comprised of silty clayey sand and silt. The bedrock is described as limestone. An available summary of the engineering properties of the foundation materials is presented in **Table 1** below. The engineering properties are based on previous geotechnical explorations and laboratory testing.

Table 1. Summary of Foundation Material Engineering Properties

Material	Unit Weight (pcf)	Effective (drained) Shear Strength Parameters		Total (undrained) Shear Strength Parameters	
		c' (psf)	Φ' (°)	c (psf)	Φ (°)
Alluvial Clays	128	200	30	600	16
Silty Clayey Sand	128	150	35	400	16
Fine Sand, Silty Sand, Gravelly Sand	120	0	31	0	31
Limestone	140	Impenetrable			

The Coal Pile Runoff Pond and D Basin are enclosed impoundments with embankments and do not have abutments.

§ 257.73(c)(1)(vi): A statement of the type, size, range, and physical and engineering properties of the materials used in constructing each zone or stage of the CCR unit; the method of site preparation and construction of each zone of the CCR unit; and the approximate dates of construction of each successive stage of construction of the CCR unit.

The construction of the Coal Pile Runoff Pond included a 3-foot thick compacted clay liner. The physical and engineering properties for the clay liner are not reasonably and readily available. Physical properties of the embankment materials for the Coal Pile Runoff Pond are described as very stiff to hard fine grained material typically classified as sandy lean clay. An available summary of the engineering properties of the embankment construction materials is presented in **Table 2** below. The engineering properties are based on previous geotechnical explorations and laboratory testing.

D Basin was constructed over a portion of the historical coal storage area. The historical coal storage area was originally constructed as an enclosed impoundment with embankments and lined with a 3-foot thick compacted clay liner. Common fill was placed at a variable thickness over the historical clay liner to raise the subbase elevation for D Basin construction.

Construction of the D Basin typical liner section consisted of (from bottom to top) a 1-foot thick new clay liner layer with a designed permeability of 1×10^{-7} cm/s, a geotextile fabric, a 1-foot thick granular material underdrain layer with 6-inch diameter (dia.) high density polyethylene (HDPE) underdrain piping, a second geotextile fabric, and a 2-foot thick bottom ash protection layer. Physical properties of the embankment materials for D Basin are described as medium dense to very dense coarse grained material typically classified as silty clayey sand with gravel and silty sand with gravel. An available summary of the engineering properties of the embankment construction materials is presented in **Table 2** below. The engineering properties are based on previous geotechnical explorations and laboratory testing. The physical and engineering properties for the other above-mentioned liner materials are not reasonably and readily available.

Table 2. Summary of Embankment Construction Material Engineering Properties

Material	Unit Weight (pcf)	Effective (drained) Shear Strength Parameters		Total (undrained) Shear Strength Parameters	
		c' (psf)	Φ' (°)	c (psf)	Φ (°)
Sandy Lean Clay (CL)	128	50	30	225	20
Silty Clayey Sand with Gravel	127	0	30	0	30

The method of site preparation and construction for the Coal Pile Runoff Pond is not reasonably and readily available. Site preparation and construction of the D Basin were completed in accordance with the *Dewatering Basin "D"* record drawings (presented in **Appendix B**).

The approximate dates of construction of each successive stage of construction of the Coal Pile Runoff Pond and D Basin are provided in **Table 3** below.

Table 3. Approximate dates of construction of each successive stage of construction.

Date	Event
Prior to 1985	Development of historical impoundment
1986-1987	Conversion of historical impoundment to coal pile storage area
1987	Construction of Coal Pile Runoff Pond
2003	Construction of D Basin over portion of coal pile storage area

§ 257.73(c)(1)(vii): At a scale that details engineering structures and appurtenances relevant to the design, construction, operation, and maintenance of the CCR unit, detailed dimensional drawings of the CCR unit, including a plan view and cross sections of the length and width of the CCR unit, showing all zones, foundation improvements, drainage provisions, spillways, diversion ditches, outlets, instrument locations, and slope protection, in addition to the

normal operating pool surface elevation and the maximum pool surface elevation following peak discharge from the inflow design flood, the expected maximum depth of CCR within the CCR surface impoundment, and any identifiable natural or manmade features that could adversely affect operation of the CCR unit due to malfunction or mis-operation.

Drawings that contain items pertaining to the requested information for the Coal Pile Runoff Pond and D Basin are listed in **Table 4** below. Items marked as "Not Available" are items not found during a review of the reasonably and readily available record documentation.

Table 4. List of drawings containing items pertaining to the information requested in § 257.73(c)(1)(vii).

	Coal Pile Runoff Pond	D Basin
Dimensional plan view (all zones)	1-30250	1-30250B, 1-30250E
Dimensional cross sections	1-30253	1-30250C, 1-30250D
Foundation Improvements	1-30253	1-30250C, 1-30250D, 1-30250H
Drainage Provisions	Not Applicable	1-30250C to 1-30250E, 1-5434-01 to 1-5434-03
Spillways and Outlets	Not Available	1-30250B, 1-30250F, 1-30250G 1-5434-01 to 1-5434-03
Diversion Ditches	Not Applicable	Not Applicable
Instrument Locations	Plate 2	Fig. No. 2A
Slope Protection	Not Available	1-30250C, 1-30250D, 1-30250H
Normal Operating Pool Elevation	1-30253	1-30250G
Maximum Pool Elevation	Not Available	1-30250G
Approximate Maximum Depth of CCR in 2016	16 feet	8 feet

All drawings referenced in **Table 4** above can be found in **Appendix B** and **Appendix C**.

Based on the review of the drawings listed above, no natural or manmade features that could adversely affect operation of these CCR units due to malfunction or mis-operation were identified.

§ 257.73(c)(1)(viii): A description of the type, purpose, and location of existing instrumentation.

Existing instrumentation within the Coal Pile Runoff Pond includes a vibrating-wire piezometer installed in 2014. The purpose of the piezometer is to measure the pore water pressure within the embankment. A location map of the existing piezometer instrumentation (B-WW-1401) is shown on Plate 2 presented in **Appendix C**.

Existing instrumentation within the D Basin include open-standpipe piezometers installed in 2015 near the western embankment. The purpose of the piezometers is to measure the pore water pressures at the crest and toe of the outer embankment. There are two (2) piezometers adjacent to D Basin. A location map of the existing piezometer instrumentation is shown on Figure 2A presented in **Appendix C**.

§ 257.73(c)(1)(ix): Area-capacity curves for the CCR unit.

Area-capacity curves for the Coal Pile Runoff Pond and D Basin are not reasonably and readily available.

§ 257.73(c)(1)(x): A description of each spillway and diversion design features and capacities and calculations used in their determination.

The Coal Pile Runoff Pond contains two (2) 15-inch diameter (dia.) high density polyethylene (HDPE) pipe culverts located in the northeast corner of the impoundment. The pipe culverts drain into the adjacent Wastewater Pond. In 2016, the discharge capacity of the Coal Pile Runoff Pond was evaluated using HydroCAD 10 software modeling a 1,000-year, 24-hour rainfall event. The model results indicate that the Coal Pile Runoff Pond spillway has enough water storage capacity and will not overtop the embankment during the 1,000-year, 24-hour storm event. The results of the HydroCAD 10 analysis are presented below in **Table 5**.

D Basin drains into a reinforced concrete sump structure that contains two sump pumps. The lead pump activates when the sump liquid level reaches El. 485.2 feet and the lag pump activates when the sump fluid level reaches El. 486.7 feet. The minimum pump liquid level, or shut-off level, is at El. 481.7 feet. Both pumps drain into separate 6-inch dia. HDPE pipes that discharge into the Coal Pile Runoff Pond. D Basin also contains a 10-foot-wide emergency overflow spillway with an invert elevation of 504 feet. The overflow spillway drains into the adjacent C Basin. Unless otherwise mentioned, all elevations in this report are on datum NAVD88.

In 2016, the discharge capacity of D Basin was evaluated using HydroCAD 10 software modeling a 1,000-year, 24-hour rainfall event. During the modeled event, the Ohio River flood pool would back up into the D Basin through the outfall structures from the Clearwater Pond and from emergency outfall structures for the A, B, and C Basins. During this scenario,

the Wastewater Pond Complex would be flooded to an elevation of 506 feet, and the D Basin would be part of a continuous pool that is also comprised of the A, B, and C Basin. The model results indicated that the Wastewater Pond Complex had enough storage capacity above the Ohio River flood pool level and will not overtop the perimeter embankment during the 1,000-year, 24-hour storm event. The results of the HydroCAD 10 analysis are presented below in **Table 5**.

Table 5. Results of HydroCAD 10 analysis

	Coal Pile Runoff Pond	Combined Basins (A, B, C & D)
Approximate Minimum Berm Elevation ¹ (ft)	509.2	509.0
Approximate Emergency Spillway Elevation ¹ (ft)	Not Applicable	Not Applicable
Starting Pool Elevation ¹ (ft)	507.9	506.0
Peak Elevation ¹ (ft)	509.0	506.8
Time to Peak (hr)	12.2	13.0
Surface Area (ac)	2.5	27.3
Storage ² (ac-ft)	2.8	20.8

Note: 1. Elevations are based on NAVD88 datum
 2. Storage given is from Starting Pool Elevation to Peak Elevation.

§ 257.73(c)(1)(xi): The construction specifications and provisions for surveillance, maintenance, and repair of the CCR unit.

The construction specifications for the Coal Pile Runoff Pond are not reasonably and readily available. Available construction specifications for D Basin are outlined on Drawing 1-30250H presented in **Appendix B**.

The operations and maintenance plans for Coal Pile Runoff Pond and D Basin are currently being prepared by Dynegy Zimmer, LLC.

§ 257.73(c)(1)(xii): Any record or knowledge of structural instability of the CCR unit.

There is no record or knowledge of structural instability of the Coal Pile Runoff Pond and D Basin at Zimmer Power Station.

LIMITATIONS

The signature of AECOM's authorized representative on this document represents that to the best of AECOM's knowledge, information and belief in the exercise of its professional judgment, it is AECOM's professional opinion that the aforementioned information is accurate as of the date of such signature. Any recommendation, opinion or decisions by AECOM are made on the basis of AECOM's experience, qualifications and professional judgment and are not to be construed as warranties or guaranties. In addition, opinions relating to environmental, geologic, and geotechnical conditions or other estimates are based on available data and that actual conditions may vary from those encountered at the times and locations where data are obtained, despite the use of due care.

Sincerely,



Claudia Prado
Project Manager



Victor Modeer, P.E., D.GE
Senior Project Manager

REFERENCES

United States Environmental Protection Agency (USEPA). (2015). *Hazardous and Solid Waste Management System; Disposal of Coal Combustion Residuals from Electric Utilities; Final Rule*. 40 CFR Parts 257 and 261, 80 Fed. Reg. 21302, 21380 April 17, 2015.

United States Geological Survey (USGS). (2016). The National Map Viewer. <http://viewer.nationalmap.gov/viewer/>. USGS data first accessed in March of 2016.


APPENDICES

- Appendix A: History of Construction Vicinity Map
- Appendix B: Zimmer Power Station Drawings
- Appendix C: Zimmer Power Station Boring and Piezometer Location



Appendix A: History of Construction Vicinity Map

AECOM DRAWING PATH: P:\Projects\Geotech\60428794_DyegyCCR\13_Construction\History\04_Technical\Production\6_Zimmer\Reference Documents\Vicinity Location Map References\Figures\C-01_History of Construction Vicinity Map (Zimmer) - MJN.dwg

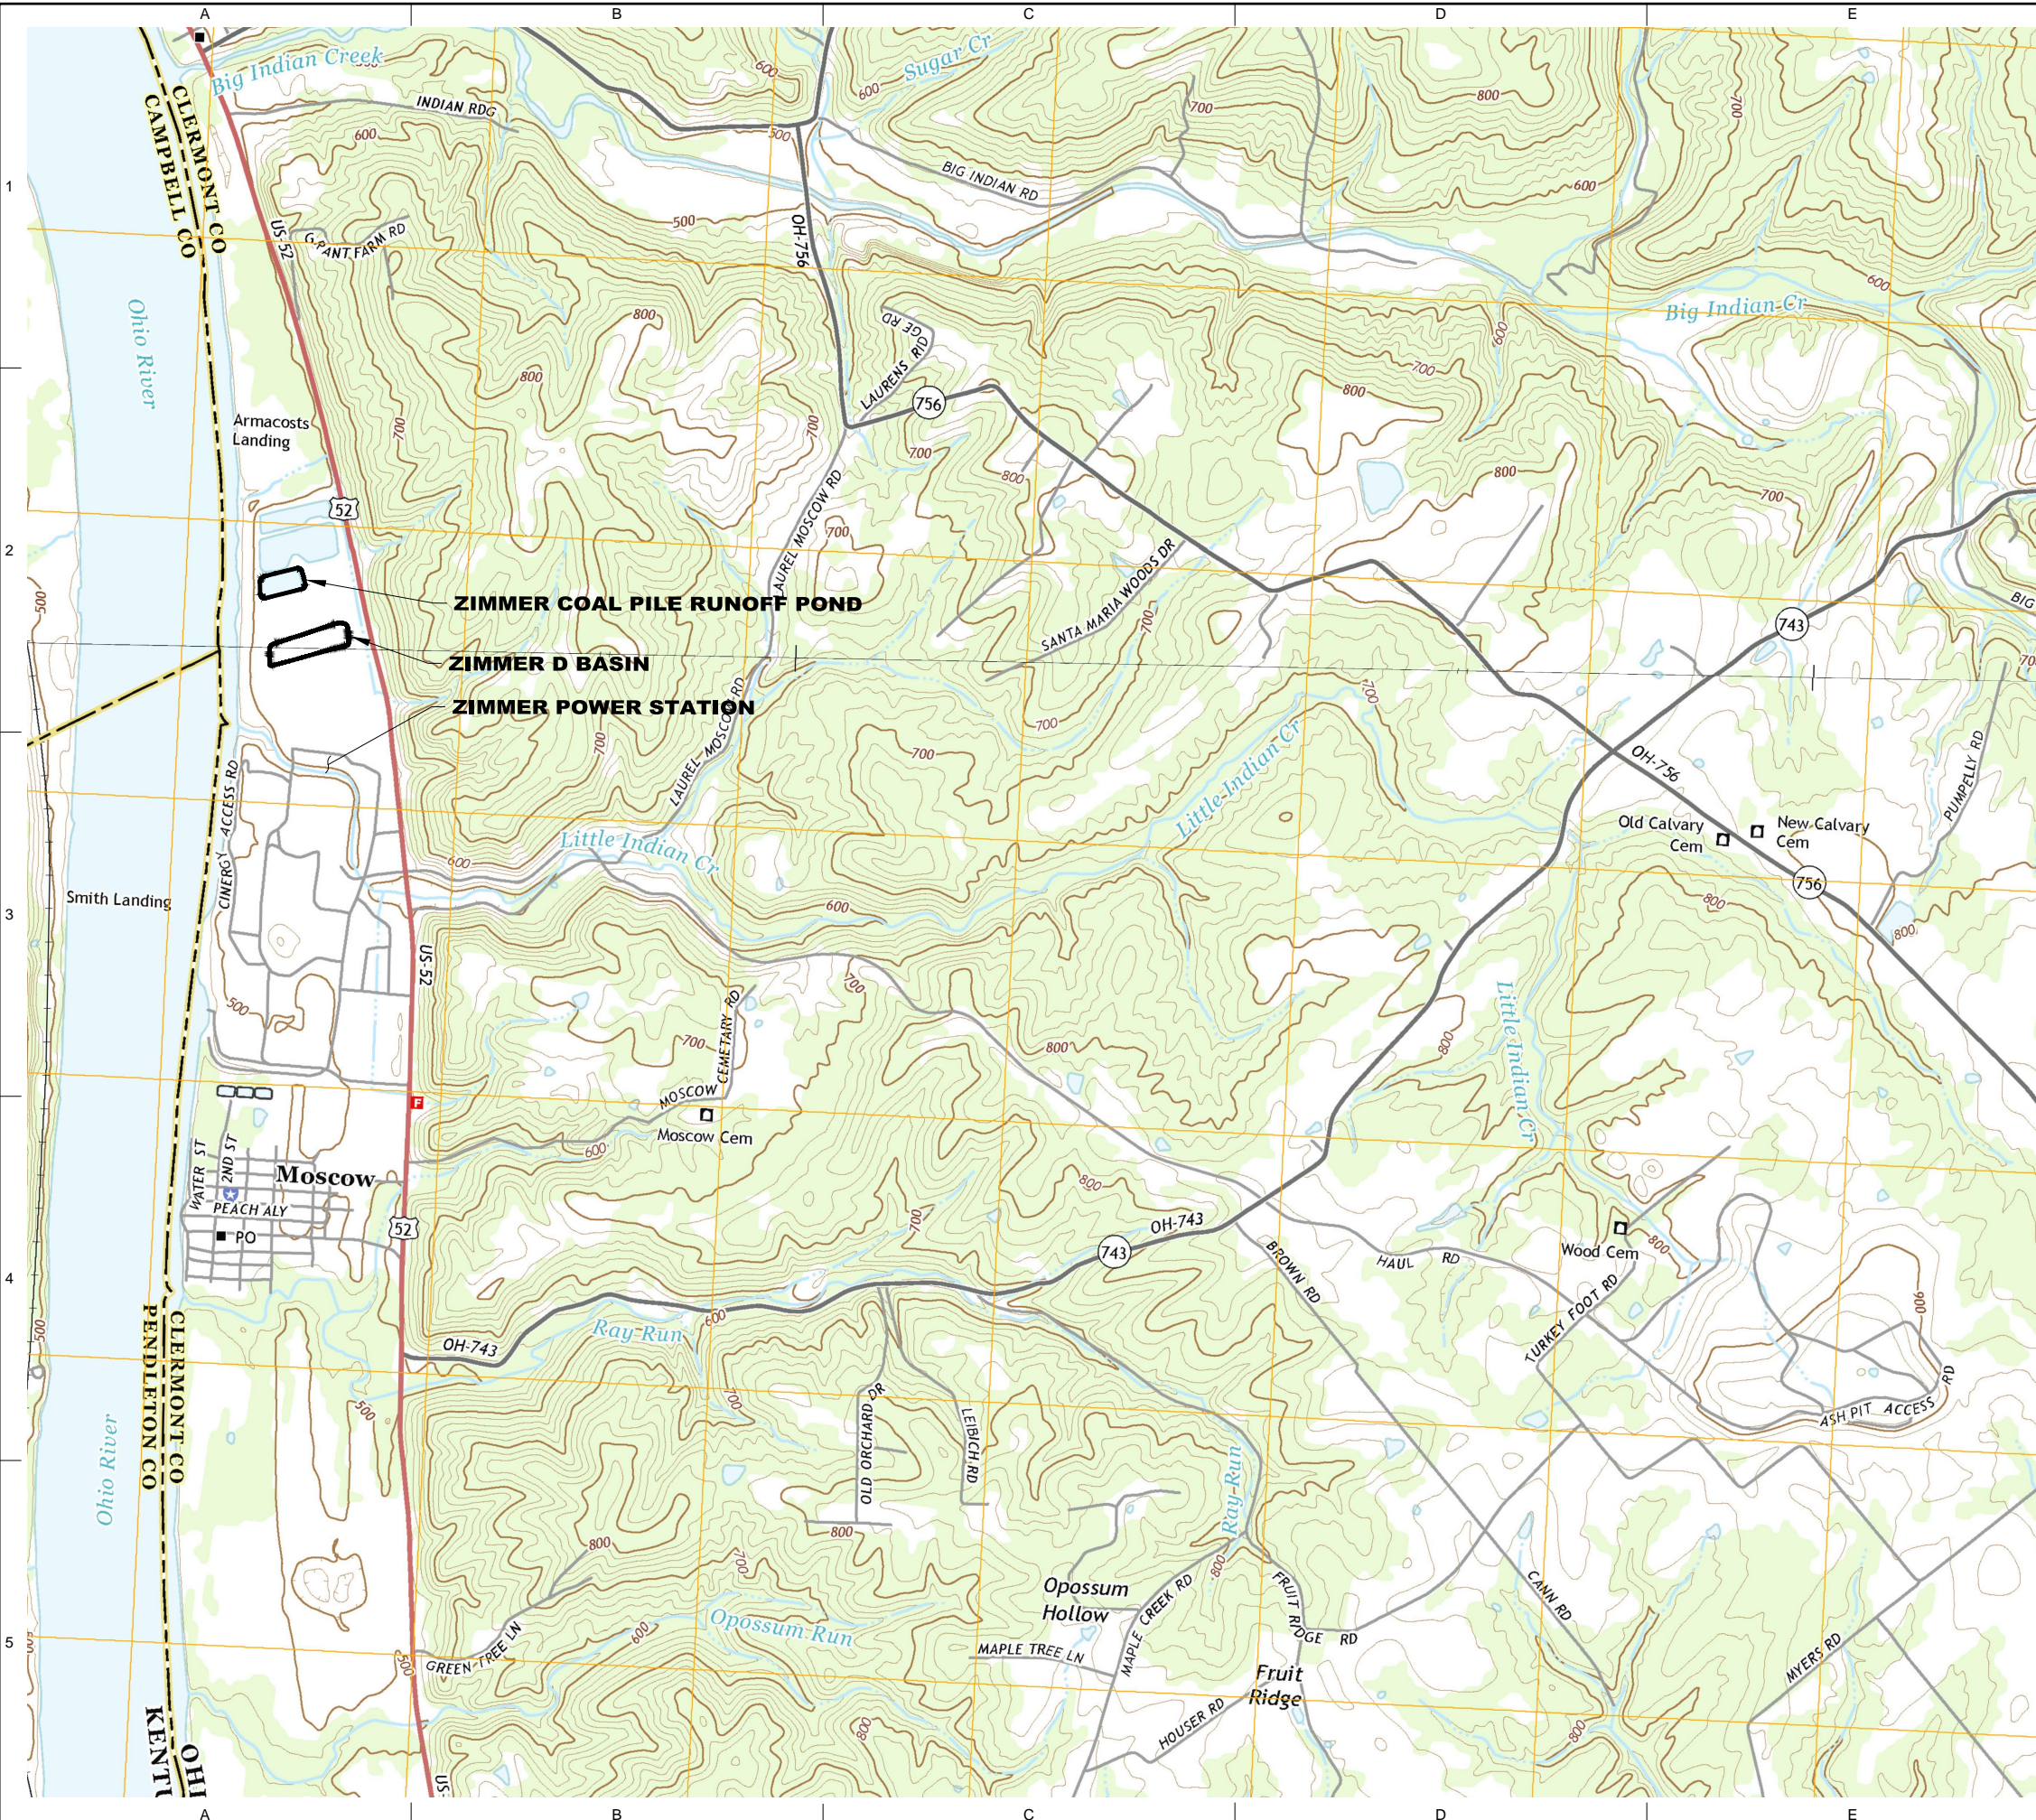


LEGEND
 CCR UNITS

SOURCE:
 MAP PROVIDED FROM ELECTRONIC
 USGS DIGITAL RASTER GRAPHIC 7.5
 MINUTE TOPOGRAPHIC MAP OF
 MOSCOW ILLINOIS AND ZAUREL
 ILLINOIS, REVISED 2015.



QUADRANGLE LOCATION

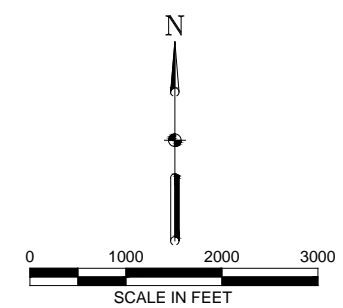

AECOM
 1001 Highlands Plaza Drive, Suite 300
 St. Louis, Mo. 63110
 314 429-0100 (phone)
 314-429-0462 (fax)

Dyegy Zimmer,
 LLC
 1781 US Route 52
 Moscow, OH 45153

**HISTORY OF
 CONSTRUCTION**
 ZIMMER POWER STATION
 MOSCOW, OHIO

ISSUED FOR BIDDING _____ DATE BY _____

ISSUED FOR CONSTRUCTION _____ DATE BY _____

REVISIONS		
NO.	DESCRIPTION	DATE
△		
△		
AECOM PROJECT NO:	60489731
DRAWN BY:	DJD
DESIGNED BY:	DJD
CHECKED BY:	MN
DATE CREATED:	2016-04-13
PLOT DATE:	
SCALE:	1" = 1000'
ACAD VER:	2014



**HISTORY OF
 CONSTRUCTION
 VICINITY MAP**

Appendix B: Zimmer Power Station Drawings

1. "Coal Storage Area and Ponds, Grading and Drainage Plan", Drawing No. 1-30250, Revision 13, 6 March, 1987, American Electric Power Service Corp.
2. "Coal Storage Area and Ponds, Grading and Drainage Sections & Details", Drawing No. 1-30253, Revision 0, 13 March, 1987, American Electric Power Service Corp.
3. "Coal Storage Area and Ponds, Dewatering Basin "D" Plan and Legend", Drawing No. 1-30250B, 27 February, 2003, Orbital Engineering, Inc.
4. "Coal Storage Area and Ponds, Dewatering Basin "D" Section A-A", Drawing No. 1-30250C, 27 February, 2003, Orbital Engineering, Inc.
5. "Coal Storage Area and Ponds, Dewatering Basin "D" Sections B-B & C-C", Drawing No. 1-30250D, 27 February, 2003, Orbital Engineering, Inc.
6. "Coal Storage Area and Ponds, Dewatering Basin "D" Liner and Underdrain Plan", Drawing No. 1-30250E, 27 February, 2003, Orbital Engineering, Inc.
7. "Coal Storage Area and Ponds, Dewatering Basin "D" Misc. Sections & Details", Drawing No. 1-30250F, 27 February, 2003, Orbital Engineering, Inc.
8. "Coal Storage Area and Ponds, Dewatering Basin "D" G.A. of Pump Pit", Drawing No. 1-30250G, 27 February, 2003, Orbital Engineering, Inc.
9. "Coal Storage Area and Ponds, Dewatering Basin "D" General Notes", Drawing No. 1-30250H, 27 February, 2003, Orbital Engineering, Inc.
10. "Coal Storage Area and Ponds, Dewatering Basin "D" Pump Pit Piping - Plan", Drawing No. 1-5434-01, 20 February, 2003, Orbital Engineering, Inc.
11. "Coal Storage Area and Ponds, Dewatering Basin "D" Piping Sect. A-A & Det.", Drawing No. 1-5434-02, 20 February, 2003, Orbital Engineering, Inc.
12. "Coal Storage Area and Ponds, Dewatering Basin "D" Pump Pit – Misc. Details", Drawing No. 1-5434-03, 20 February, 2003, Orbital Engineering, Inc.

- LEGEND - EXISTING**
- SPOT ELEVATION
 - INTERMEDIATE CONTOUR
 - INDEX CONTOUR
 - DEPRESSION CONTOUR
 - TREES AND TREELINE
 - STRUCTURE AND BUILDING
 - FENCE
 - POLE
 - IMPROVED ROAD
 - UNIMPROVED ROAD
 - NORMAL POOL (EL. 455.0)
 - PLANT PROPERTY LINE
 - R.O.W. LINE
 - STATE BOUNDARY OH.- KY.
 - SOUNDING - DEPTH FROM N.P.
 - ARCHAEOLOGICAL SITE BOUNDARY

- LEGEND - PROPOSED**
- SPOT ELEVATION
 - INTERMEDIATE CONTOUR
 - INDEX CONTOUR
 - BUILDING
 - DRAINAGE STRUCTURE NUMBER
 - PIPE SIZE & FLOW DIRECTION
 - GEGRID MATERIAL
 - GRAVEL AREA

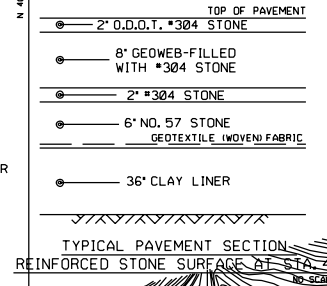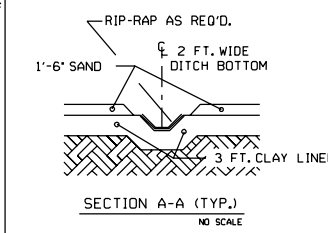

- NOTES:**
- STATE BOUNDARY COORDINATE POINTS 3319THRU 3325 ARE DERIVED FROM JOINT EXHIBIT OF 30 OHIO vs. KENTUCKY SUPREME COURT CASE, (STATE PLANE COORDINATE SYSTEM OHIO SOUTH ZONE.)
 - PLANT PROPERTY LINES PLOTTED FROM C.G. & E. PROPERTY PLAT 51000-55. COORDINATES ARE REFERENCED TO OHIO GRID NORTH.
 - CONTOUR INTERVAL 2'
 - 6" OF CRUSHED STONE-ODOT ITEM NO.304 TO BE PLACED IN YARD AREAS WHERE PROPOSED COAL HANDLING STRUCTURES, INCLUDING STATIONS AND SERVICE FACILITIES ARE TO BE LOCATED
 - TOE DRAIN (DWG 1-30252) SHALL BE PLACED ALONG THE EXTERIOR OF THE CLEAR WATER POND, WASTE WATER POND AND COAL PILE RUNOFF POND WHEN THE TOP OF THE EXTERIOR EMBANKMENT EXCEEDS EXISTING GRADE BY AT LEAST 10 FT.
 - DISCHARGE PIPE FROM COAL PILE RUNOFF POND AND THE CLEAR WATER POND WILL REQUIRE SEEPAGE COLLARS. SEEPAGE COLLARS ARE NOT REQUIRED ON EMERGENCY OVERFLOW PIPES FROM COAL PILE RUNOFF SETTLING PONDS A, B & C.


COMPUTER DRAWING
MANUAL CHANGES
NOT PERMITTED

SEE CINERGY REVISIONS

NO.	DATE	REVISION	BY
11		REVISOR DRAWING TO "AS-BUILT" STATUS AS PER FIELD INFORMATION.	
10	JULY 16 1994	AS PER ROR-ZR-01-0722. ADDED REINFORCED STONE SURFACE AT THE SOUTH END OF CON. STA. 4W AND DITCHING WITH 24" DIA. PIPE (L-6L SECTION 4-A) & TYPICAL PAVEMENT SECTION (H-1) AS PER "AS-BUILT" INFORMATION.	WPM
9	APR. 12 1990	AS PER ROR-ZR-01-0764. ADDED 270 GAL. PUMP WITH SECONDARY CONTAINMENT TO TRACTOR WASHDOWN FACILITY (4-W), REFER TO MECH. DWG. 1-5411-04 ENLARGED PLAN VIEW (2-D).	
8	OCT. 8 1989	AS PER ROR-ZR-01-0666. SETTLING BASIN 70' X 8' X 2' ADDED CONC. SLABS, ACCESS ROADS, AND RELOCATED STRUCTURES AS PER AS-BUILTS. REVISED GRADING AROUND SUMP STRUCTURES WITH A 2' TO 3H BASIN SIDESLOPE TRANSITION.	
7		PER ROR-ZR-01-0433, ADDED BARGE DEMATERING PIPE SYSTEM, REV. CONTROLS & ADDED RIPRAP AT COAL PILE RUNOFF SETTLING BASIN 57' X 17' X 1' (7-K).	
6		REV. DIM. TO 34'-18" WAS 31'-2" NEAR 1-BARGE (7-3) AT SUBSTATION NEAR CLEAR WATER POND (7-C) ADDED BLOCK WAS PER ROR ZR-01-202 AND CHANGED CONTOURS ACCORDING TO 1-D. REV. 24" ST. PIPE TO 20" POLY. PIPE BY FIELD. (6-E) CHANGED STEEL PIPE TO POLY. PIPE AS PER C.E. (8-A & 9-D) CHANGED DWG. NO. IN SECT. MARKERS TO 1-30253 AND 1-30254.	
5		AS PER ROR ZR-01-2111, CHANGED CMP TO POLYETHYLENE PIPE & CHANGED SIZE TO 32" W/AS 30" (8-E) AS PER ROR ZR-01-2111, REMOVED ARCHAEOLOGICAL SITES #307 #477 AND PART OF #476, CHANGED CONFIGURATION AND REMOVED AREA AROUND ARCHAEOLOGICAL SITE IN WASTE WATER POND.	
4		ADDED GRAVEL TO COAL HANDLING REVISED DIMENSIONS FROM CENTERLINE OF PIPE SYSTEMS AND FROM SETTLING BASIN 57' X 17' TO CENTERLINE PUMP STRUCTURE AT SETTLING BASIN 57' X 17' (8-B).	
3		ADDED GEGRID MATERIAL AND REVISED GRADING ALONG LITTLE MEAN DIVERSION CREEK (8-A-1). SELECTED SUB-STA. SOUTH OF WASTE TREATMENT BASIN AND REVISED GRADING WITHIN. F-7, LOCATED SETTLING POND TO WASTE WATER POND E.S.	
2		REMOVED HOLD AND REVISED GRADING AT N. SIDE OF RECLAIM WATER PUMP HOUSE (6-F). ADDED REEL WALL (C-6-7). ADDED SODIUM HYDROX. TANK (E-2).	
1		PLACED HOLD ON PROFILES AT N. SIDE OF RECLAIM WAT. PUMPHOUSE (C-7) REVISED GRADING AT STA. 4W. L-E SHIFTED GRID SYS. 18' TO THE NORTH.	
0		GENERAL REVISION REFLECTING CURRENT DESIGN DESCRIPTION AND LOCATION OF CONTOURS, ELEVATIONS, CATCHBASINS, MANHOLES, AND PIPES AS PER ROR-ZR-01-0666. REVISED GRADING ON NORTH & EAST SIDE OF TRANSFER STATION 102.5, 10-B.	
		RELEASED FOR CONSTRUCTION	

MATCH LINE N 3.550.

MATCH LINE N 3.550.

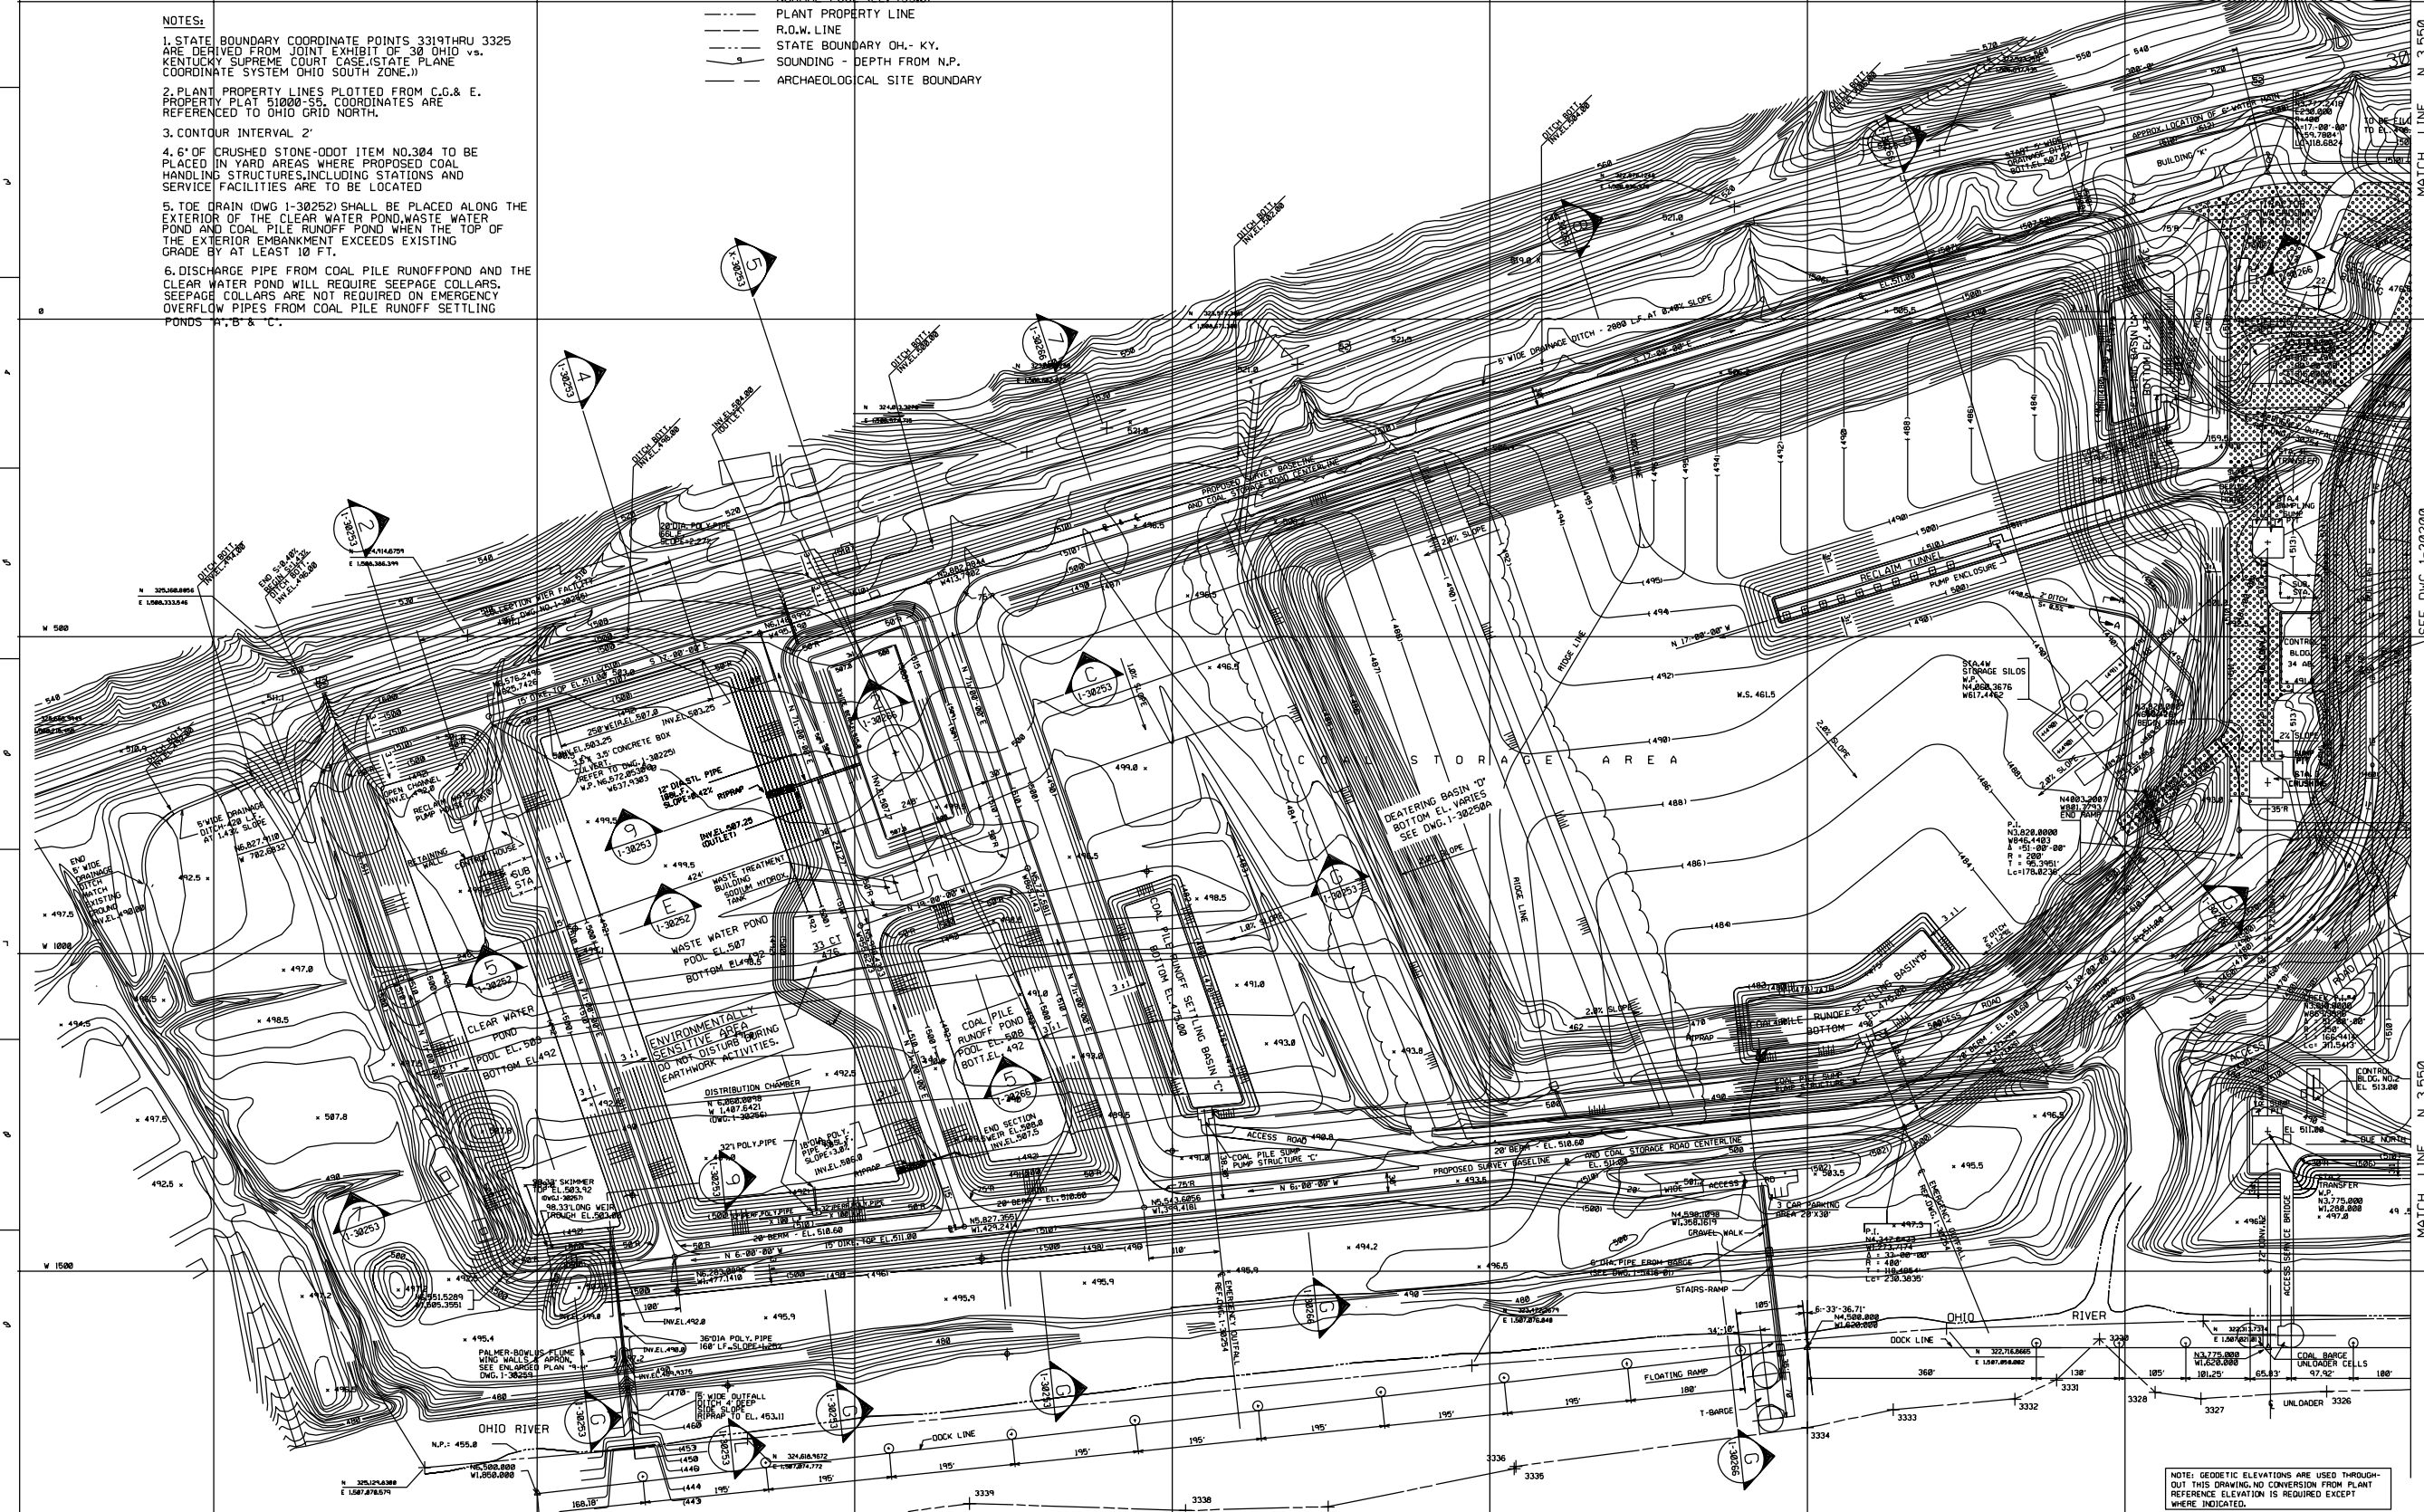







NOTE: GEODETIC ELEVATIONS ARE USED THROUGHOUT THIS DRAWING. NO CONVERSION FROM PLANT REFERENCE ELEVATION IS REQUIRED EXCEPT WHERE INDICATED.

COAL STORAGE AREA AND PONDS GRADING AND DRAINAGE PLAN

DWG. NO. 1-30250

NO.	DATE	REVISION	BY
1		GENERAL REVISION REFLECTING CURRENT DESIGN DESCRIPTION AND LOCATION OF CONTOURS, ELEVATIONS, CATCHBASINS, MANHOLES, AND PIPES AS PER ROR-ZR-01-0666. REVISED GRADING ON NORTH & EAST SIDE OF TRANSFER STATION 102.5, 10-B.	
2		REMOVED HOLD AND REVISED GRADING AT N. SIDE OF RECLAIM WATER PUMP HOUSE (6-F). ADDED REEL WALL (C-6-7). ADDED SODIUM HYDROX. TANK (E-2).	
3		ADDED GEGRID MATERIAL AND REVISED GRADING ALONG LITTLE MEAN DIVERSION CREEK (8-A-1). SELECTED SUB-STA. SOUTH OF WASTE TREATMENT BASIN AND REVISED GRADING WITHIN. F-7, LOCATED SETTLING POND TO WASTE WATER POND E.S.	
4		ADDED GRAVEL TO COAL HANDLING REVISED DIMENSIONS FROM CENTERLINE OF PIPE SYSTEMS AND FROM SETTLING BASIN 57' X 17' TO CENTERLINE PUMP STRUCTURE AT SETTLING BASIN 57' X 17' (8-B).	
5		AS PER ROR ZR-01-2111, CHANGED CMP TO POLYETHYLENE PIPE & CHANGED SIZE TO 32" W/AS 30" (8-E) AS PER ROR ZR-01-2111, REMOVED ARCHAEOLOGICAL SITES #307 #477 AND PART OF #476, CHANGED CONFIGURATION AND REMOVED AREA AROUND ARCHAEOLOGICAL SITE IN WASTE WATER POND.	
6		REV. DIM. TO 34'-18" WAS 31'-2" NEAR 1-BARGE (7-3) AT SUBSTATION NEAR CLEAR WATER POND (7-C) ADDED BLOCK WAS PER ROR ZR-01-202 AND CHANGED CONTOURS ACCORDING TO 1-D. REV. 24" ST. PIPE TO 20" POLY. PIPE BY FIELD. (6-E) CHANGED STEEL PIPE TO POLY. PIPE AS PER C.E. (8-A & 9-D) CHANGED DWG. NO. IN SECT. MARKERS TO 1-30253 AND 1-30254.	
7		PER ROR-ZR-01-0433, ADDED BARGE DEMATERING PIPE SYSTEM, REV. CONTROLS & ADDED RIPRAP AT COAL PILE RUNOFF SETTLING BASIN 57' X 17' X 1' (7-K).	
8	OCT. 8 1989	AS PER ROR-ZR-01-0666. SETTLING BASIN 70' X 8' X 2' ADDED CONC. SLABS, ACCESS ROADS, AND RELOCATED STRUCTURES AS PER AS-BUILTS. REVISED GRADING AROUND SUMP STRUCTURES WITH A 2' TO 3H BASIN SIDESLOPE TRANSITION.	
9	APR. 12 1990	AS PER ROR-ZR-01-0764. ADDED 270 GAL. PUMP WITH SECONDARY CONTAINMENT TO TRACTOR WASHDOWN FACILITY (4-W), REFER TO MECH. DWG. 1-5411-04 ENLARGED PLAN VIEW (2-D).	
10	JULY 16 1994	AS PER ROR-ZR-01-0722. ADDED REINFORCED STONE SURFACE AT THE SOUTH END OF CON. STA. 4W AND DITCHING WITH 24" DIA. PIPE (L-6L SECTION 4-A) & TYPICAL PAVEMENT SECTION (H-1) AS PER "AS-BUILT" INFORMATION.	WPM
11		REVISOR DRAWING TO "AS-BUILT" STATUS AS PER FIELD INFORMATION.	

1. WORK THIS DRAWING WITH DWG. 1-30250.

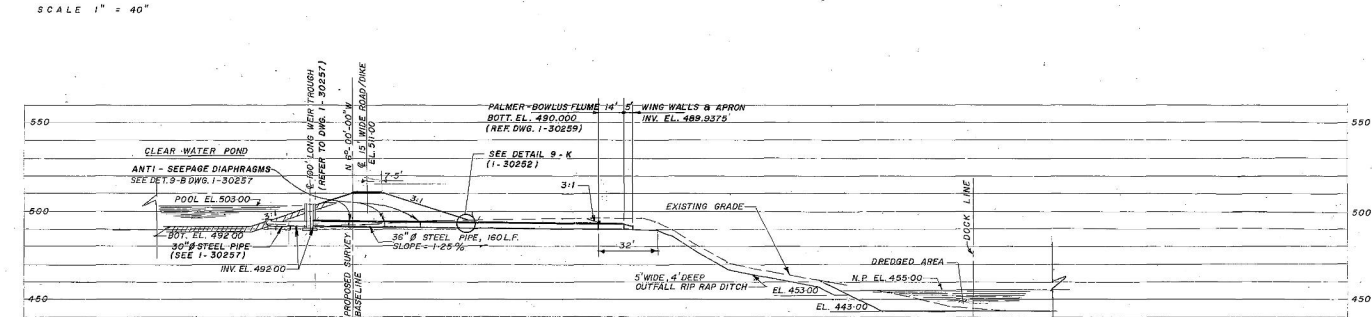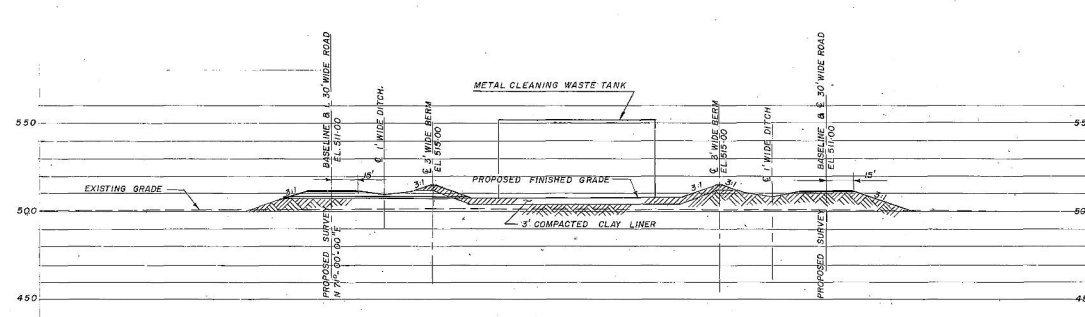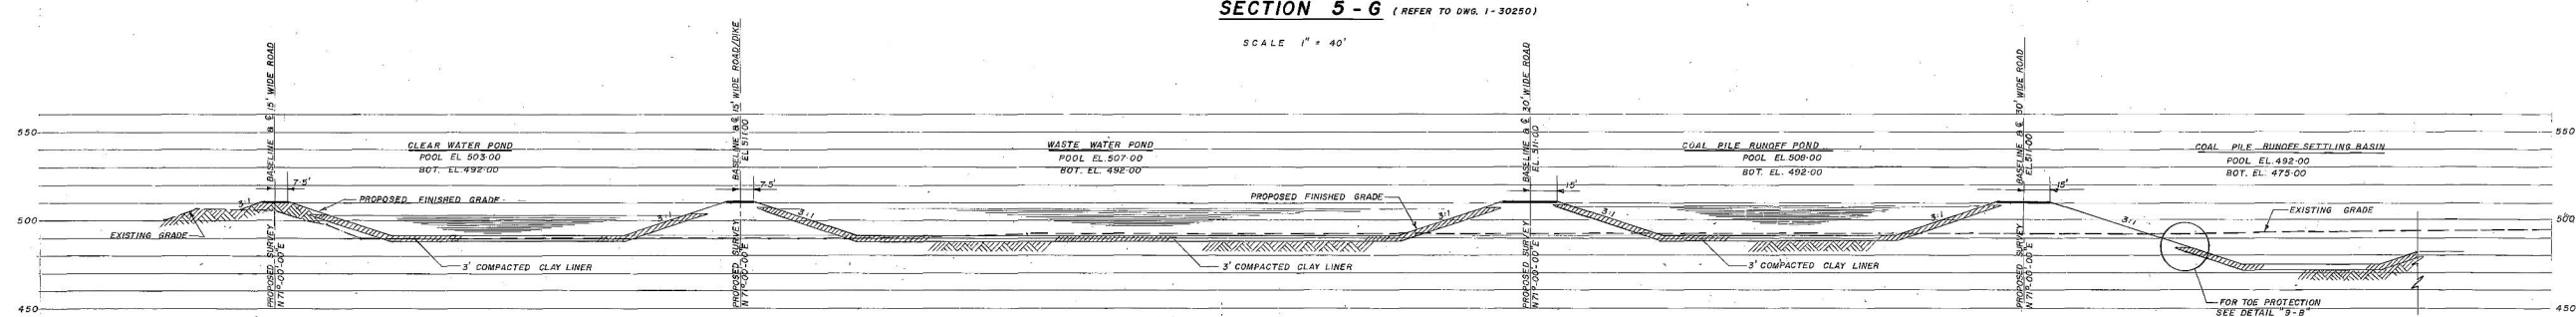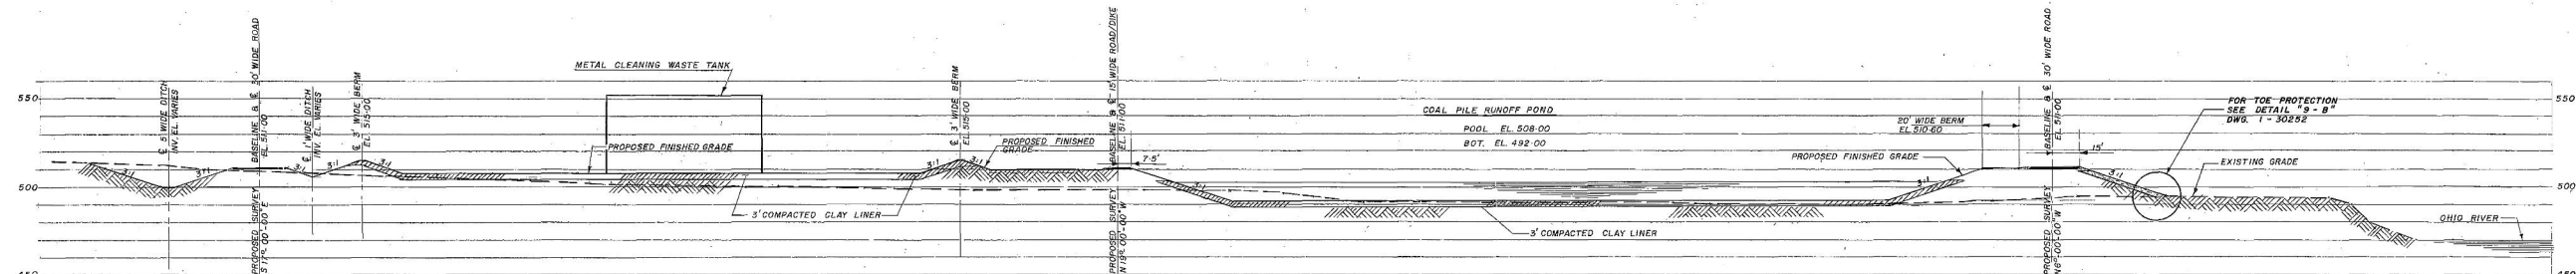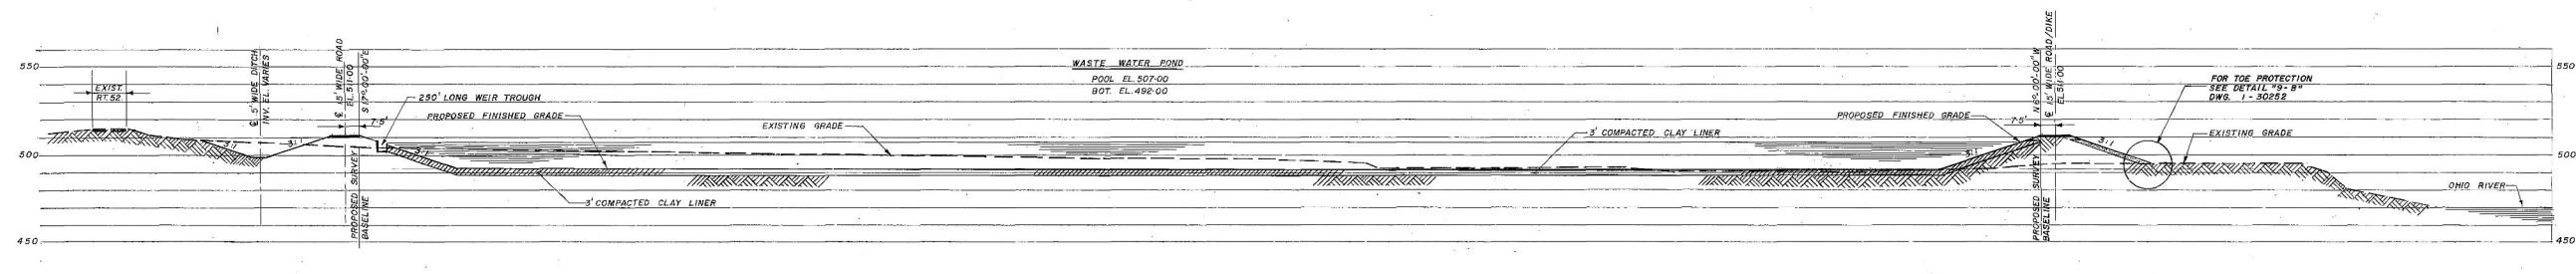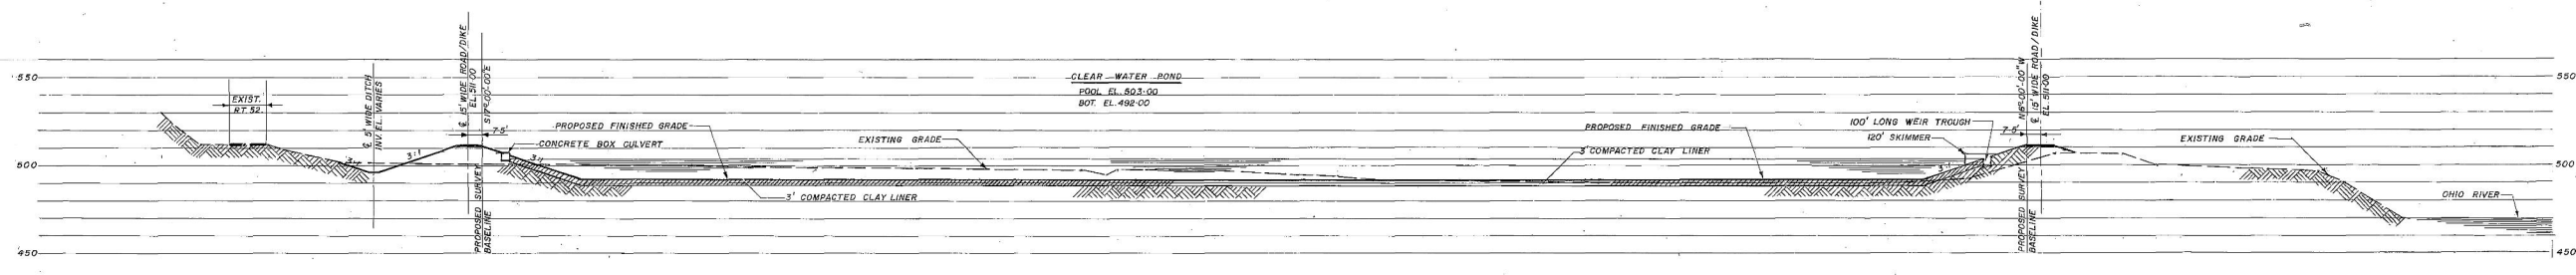

RELEASED FOR CONSTRUCTION

DATE	NO.	DESCRIPTION	APPD.

REVISIONS

THIS DRAWING IS PREPARED IN CONNECTION WITH THE CONVERSION PROJECT DESCRIBED IN THE PROJECT MANAGEMENT AGREEMENT BETWEEN THE OWNERS AND AMERICAN ELECTRIC POWER SERVICE CORPORATION (AEPSC), 22-2-2-26, AND IS SUBJECT TO ALL APPLICABLE TERMS AND CONDITIONS OF THAT AGREEMENT.

PROPRIETARY NOTICE

THIS DRAWING IS THE PROPERTY OF THE OWNERS AND AEPSC, AND IS LOANED UPON CONDITION THAT IT IS NOT TO BE REPRODUCED OR COPIED, IN WHOLE OR IN PART, OR USED FOR FURNISHING INFORMATION TO ANY PERSON WITHOUT THE WRITTEN CONSENT OF AN OWNER, OR AEPSC, OR USED FOR ANY PURPOSE DETRIMENTAL TO THEIR INTEREST, AND IS TO BE RETURNED UPON REQUEST.

WM. H. ZIMMER GENERATING STATION
THE CINCINNATI GAS & ELECTRIC CO.
THE DAYTON POWER AND LIGHT CO.
COLUMBUS AND SOUTHERN OHIO ELECTRIC CO. OWNERS

COAL STORAGE AREA AND PONDS GRADING AND DRAINAGE SECTIONS & DETAILS

DWG. NO. 1-30253

ARCH.	ELEC.	MECH.	STR.	TS
SCALE: 1" = 40'	ENGINEERING DIVISION			
DR. S.L.P.	D.H. Beatty			
CH. R.H.S.	DESIGN DIVISION			
SO. LDR. R.H.S.	DATE: 3-1-77			


1 RIVERSIDE PLAZA ASSOCIATES, INC.
FOR AMERICAN ELECTRIC POWER SERVICE CORP.

SCANNED DWG. DO NOT REVISE

NO FIELD SURVEY ELEVATIONS ARE USED THROUGHOUT THIS DRAWING. NO CONVERSION FROM PLANT REFERENCE ELEVATION IS REQUIRED EXCEPT WHERE INDICATED.



1-30250B




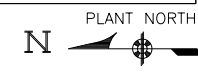


REFERENCE DRAWINGS

- 1-30104 COAL STORAGE AREA AND PONDS-ROAD PAVING PLAN
- 1-30250 GRADING & DRAINAGE-PLAN
- 1-30253 GRADING & DRAINAGE SECTIONS & DETAILS
- 1-30254 RUNOFF SETTLING BASINS PLAN & SECTIONS
- 1-30266 COAL YARD SECTIONS

LEGEND

- EXISTING ASPHALT ROADWAY
- ORIGINAL COAL STORAGE AREA SURFACE CONTOUR
- ORIGINAL COAL STORAGE AREA SPOT ELEVATION
- PROPOSED FINAL GRADE INDEX CONTOUR
- PROPOSED FINAL GRADE INTERMEDATE CONTOUR
- PROPOSED FINAL GRADE SPOT ELEVATION
- PROPOSED SLOPE INDICATOR
- FUTURE POND "E" SLOPE INDICATOR
- NEW UNDERGROUND PIPES
- NEW UNDERDRAIN CLEANOUTS

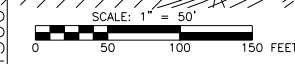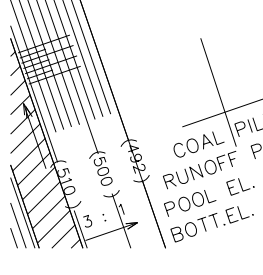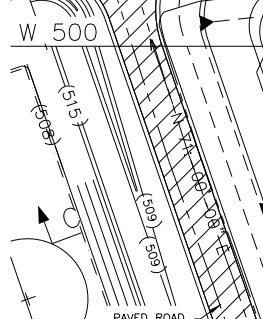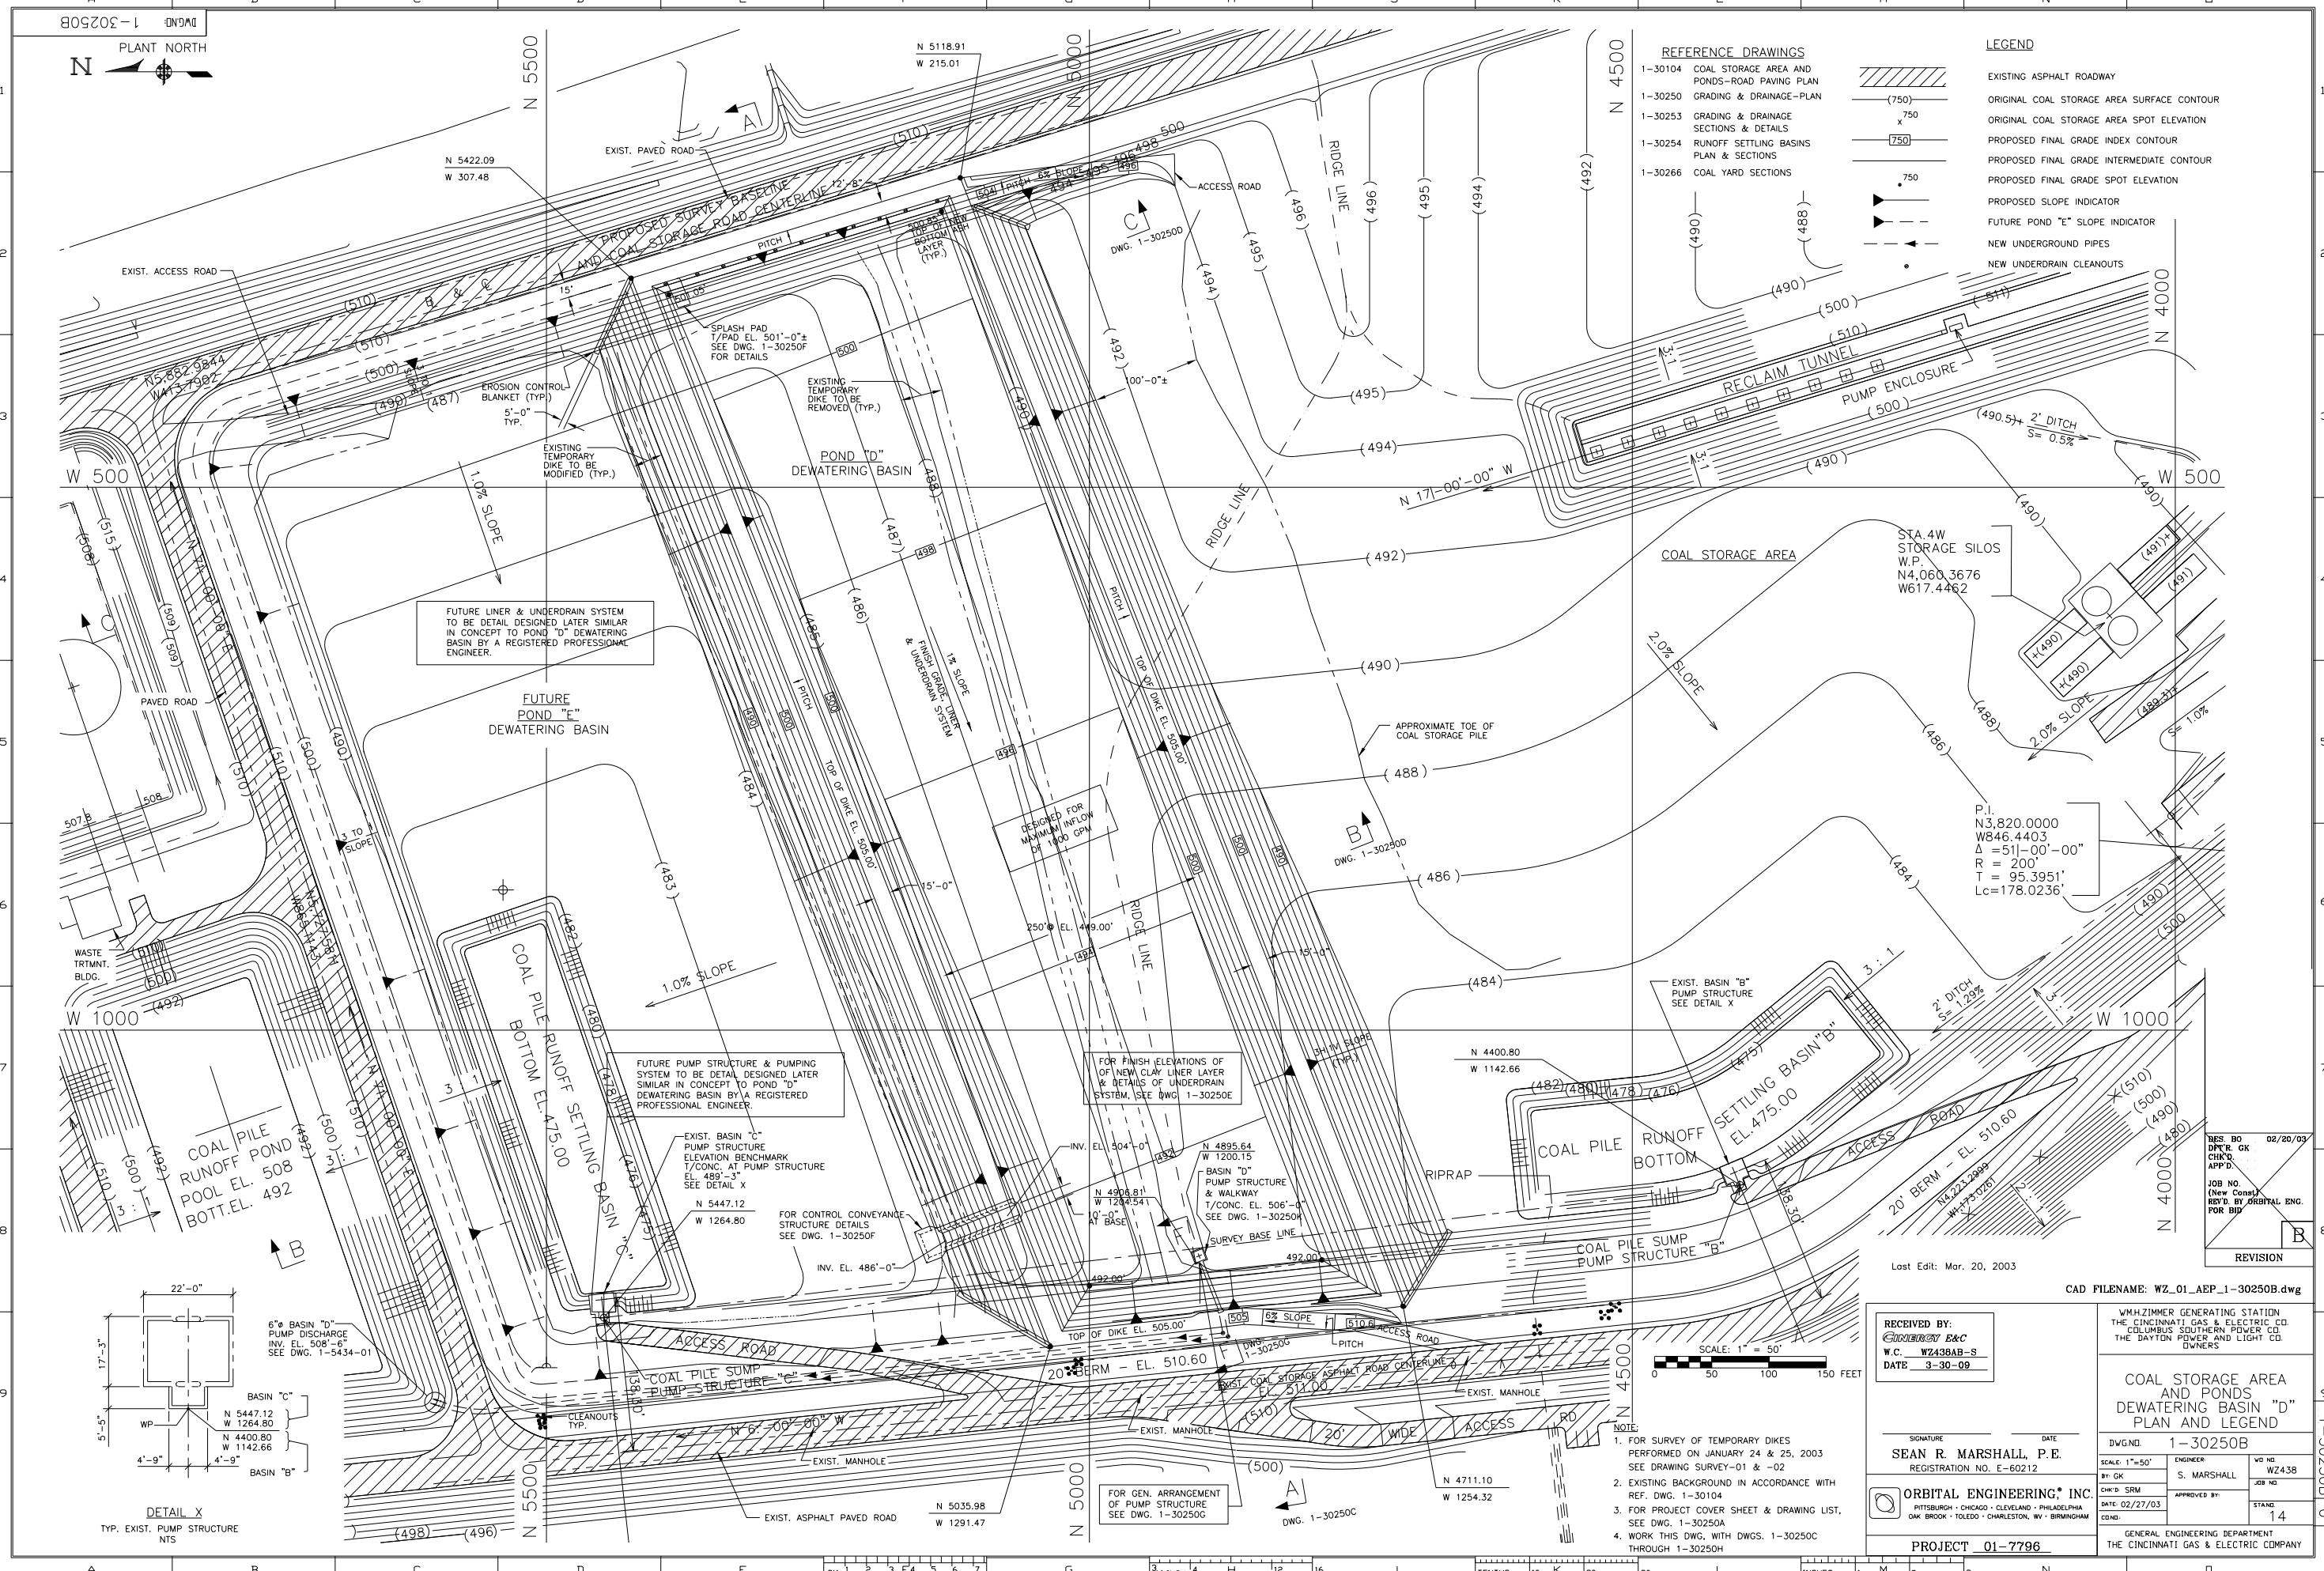

- NOTE:
- FOR SURVEY OF TEMPORARY DIKES PERFORMED ON JANUARY 24 & 25, 2003 SEE DRAWING SURVEY-01 & -02
 - EXISTING BACKGROUND IN ACCORDANCE WITH REF. DWG. 1-30104
 - FOR PROJECT COVER SHEET & DRAWING LIST, SEE DWG. 1-30250A
 - WORK THIS DWG. WITH DWGS. 1-30250C THROUGH 1-30250H

RECEIVED BY:
GUMBERY & C
 W.C. WZ438AB-S
 DATE: 3-30-09

SIGNATURE: **SEAN R. MARSHALL, P.E.**
 REGISTRATION NO. E-60212

ORBITAL ENGINEERING, INC.
 PITTSBURGH · CHICAGO · CLEVELAND · PHILADELPHIA
 OAK BROOK · TOLEDO · CHARLESTON, WV · BIRMINGHAM

PROJECT **01-7796**

WMH/ZIMMER GENERATING STATION
 THE CINCINNATI GAS & ELECTRIC CO.
 COLUMBUS SOUTHERN POWER CO.
 THE DAYTON POWER AND LIGHT CO.
 OWNERS

COAL STORAGE AREA AND PONDS DEWATERING BASIN "D" PLAN AND LEGEND

DWG NO: 1-30250B
 SCALE: 1"=50'
 BY: GK
 CHK'D: SRM
 DATE: 02/27/03
 COND:

ENGINEER: S. MARSHALL
 VO NO: WZ438
 JOB NO:
 APPROVED BY:
 STAND: 14


GENERAL ENGINEERING DEPARTMENT
 THE CINCINNATI GAS & ELECTRIC COMPANY

REV	DATE	DESCRIPTION
B	02/20/03	DES. BY ORBITAL ENG. FOR BID

Last Edit: Mar. 20, 2003

CAD FILENAME: WZ_01_AEP_1-30250B.dwg

1-30250C

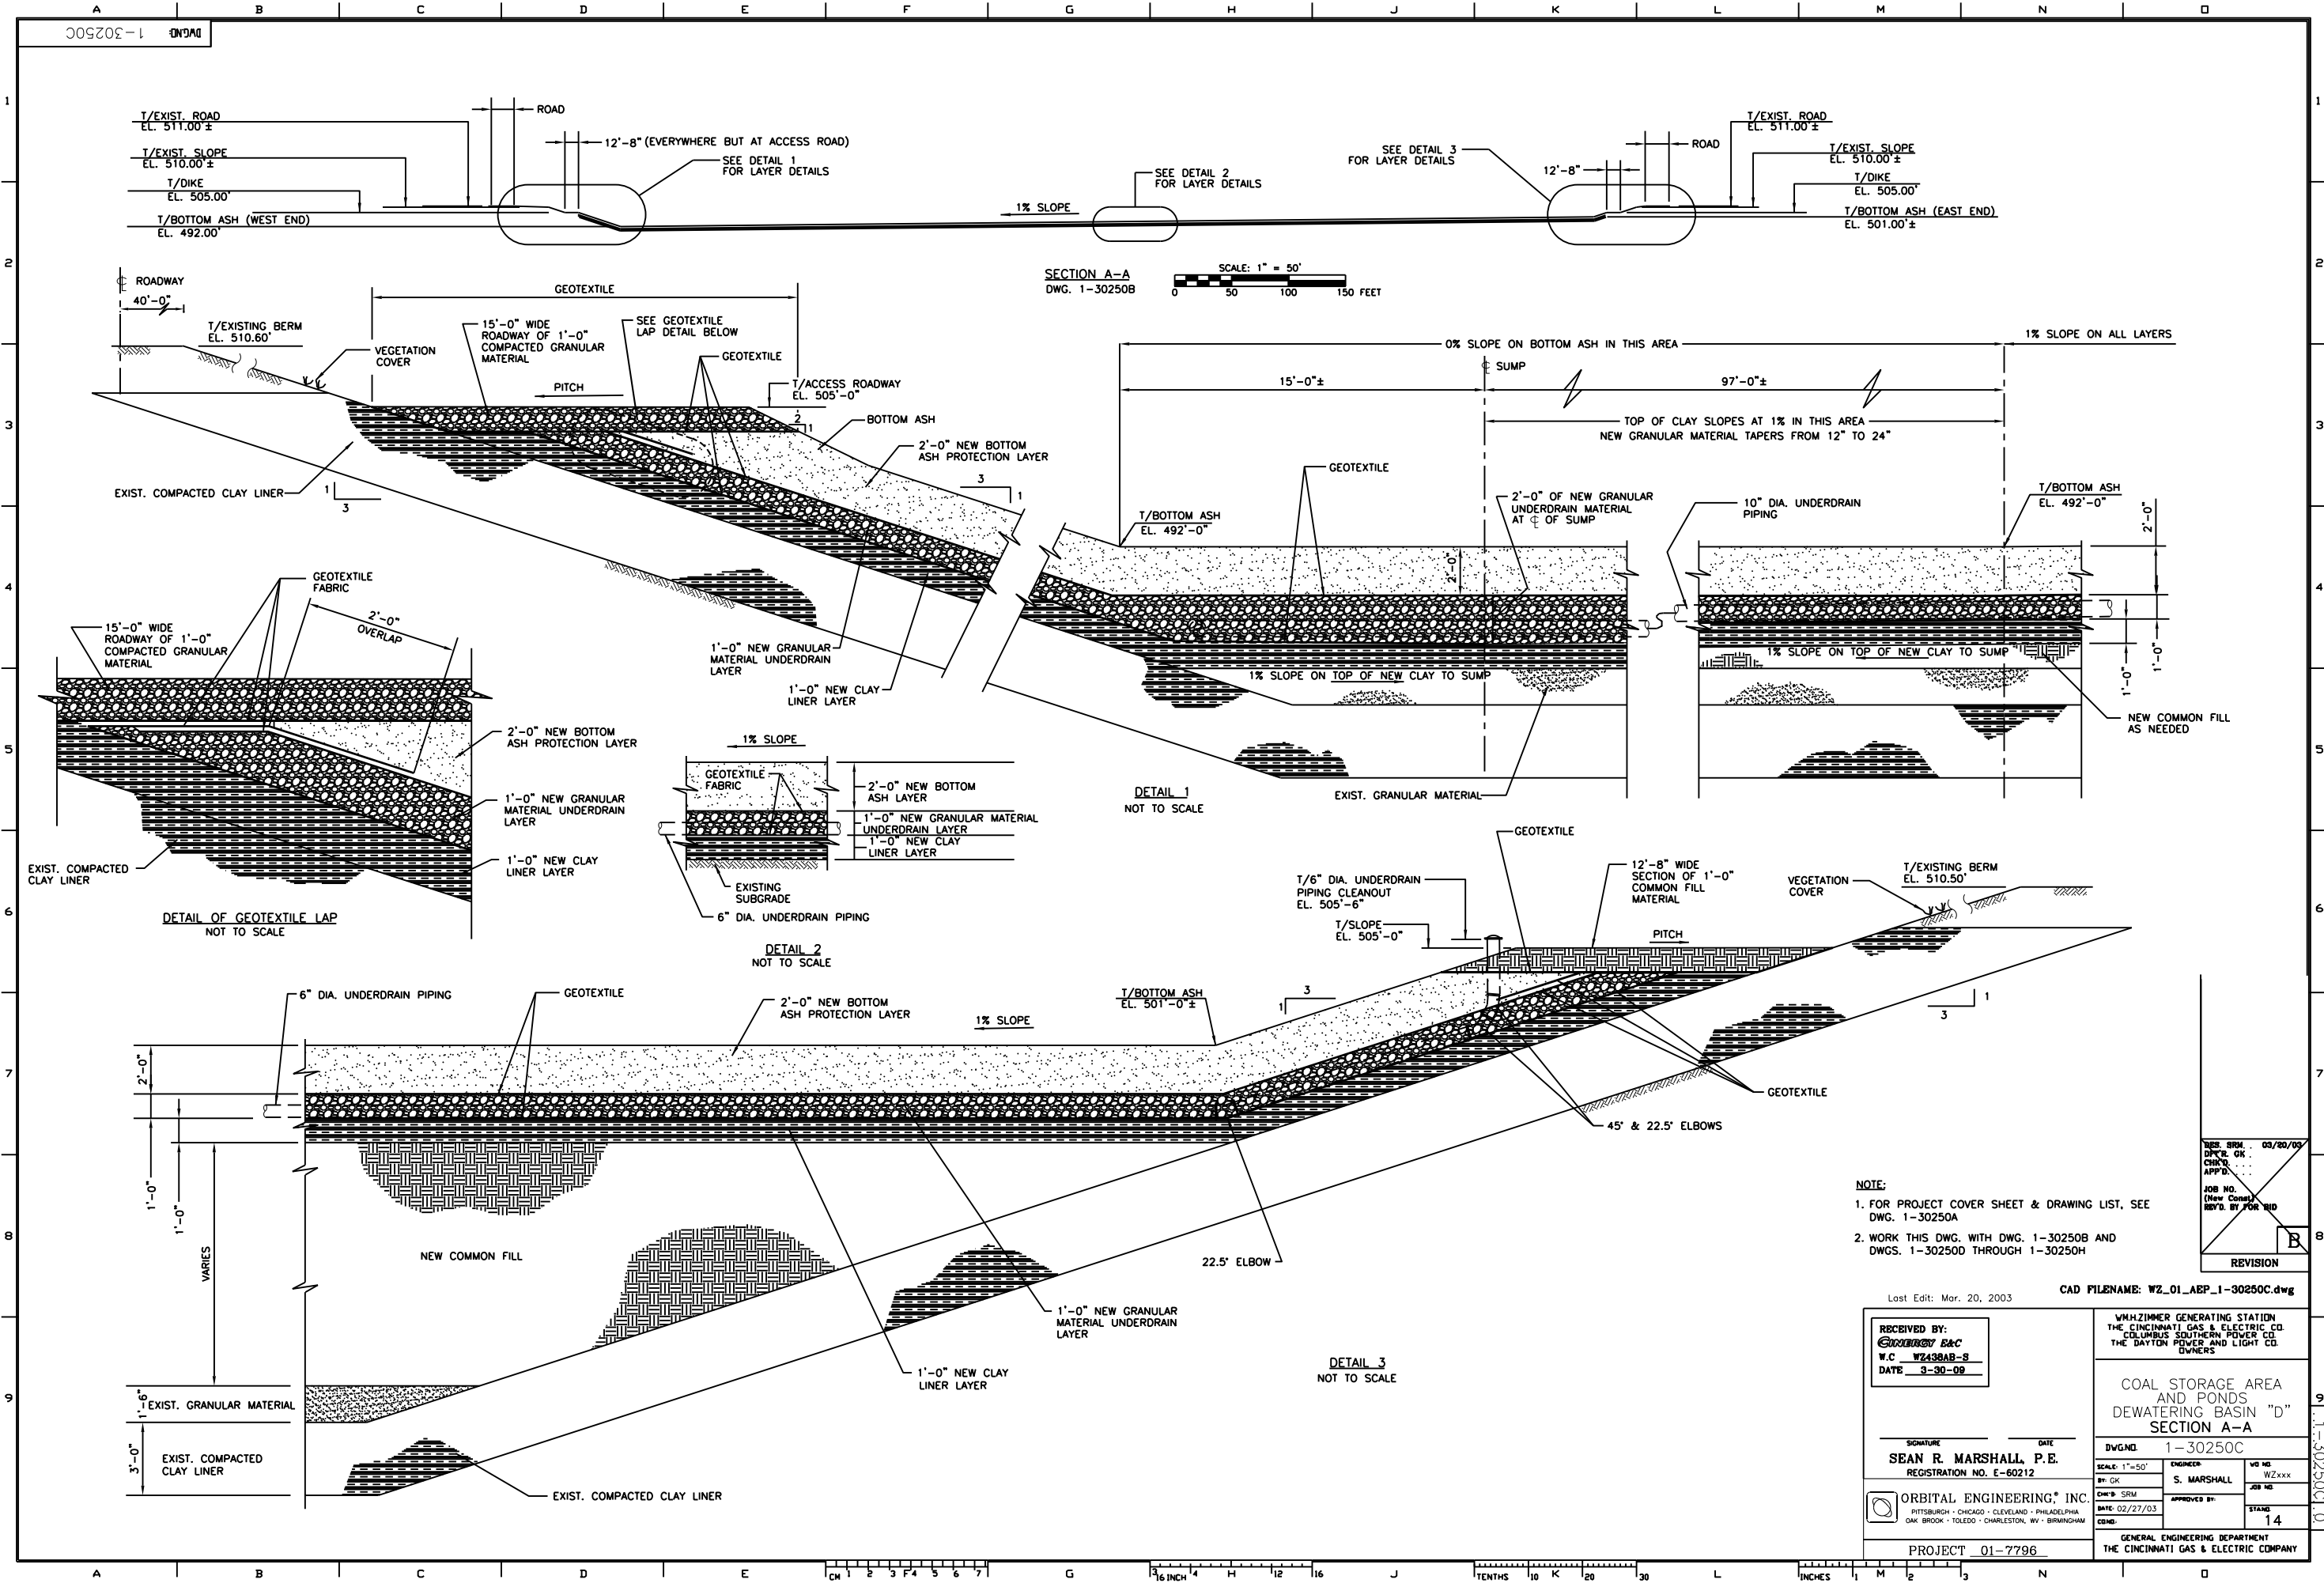

SECTION A-A
DWG. 1-30250B
SCALE: 1" = 50'
0 50 100 150 FEET

T/EXIST. ROAD EL. 511.00 ±
T/EXIST. SLOPE EL. 510.00 ±
T/DIKE EL. 505.00'
T/BOTTOM ASH (WEST END) EL. 492.00'

12'-8" (EVERYWHERE BUT AT ACCESS ROAD)
SEE DETAIL 1 FOR LAYER DETAILS

1% SLOPE

SEE DETAIL 2 FOR LAYER DETAILS

SEE DETAIL 3 FOR LAYER DETAILS

T/EXIST. ROAD EL. 511.00 ±
T/EXIST. SLOPE EL. 510.00 ±
T/DIKE EL. 505.00'
T/BOTTOM ASH (EAST END) EL. 501.00 ±

ROADWAY 40'-0"

T/EXISTING BERM EL. 510.60'

VEGETATION COVER

15'-0" WIDE ROADWAY OF 1'-0" COMPACTED GRANULAR MATERIAL

PITCH

GEOTEXTILE

SEE GEOTEXTILE LAP DETAIL BELOW

T/ACCESS ROADWAY EL. 505'-0"

BOTTOM ASH

2'-0" NEW BOTTOM ASH PROTECTION LAYER

EXIST. COMPACTED CLAY LINER

0% SLOPE ON BOTTOM ASH IN THIS AREA

15'-0" ±

SUMP

97'-0" ±

TOP OF CLAY SLOPES AT 1% IN THIS AREA
NEW GRANULAR MATERIAL TAPERS FROM 12" TO 24"

2'-0" OF NEW GRANULAR UNDERDRAIN MATERIAL AT C OF SUMP

10" DIA. UNDERDRAIN PIPING

T/BOTTOM ASH EL. 492'-0"

2'-0"

1% SLOPE ON TOP OF NEW CLAY TO SUMP

EXIST. GRANULAR MATERIAL

1'-0" NEW GRANULAR MATERIAL UNDERDRAIN LAYER

1'-0" NEW CLAY LINER LAYER

15'-0" WIDE ROADWAY OF 1'-0" COMPACTED GRANULAR MATERIAL

2'-0" OVERLAP

2'-0" NEW BOTTOM ASH PROTECTION LAYER

1'-0" NEW GRANULAR MATERIAL UNDERDRAIN LAYER

1'-0" NEW CLAY LINER LAYER

EXIST. COMPACTED CLAY LINER

1% SLOPE

GEOTEXTILE FABRIC

2'-0" NEW BOTTOM ASH LAYER

1'-0" NEW GRANULAR MATERIAL UNDERDRAIN LAYER

1'-0" NEW CLAY LINER LAYER

EXISTING SUBGRADE

6" DIA. UNDERDRAIN PIPING

DETAIL 1 NOT TO SCALE

1% SLOPE ON TOP OF NEW CLAY TO SUMP

NEW COMMON FILL AS NEEDED

DETAIL OF GEOTEXTILE LAP
NOT TO SCALE

DETAIL 2
NOT TO SCALE

DETAIL 1
NOT TO SCALE

DETAIL 3
NOT TO SCALE






- NOTE:
- FOR PROJECT COVER SHEET & DRAWING LIST, SEE DWG. 1-30250A
 - WORK THIS DWG. WITH DWG. 1-30250B AND DWGS. 1-30250D THROUGH 1-30250H

DES. SRM	03/20/09
CHK'D. GK	
APP'D.	
JOB NO.	(New Case)
REV'D. BY	FOR WID
REVISION	

Last Edit: Mar. 20, 2003 CAD FILENAME: WZ_01_AEP_1-30250C.dwg

RECEIVED BY: ORBITAL E&C W.C. WZ438AB-S DATE 3-30-09	WILZIMMER GENERATING STATION THE CINCINNATI GAS & ELECTRIC CO. COLUMBUS SOUTHERN POWER CO. THE DAYTON POWER AND LIGHT CO. OWNERS
SIGNATURE SEAN R. MARSHALL, P.E. REGISTRATION NO. E-60212	DWGNO: 1-30250C SCALE: 1"=50' ENGINEER: S. MARSHALL DATE: 02/27/03 CHECKED: SRM GENERAL ENGINEERING DEPARTMENT THE CINCINNATI GAS & ELECTRIC COMPANY
PROJECT 01-7796	STAND: 14

CM 1 2 3 4 5 6 7 | G 16 INCH | H 12 | J TENTHS 10 | K 20 | L 30 | INCHES | M 1 | N 2 | O 3

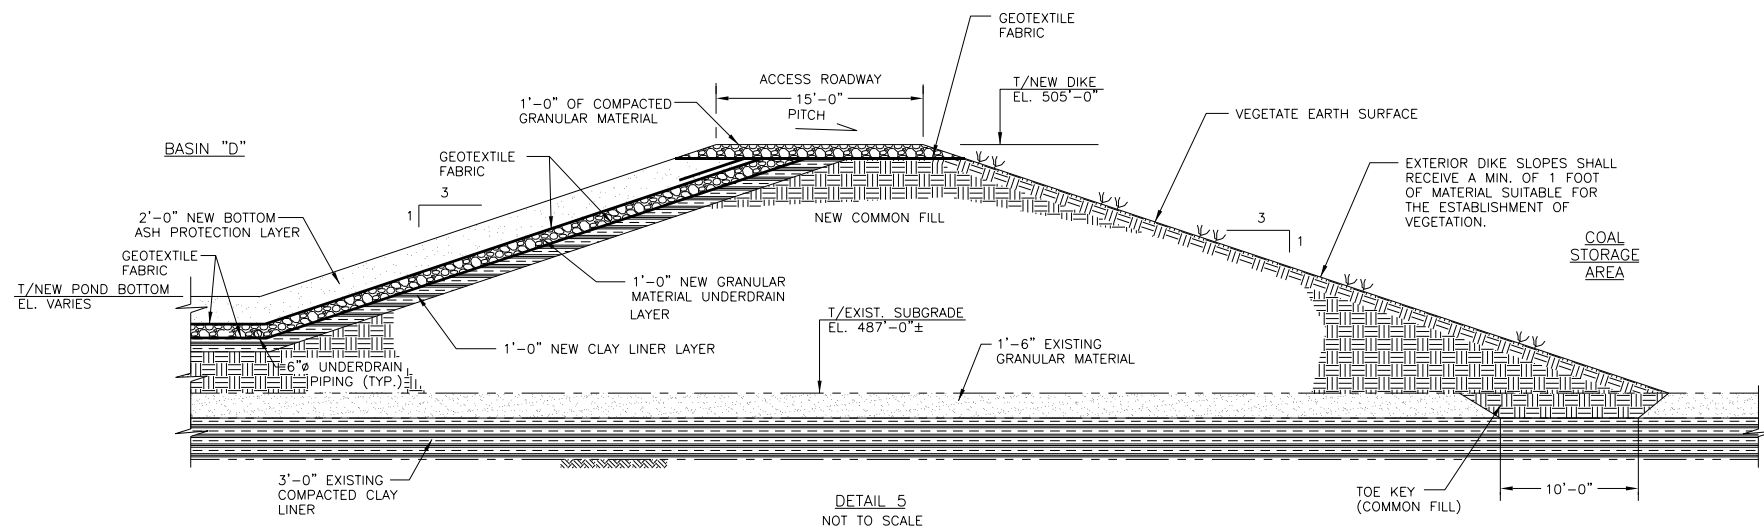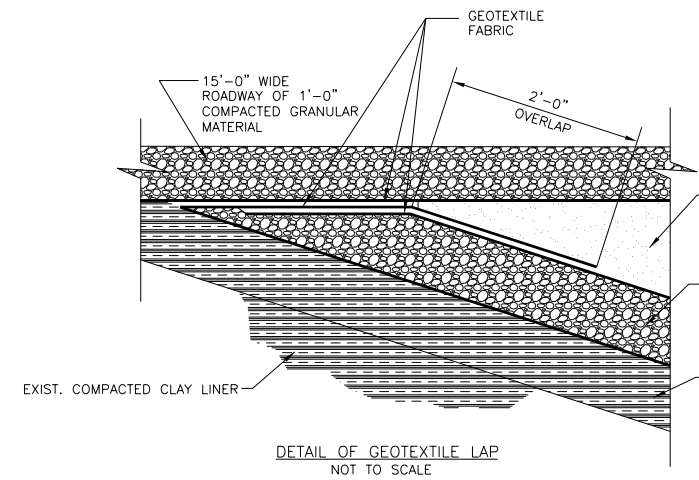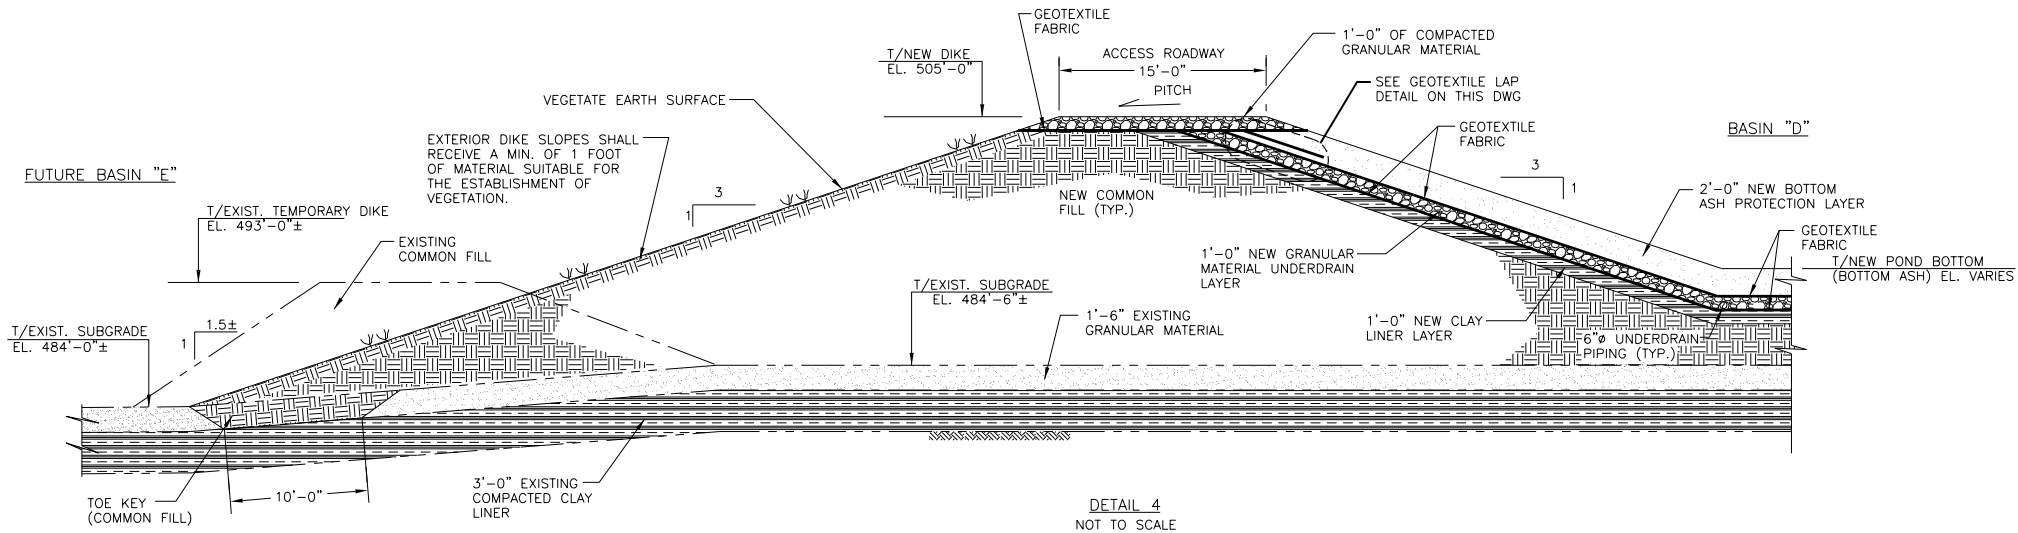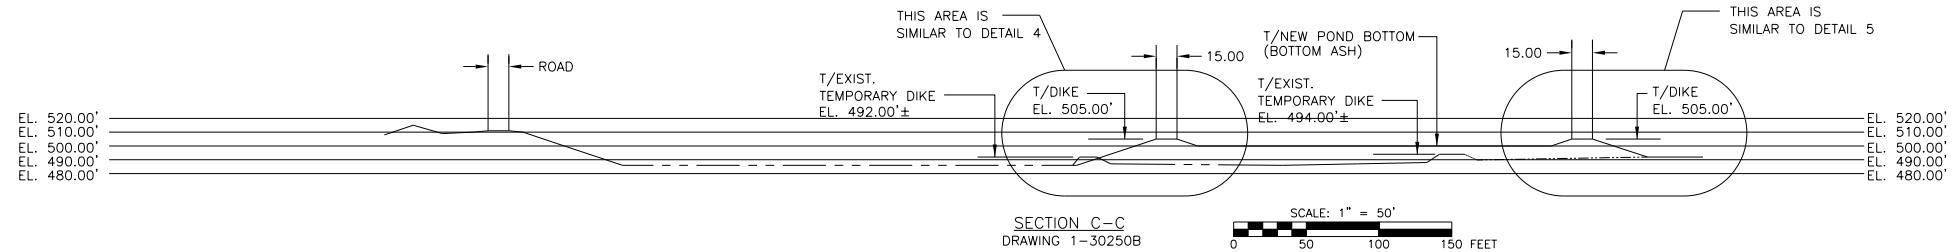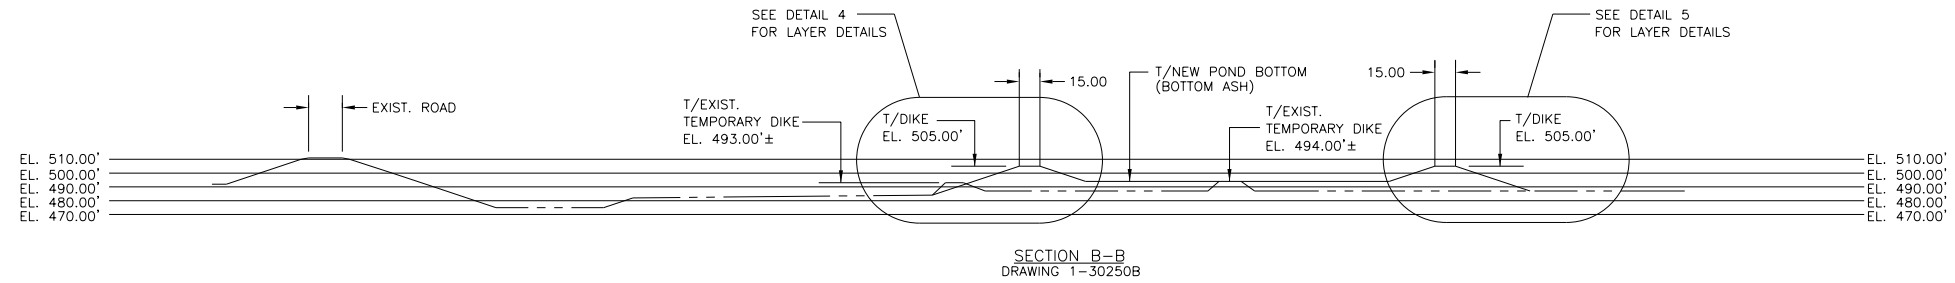

- NOTE:**
- FOR PROJECT COVER SHEET AND DRAWING LIST SEE DRAWING NO. 1-30250A
 - WORK THIS DWG. WITH DWS. 1-30250C AND 1-30250E THROUGH 1-30250H

DES. SRM.	03/20/03
CHK'D.	
APP'D.	
JOB NO.	
(New Comm)	
REV'D. BY	
FOR BID	
REVISION	

Last Edit: Mar. 20, 2003

CAD FILENAME: WZ_01_ABP_1-30250D.dwg

RECEIVED BY:
ENERGY PAC
W.C. WZ438AB-S
DATE 3-30-03

VMZIMMER GENERATING STATION
THE CINCINNATI GAS & ELECTRIC CO.
THE COLUMBUS SOUTHERN POWER CO.
THE DAYTON POWER AND LIGHT CO.
OWNERS

COAL STORAGE AREA
AND PONDS
DEWATERING BASIN "D"
SECTIONS B-B & C-C

SIGNATURE
SEAN R. MARSHALL, P.E.
REGISTRATION NO. E-60212

DWG. NO. 1-30250D
SCALE 1"=50'
BY: S. MARSHALL
DATE: 02/27/03

ORBITAL ENGINEERING, INC.
PITTSBURGH · CHICAGO · CLEVELAND · PHILADELPHIA
OAK BROOK · TOLEDO · CHARLESTON, WV · BRIMMINGHAM




APPROVED BY: [Signature]
DATE: 02/27/03
JOB NO. WZXXX
PAGE 14

PROJECT 01-7796


GENERAL ENGINEERING DEPARTMENT
THE CINCINNATI GAS & ELECTRIC COMPANY

UNDERDRAIN PIPING NOTES:

1. MATERIALS:
 PIPE: HIGH DENSITY POLYETHYLENE (HDPE) DUAL WALL CORRUGATED EXTERIOR AND SMOOTH INTERIOR ALL PIPING WITH SLOTTED PERFORATIONS (UNLESS NOTED), CONFORMING TO ASTM D3350 "STANDARD SPECIFICATIONS FOR POLYETHYLENE PLASTIC PIPE AND FITTINGS" AND AASHTO M-252. MANUFACTURER - ADVANCED DRAINAGE SYSTEMS (ADS) "TYPE N-12" OR APPROVED EQUAL.
 COUPLINGS: CONFORMING TO ASTM D3212 AND AASHTO M294 MANUFACTURER - (ADS) "PRO LINK W1" OR APPROVED EQUAL.
 FITTINGS: DUAL WALL, SHOP FABRICATED, CORRUGATED EXTERIOR AND SMOOTH INTERIOR MANUFACTURER - (ADS) "TYPE N-12".

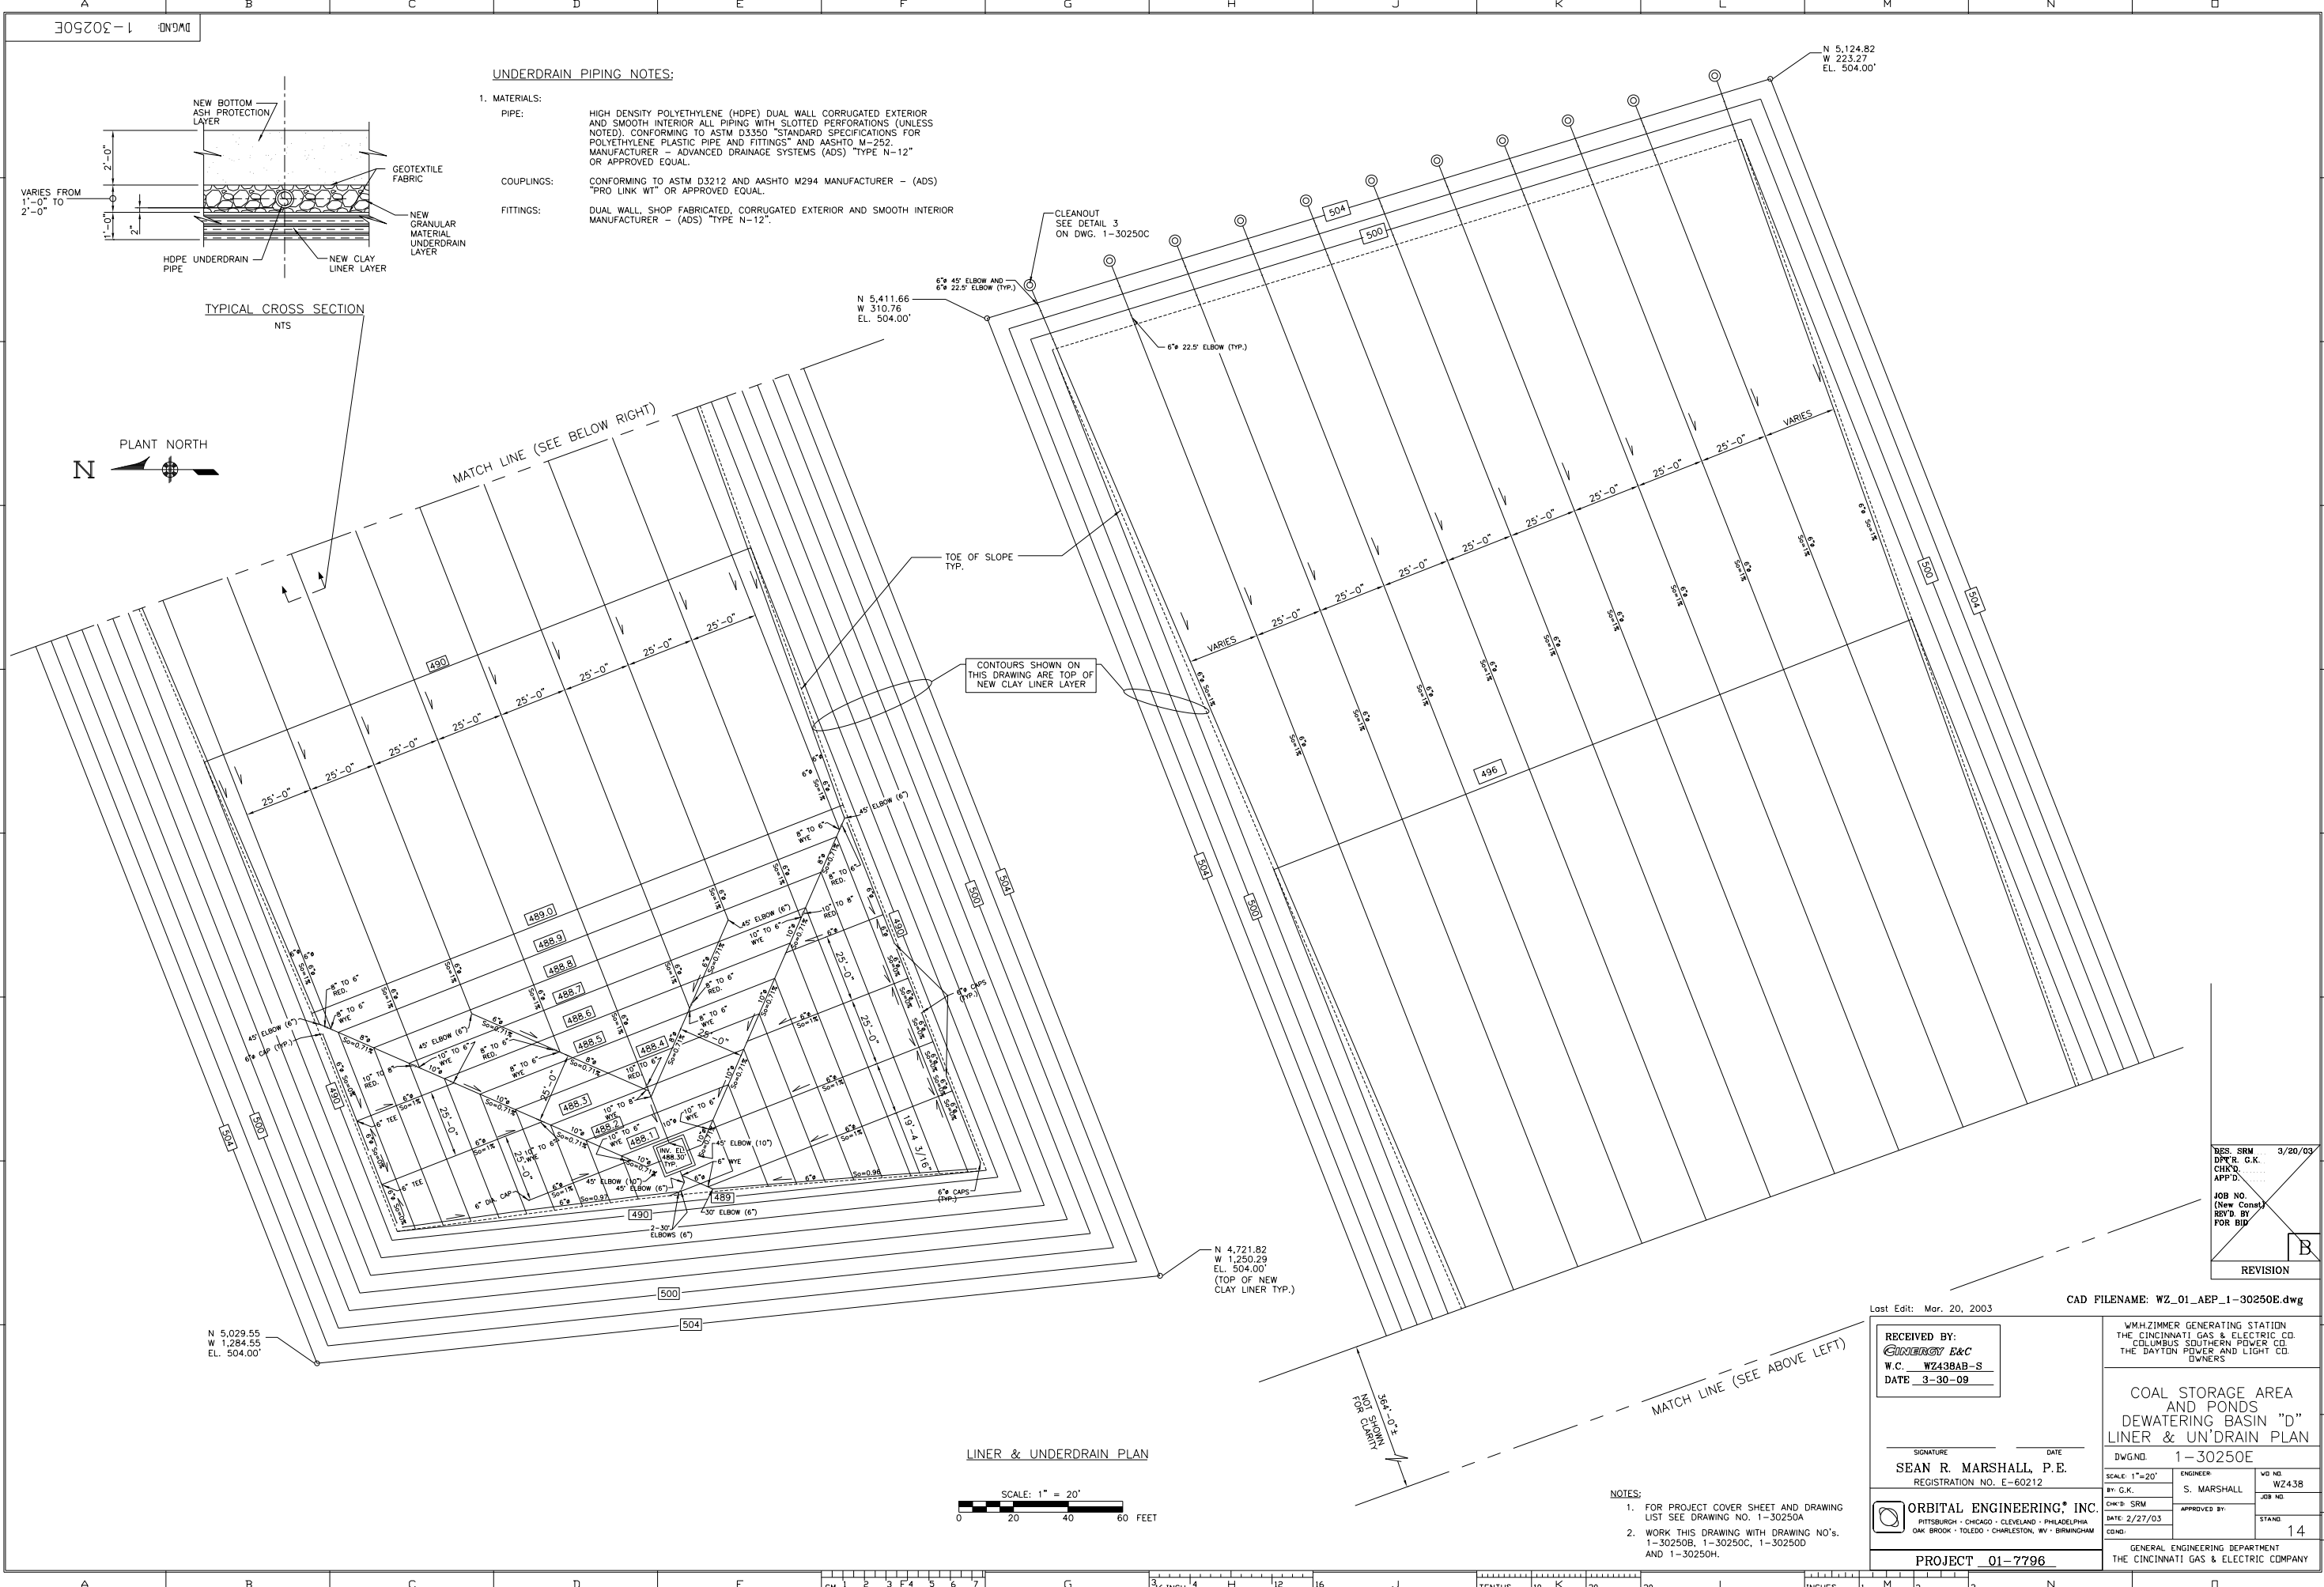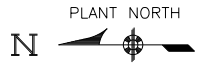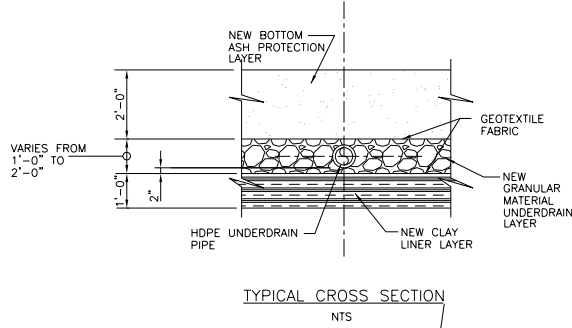

LINER & UNDERDRAIN PLAN

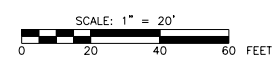

- NOTES:**
- FOR PROJECT COVER SHEET AND DRAWING LIST SEE DRAWING NO. 1-30250A
 - WORK THIS DRAWING WITH DRAWING NO'S. 1-30250B, 1-30250C, 1-30250D AND 1-30250H.

RECEIVED BY:
 W.C. WZ438AB-S
 DATE 3-30-09

SIGNATURE: SEAN R. MARSHALL, P.E.
 REGISTRATION NO. E-60212

ORBITAL ENGINEERING, INC.
 PITTSBURGH · CHICAGO · CLEVELAND · PHILADELPHIA
 OAK BROOK · TOLEDO · CHARLESTON, WV · BIRMINGHAM

WMZIMMER GENERATING STATION
 THE CINCINNATI GAS & ELECTRIC CO.
 COLUMBUS SOUTHERN POWER CO.
 THE DAYTON POWER AND LIGHT CO. OWNERS

COAL STORAGE AREA
 AND PONDS
 DEWATERING BASIN "D"
 LINER & UN'DRAIN PLAN

DWG. NO. 1-30250E
 SCALE: 1"=20'
 ENGINEER: S. MARSHALL
 JOB NO. WZ438
 DATE: 2/27/03
 APPROVED BY: [Signature]
 STAND: 14


GENERAL ENGINEERING DEPARTMENT
 THE CINCINNATI GAS & ELECTRIC COMPANY

DES. SRM	3/20/03
CHK'D. G.K.	
APP'D.	
JOB NO.	
(New Const)	
REV'D. BY	
FOR BID	
REVISION	


Last Edit: Mar. 20, 2003

CAD FILENAME: WZ_01_AEP_1-30250E.dwg


PROJECT 01-7796

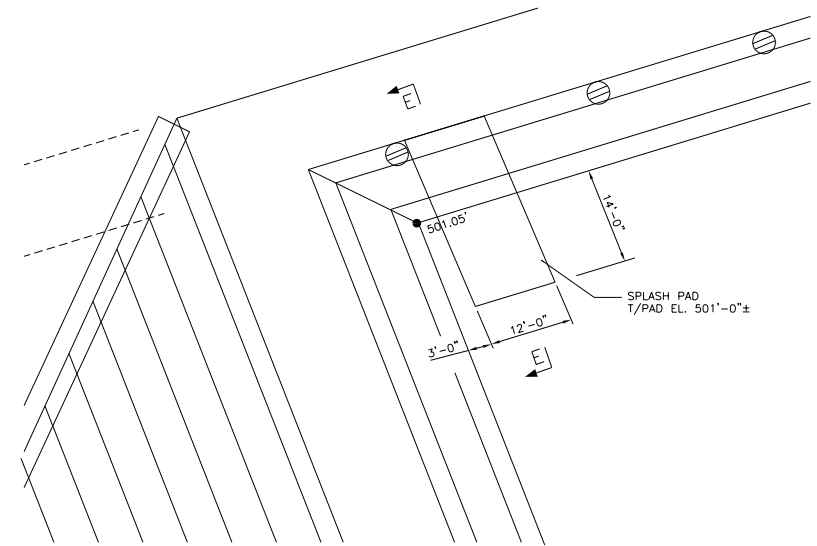


PLAN OF SPLASH PAD
SCALE: 1"=10'

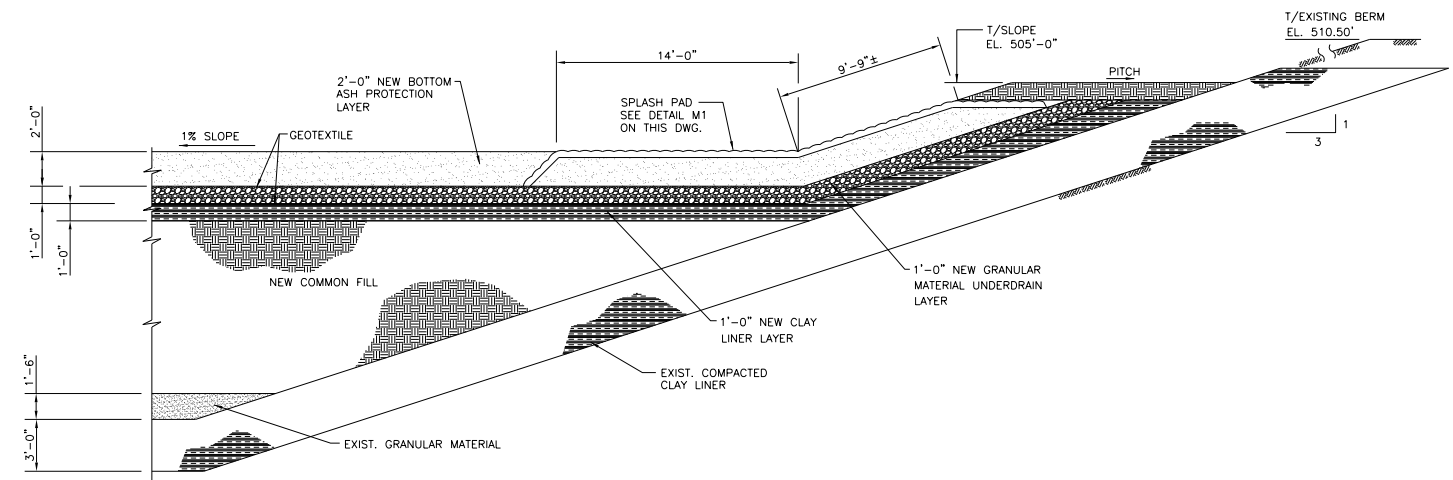


SECTION E-E
SCALE: 1/4"=1'-0"

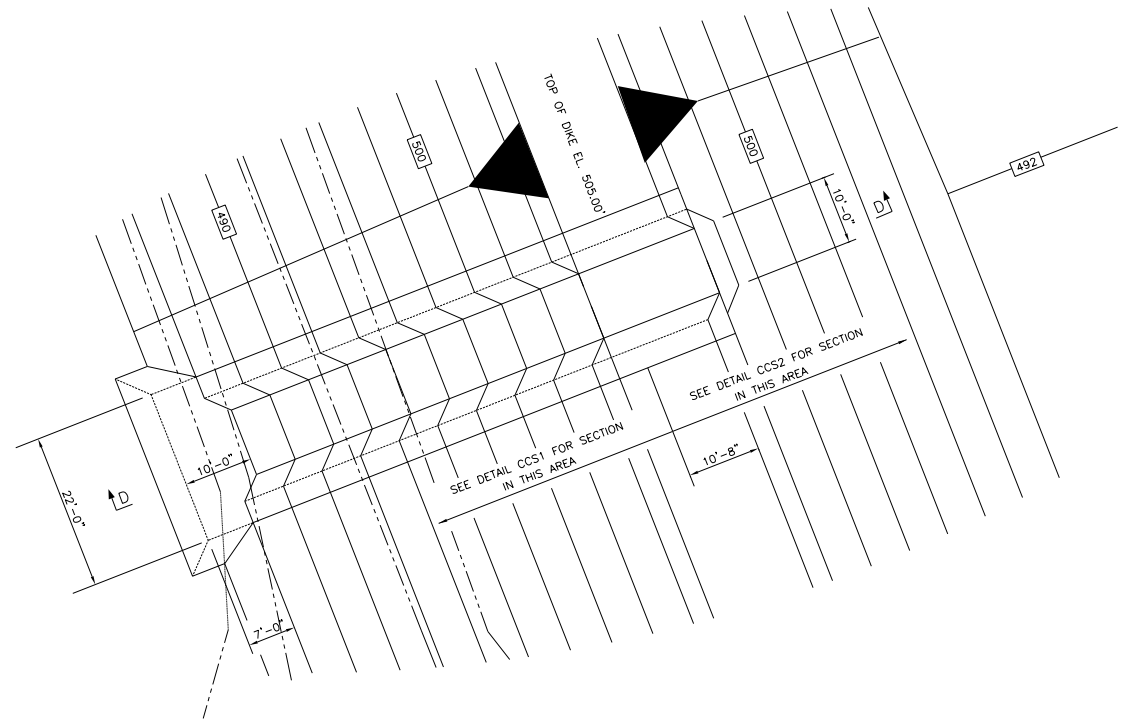


PLAN OF CONTROL CONVEYANCE STRUCTURE
SCALE: 1"=10'

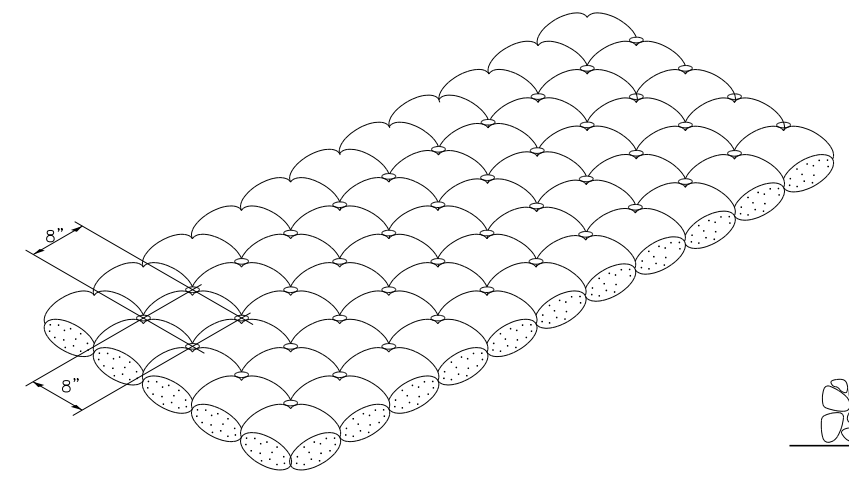


DETAIL M1
TYPICAL SPLASH PAD
NOT TO SCALE

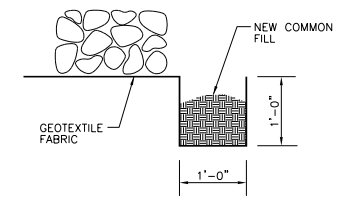


DETAIL AT1
GEOTEXTILE ANCHOR TRENCH
NTS

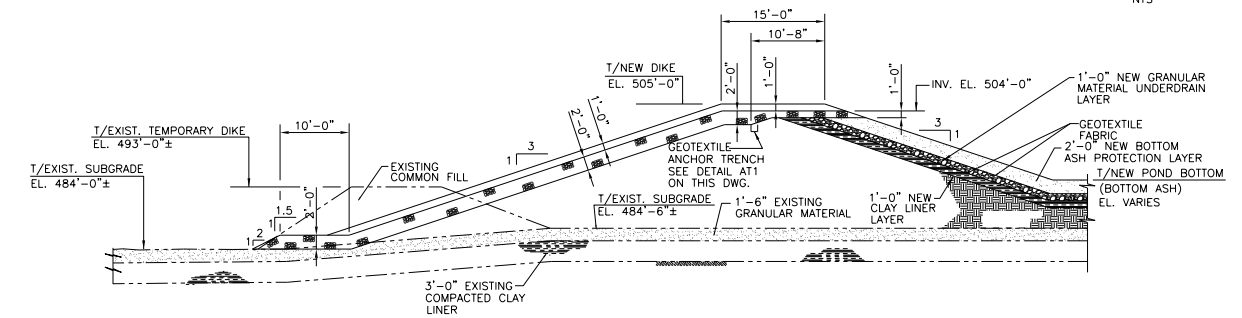

SECTION D-D
SCALE: 1"=10'

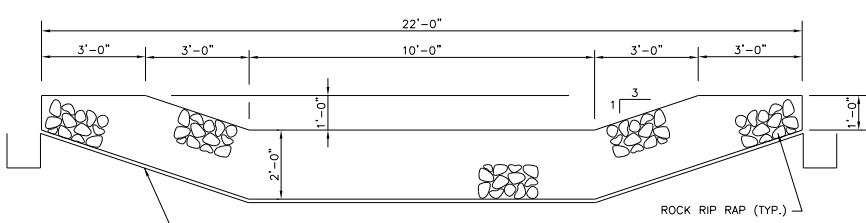

DETAIL CCS1
SCALE: 1/2"=1'-0"

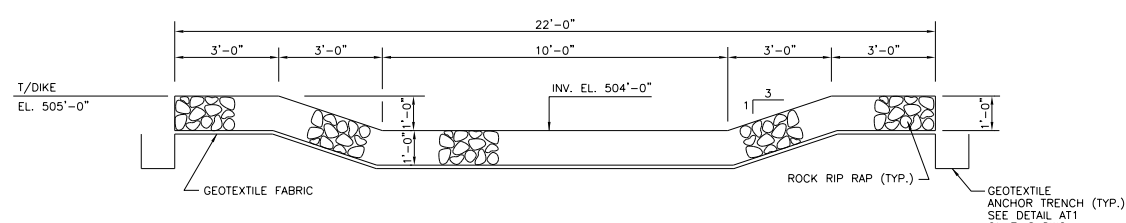



DETAIL CCS2
SCALE: 1/2"=1'-0"

- NOTE:
- FOR PROJECT COVER SHEET & DRAWING LIST, SEE DWG. 1-30250A
 - WORK THIS DRAWING WITH DRAWING NO'S. 1-30250B THRU 1-30250E & 1-30250G & 1-30250H.

DES. SRM	03/20/03
DYR. GK	
CHK'D.	
APP'D.	
JOB NO.	(New Const)
REV'D. BY	FOR BID
REVISION	

Lost Edit: STAMP CAD FILENAME: WZ_01_AEP_1-30250P.dwg

<p>RECEIVED BY: W.C. WZ438AB-S DATE: 3-30-09</p>	<p>WMH/ZIMMER GENERATING STATION THE CINCINNATI GAS & ELECTRIC CO. COLUMBUS SOUTHERN POWER CO. THE DAYTON POWER AND LIGHT CO. OWNERS</p>
<p>SIGNATURE: SEAN R. MARSHALL, P.E. REGISTRATION NO. E-60212</p>	<p>COAL STORAGE AREA AND PONDS DEWATERING BASIN "D" MISC. SECTIONS & DETAILS</p>
<p>ORBITAL ENGINEERING, INC. PITTSBURGH - CHICAGO - CLEVELAND - PHILADELPHIA OAK BROOK - TOLEDO - CHARLESTON, WV - BIRMINGHAM</p>	<p>DATE: 02/27/03 STAND: 14 GENERAL ENGINEERING DEPARTMENT THE CINCINNATI GAS & ELECTRIC COMPANY</p>

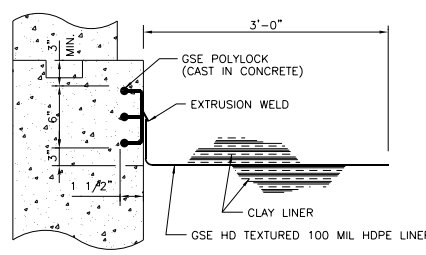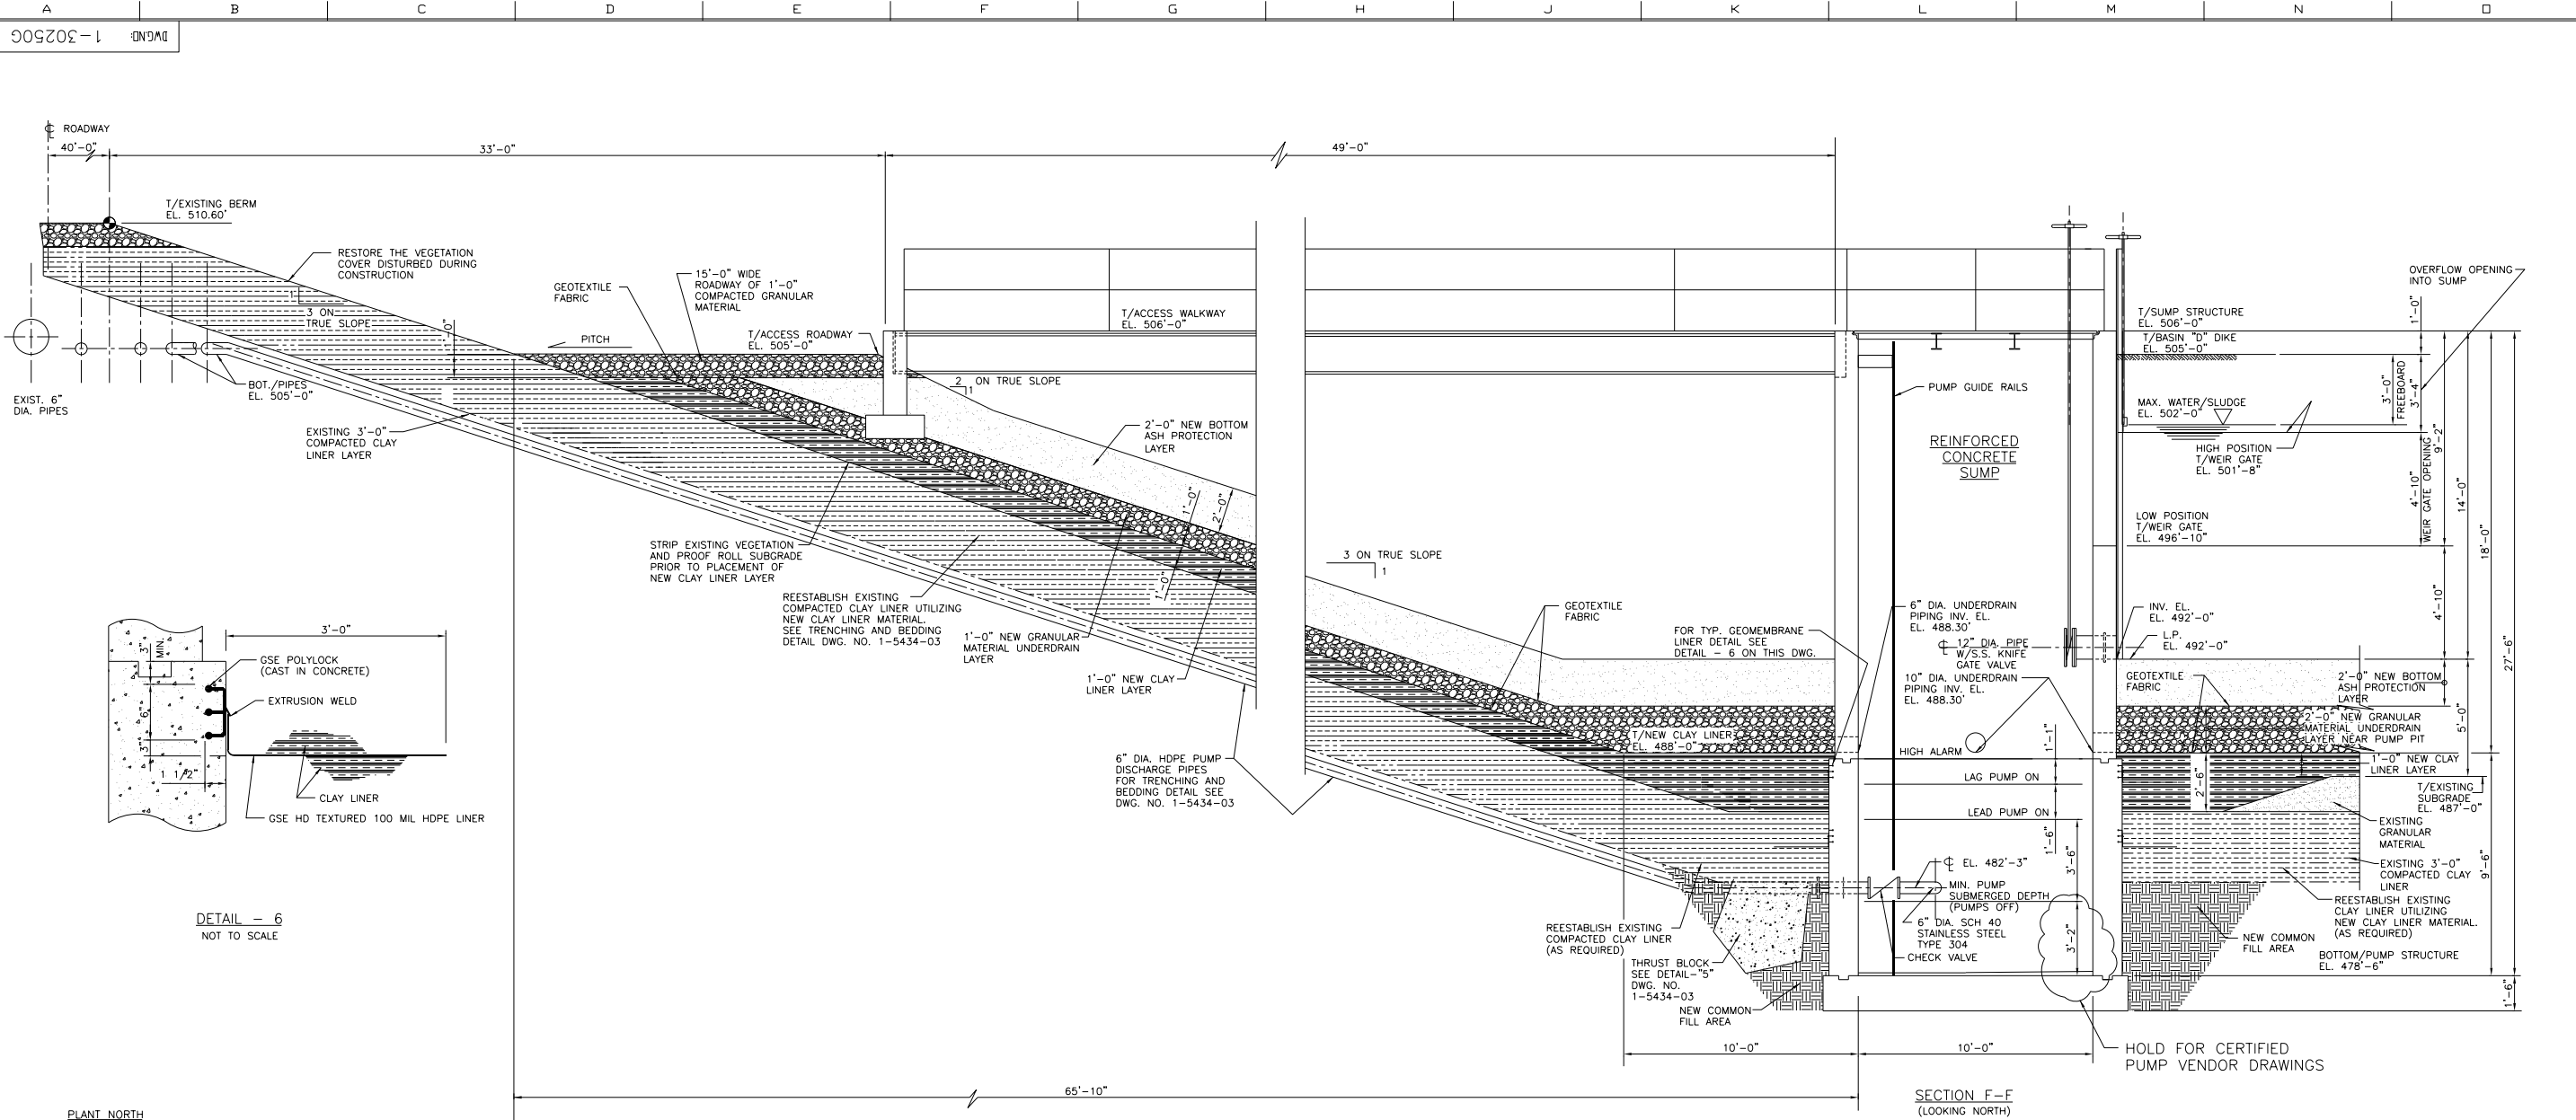

SECTION F-F
(LOOKING NORTH)
(DWG. 1-30250B)

- NOTES:
- FOR PROJECT COVER SHEET & DRAWING LIST, SEE DWG. 1-30250A
 - WORK THIS DRAWING WITH DRAWING NO'S. 1-30250B THROUGH 1-30250F, 1-30250H, 1-30250I & 1-5434-01
 - PUMP DATA (EACH) - 500 GPM - 55 FT TDH
PUMP SPEED 1,200 RPM
15 H.P. MOTOR @ 1,200 RPM

FOR BID

Last Edit: Mar. 13, 2003

CAD FILENAME: WZ_01_AEP_1-30250G.dwg

RECEIVED BY:
ENERGY E&C
W.C. WZ438AB-S
DATE 3-30-09

SIGNATURE: SEAN R. MARSHALL, P.E.
REGISTRATION NO. E-60212

ORBITAL ENGINEERING, INC.
PITTSBURGH • CHICAGO • CLEVELAND • PHILADELPHIA
OAK BROOK • TOLEDO • CHARLESTON, WV • BIRMINGHAM

PROJECT 01-7796

WMH ZIMMER GENERATING STATION
THE CINCINNATI GAS & ELECTRIC CO.
COLUMBUS SOUTHERN POWER CO.
THE DAYTON POWER AND LIGHT CO. OWNERS


COAL STORAGE AREA
AND PONDS
DEWATERING BASIN "D"
G.A. OF PUMP PIT

DWG. NO. 1-30250G
SCALE: 3/8"=1'
BY: R.L.G.
CHK'D: SRM
DATE: 02/27/03
CDG:


ENGINEER: S. MARSHALL
APPROVED BY: [Signature]
JOB NO. WZxxx
JOB NO. 14
STAND:

GENERAL ENGINEERING DEPARTMENT
THE CINCINNATI GAS & ELECTRIC COMPANY


DES. B.O.	03/20/03
DRAW. R.L.G.	
CHK'D.	
APP'D.	
JOB NO.	(New Const)
REV'D. BY	FOR BID
REVISION	

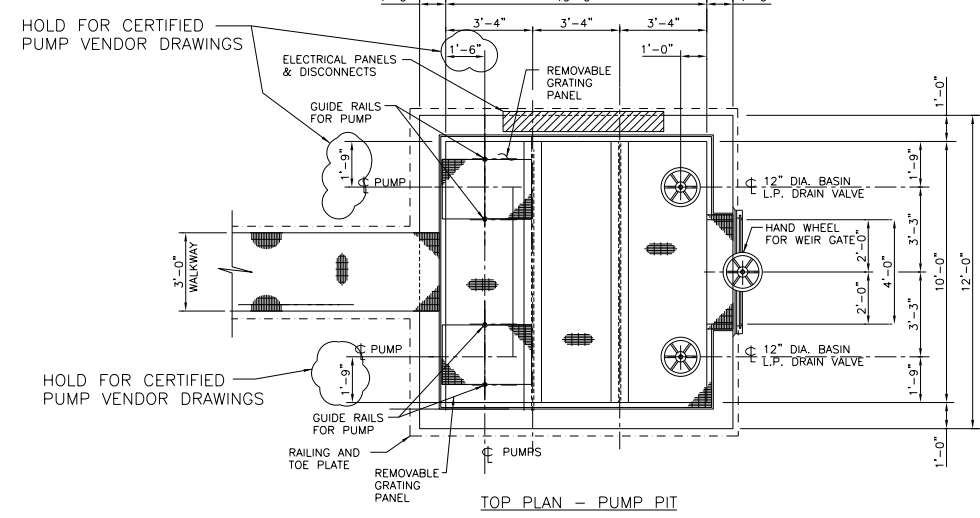

HOLD FOR CERTIFIED PUMP VENDOR DRAWINGS

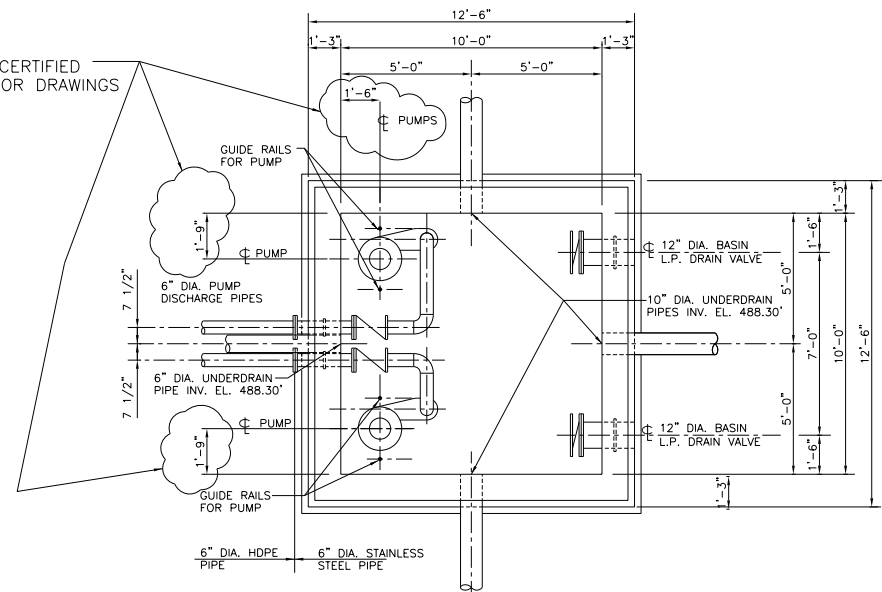

BOTTOM PLAN - PUMP PIT

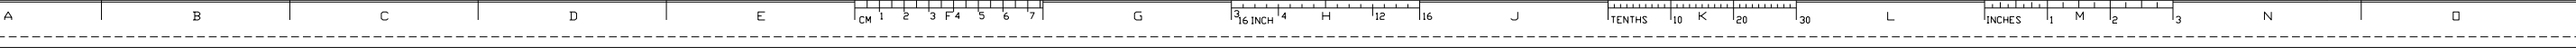

GENERAL NOTES

- All elevations are Geodetic and are given in feet.
- The coordinate grids indicated on the drawings are Plant coordinates.
- Figured dimensions take precedence over scaled measurements.
- All work shall be performed in accordance with all applicable Federal, State and Local laws and ordinances, and shall comply with applicable regulations of all Federal, State and Local governmental agencies having jurisdiction over the activity.
- Where codes, standards and specifications are cited or referred to, the latest or current edition shall apply.
- The Contractor shall be responsible for control of all water from the working areas. Storm water shall be conducted to areas away from the work in a manner to prevent erosion in accordance with the owners requirements. Storm water shall not be permitted to accumulate in the excavation or low areas of the site. The Contractor shall provide all temporary ditches, berms, grading, sump and pumps required for temporary dewatering. All Runoff shall be directed into existing Coal Pile Runoff Settling Basins.
- The Contractor shall perform all excavations in accordance with OSHA 29 CFR part 1926, subpart P - "Excavations". The Contractor shall design, furnish, install and maintain all shoring and bracing systems as required for the performance of the work.
- All excavated organic material and topsoil shall be segregated from other common material to be used for earthfill. Organic material and topsoil shall be stockpiled onsite as directed by the Owner for use as the vegetative layer.
- Inactive stockpile or onsite borrow areas shall be temporarily seeded in accordance with the vegetation specifications.

FILL PLACEMENT, COMPACTION AND MATERIAL GRADATION NOTES

- General Fill Placement
 - The Owner shall Contract for Third party Geotechnical Field Engineering and Laboratory Services required for Quality Control and Assurance of the Fill placement, compaction and gradations specifications. The Contractor may provide any Geotechnical Field Engineering and Laboratory Services required at their option.
 - Subgrade preparation: All areas receiving fill placement shall be cleared of existing fill placement, sludge/sediment deposits and other debris down to the original Coal Storage Area ground surface contours as indicated on Drawing No. 1-30250B. Existing permanent dike slopes shall be stripped of vegetation in the area of work. All Subgrade surfaces shall be proof-rolled with heavy equipment until there is no visible movement beneath the equipment. Any soft, wet, unstable or otherwise unsuitable material detected during proof-rolling shall be removed and replaced with location appropriate well compacted fill material. If removal of any portions of the existing 3'-0" clay liner is necessary, the liner shall be reestablished utilizing new clay liner material.
 - Only soil materials conforming specifically to these specifications and in location as indicated on the drawings may be used.
 - At no time shall the Contractor place any fill materials overtop of frozen surfaces, nor shall any frozen materials be incorporated into fill areas.
 - At no time shall the Contractor place fill materials overtop of organic material, topsoil, vegetation, standing water, mud, debris, waste sediments or sludge. If any of these materials are present they shall be removed and disposed of in a segregated method in the designated onsite area as directed by the Owner.
 - No soil material shall be placed or compacted during weather conditions which would interfere with adequate compaction or moisture content control.
 - If prior to fill placement, the moisture content of the material does not comply with the specified moisture content range, then it shall be the responsibility of the Contractor to wet or dry the material, as applicable, to achieve the prescribed moisture content.
 - When a density or moisture content test is not in compliance with the specifications, the Contractor shall scarify the lift, adjust the moisture content, and re-compact the soils for an area extending from the failed test to one half of the distance to the nearest passing test, in all directions. The re-compact area shall be re-tested for compliance.
- Inert Bottom Ash (Protection Layer)
 - All Inert Bottom Ash materials used shall be a byproduct of the Plant, supplied by the Owner, and shall be loaded and hauled from the onsite silo or stockpile area as directed by the Owner.
 - All material used for construction of the Protection Layer shall be inert, non-expansive and pyrite free.
 - All material shall be moved, dozed, bucketed into place by standard earthmoving equipment so as to establish compacted lifts of no more than 8 inches in overall thickness.
 - Each lift shall be compacted to a minimum of 75% relative density as determined by ASTM test No. D-4253 and D-4254.
 - The maximum particle size for any material to be incorporated into the Bottom Ash Protection Layer shall be 2 inches in its largest dimension, and no more than 5% by weight (of the 2 inch size material) may be utilized.
 - At no time shall more than 5% by weight of material smaller than the No. 200 U. S. Standard sieve be used in construction of the Bottom Ash Protection layer.
- Granular Material (Underdrain Layer and Granular Roadway Surfacing)
 - All granular material shall be supplied from offsite sources by the Contractor.
 - Granular material shall be a natural gravel material conforming to gradation, material quality and durability requirements of AASHTO No. 57 coarse aggregate and ODOT Construction and Material Specification Section 703. The material shall not be limestone.
 - All material shall be moved, dozed, bucketed into place by standard earthmoving equipment so as to establish compacted lifts of no more than 8 inches in overall thickness.
 - Each lift shall be compacted to a minimum of 75% relative density as determined by ASTM test No. D-4253 and D-4254.
- Clay (Clay Liner Layer)
 - All material required for the Compacted Clay Liner Layer shall be supplied by the Owner from on-site borrow areas, and shall be loaded and hauled from the onsite areas as directed by the Owner.
 - The Clay material shall meet the gradation and plasticity requirements for a Unified Soils Classification System soil type "CL".
 - All material shall be moved, dozed, bucketed into place by standard earthmoving equipment so as to establish compacted lifts of no more than 6 inches in overall thickness. Clay layer lifts shall be placed at the same slope as the liner final grades.
 - Prior to placement of a successive lift, the underlying material shall be scarified to a minimum depth of 2 inches. Only after the working surface is thoroughly scarified shall the next lift be installed.
 - Each lift shall be compacted to at least 95% the maximum dry density, for that material, as determined by a Standard Proctor Test (ASTM-698).
 - The moisture content of the material to be compacted shall be 0% to 4% above the optimum moisture content, as determined by the Standard Proctor Test.
 - The Owner shall perform a minimum of one Soil Classification Test (ASTM D-2488, D-422, D-424, D-2216 and D-854) per 5,000 cubic yards of clay for each different clay borrow area or type whichever results in a greater frequency.
 - The Owner shall perform a minimum of one in-place density and moisture content test (ASTM D-2922 and D-3017) per lift per 2500 square feet of compacted clay liner, with a minimum of one test for any day that soil material is compacted.
 - The Owner shall perform a minimum of one Standard Proctor Test (ASTM D-698) for each different soil sample.
 - The compaction specifications presented herein are considered the minimum compactive efforts. It shall be the Contractor's sole responsibility to place and compact the clay soils in such a fashion to provide an in-place permeability of 1 x 10⁻⁷ cm/sec or lower.
 - All samples shall be selected by the Owner and all testing shall be performed by an independent Laboratory contracted by the Owner.
- Common Fill Material
 - All material required for Common Fill shall be supplied by the Owner from on-site borrow areas, stockpiles or existing temporary dikes. Soil from on-site borrow areas shall be loaded and hauled from the onsite areas as directed by the Owner. Soil used as common fill shall be inert, free of organic material, debris and shall be 2 inches in its largest dimension.
 - All material shall be moved, dozed, bucketed into place by standard earthmoving equipment so as to establish compacted lifts of no more than 8 inches in overall thickness.
 - Each lift shall be compacted to at least 95% the maximum dry density, for that material, as determined by a Standard Proctor Test (ASTM-698). Should the Standard Proctor Test not be applicable due to the gradation of the material, then it shall be compacted to a minimum of 75% relative density as determined by ASTM Test No. D-4253 and D-4254.
 - The moisture content of the material to be compacted shall not deviate from the optimum moisture content, as determined by the Standard Proctor Test, by more than 2%.
 - The Owner shall perform a minimum of one Soil Classification Test (ASTM D-2488, D-422, D-424, D-2216 and D-854) per 5,000 cubic yards of soil, or for each different soil type, whichever results in a greater frequency.
 - The Owner shall perform a minimum of one in-place density and moisture content test (ASTM D-2922 and D-3017) per lift per 2500 square feet of compacted soil, with a minimum of one test for any day that soil material is compacted.
 - The Owner shall perform a minimum of one Standard Proctor Test (ASTM D-698) for each different soil sample.
 - All samples shall be selected by the Owner and all testing shall be performed by an independent Laboratory contracted by the Owner.
- Geotextile Filter Fabric
 - All Geotextile Filter Fabric shall be Geotex type 451 nonwoven as manufactured by Synthetic Industries Inc., Geosynthetic Products Division. Roll width 12.5 or 15.0 feet and roll length 360 feet.
 - Grab Tensile Strength ASTM D-4632 - 135 lbs.
Grab Elongation ASTM D-4632 - 60 %
Puncture Strength ASTM D-4833 - 75 lbs.
Mullen Burst ASTM D-3786 - 270 psi
Trapezoidal Tear ASTM D-4533 - 60 lbs.
Apparent Opening size ASTM D-4751 100 U. S. Sieve
Permittivity ASTM D-4491 2.10 sec-1
Permeability ASTM D-4491 0.29 cm/sec
Water flow rate ASTM D-4491 135 gpm/ft²
UV resistance ASTM D-4355 70% retained @ 500 hours
 - All Geotextile Filter Fabric shall be stored, handled, installed and protected in accordance with the manufacturer's specifications.
- Stone Riprap Protection
 - All material required for Stone Riprap Protection shall be supplied by the Contractor from off-site sources.
 - Stone shall conform to the gradation and durability requirements of the Ohio Department of Transportation Type D "Dumped-Rock Fill".
- Geomembrane
 - Geomembrane Sheet shall be GSE HD Textured as Manufactured by GSE Lining Technology Inc. The material is a high density polyethylene. Roll width 22.5 feet x 325 ft.
 - Density ASTM D-761/1593/5199 100 mils
Density ASTM D-792/1505 0.94 g/cm³
Tensile properties ASTM D-638, Type IV
Strength at Break 125 lb/in-width
Strength at Yield 216 lb/in-width
Elongation at Break 120 %
Elongation at yield 13 %
Tear resistance ASTM D-1004 75 lb
Puncture resistance FTMS 101 130 Lb
 - Geomembrane Embedment shall be GSE Polylock as Manufactured by GSE Lining Technology Inc. The material is a high density polyethylene. Dimensions 10' long, 6" width, 1" anchor finger length.
 - The Geomembrane Sheet shall be extrusion welded to the Geomembrane Embedment per the manufacturer's instructions.
 - All Geomembrane material shall be stored, handled, installed and protected in accordance with the manufacturer's specifications.
- Erosion Control Blankets
 - The erosion control blanket shall be BioNet Series S150BN as Manufactured by North American Green. The blankets shall be 100% biodegradable consisting of agricultural straw fibers stitched bonded between 100% jute yarn nettings. Roll width 6.67 feet x 108 feet length. Stokes shall be 6" Eco degradable type.
 - All erosion control blankets shall be stored, handled, installed and protected in accordance with the manufacturer's specifications.
- Erosion Control Revetment- Fabric Forms for Concrete Fill
 - The Erosion Control Revetments shall be Fabriform Filter Point Style 8" FP as manufactured by Construction Techniques Inc. The Fabric forms shall be overage of 4" thickness manufactured from double layer nylon fabric woven together in such a manner as to provide filter points on 8" centers for the relief of hydrostatic uplift pressures.
 - Mill width panels shall be shop assembled and sewn to fit the site topography.
 - Grout shall consist of a mixture of Portland cement, fine aggregate, admixtures and water so proportioned as to provide a pumpable mix. The cured cement grout shall exhibit a minimum compressive strength of 3,000 psi in 28 days.
- Permanent Vegetation
 - Temporary and Permanent Vegetation shall be performed on the outside surfaces of all new embankment slopes, disturbed portions of existing inside embankment slopes and existing roadway earth berms disturbed during construction.
 - All Temporary and Permanent Vegetation shall be performed in accordance with the Clermont County Water Management & Sediment Control Regulations.
 - Seeded shall be prepared by raking and applying Lime and fertilizer. Lime acid soil (ph=5.5 or less) at a rate of 100 lbs/1000 sf. Apply fertilizer at a rate of 12-15 lbs/1000 sf of 10-10-10 or 12-12-12 analysis or equivalent.
 - Seeding in the Spring with Tall Fescue at 1 lb/1000 sf and at other times Flatpea at 0.50 lb & Tall Fescue at 0.50 lb/1000 sf. Apply the seed uniformly by mechanical equipment or with fertilizer using a hydro-seed method.
 - Mulch with small grain straw at a rate of 100 lbs/1000 sf.
 - Irrigate with adequate until growth is firmly established.

FOR BID


DES. NO. 03/20/03
 DFR. GK
 CHK'D.
 APP'D.
 JOB NO.
 (New Const)
 REV'D. BY ORBITAL
 FOR BID


REVISION

Last Edit: Mar. 20, 2003 CAD FILENAME: WZ_01_AEP_1-30250H.dwg

RECEIVED BY: GENERAL E&C W.C. WZ438AB-S DATE 3-30-09		W.M.ZIMMER GENERATING STATION THE CINCINNATI GAS & ELECTRIC CO. COLUMBUS SOUTHERN POWER CO. THE DAYTON POWER AND LIGHT CO. OWNERS	
SIGNATURE SEAN R. MARSHALL, P.E. REGISTRATION NO. E-60212		DWG. NO. 1-30250H SCALE NONE BY: GK CHK'D. SRM DATE: 02/27/03 (CND)	
ORBITAL ENGINEERING* INC. PITTSBURGH • CHICAGO • CLEVELAND • PHILADELPHIA OAK BROOK • TOLEDO • CHARLESTON, WV • BIRMINGHAM		ENGINEER S. MARSHALL APPROVED BY: STAGE 14 GENERAL ENGINEERING DEPARTMENT THE CINCINNATI GAS & ELECTRIC COMPANY	
PROJECT 01-7796			

- NOTE:
- FOR PROJECT COVER SHEET & DRAWING LIST, SEE DWG. 1-30250A
 - WORK THIS DRAWING WITH DWGS. 1-30250B THROUGH 1-30250G

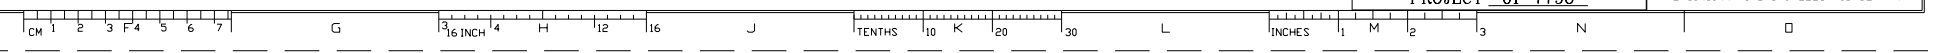

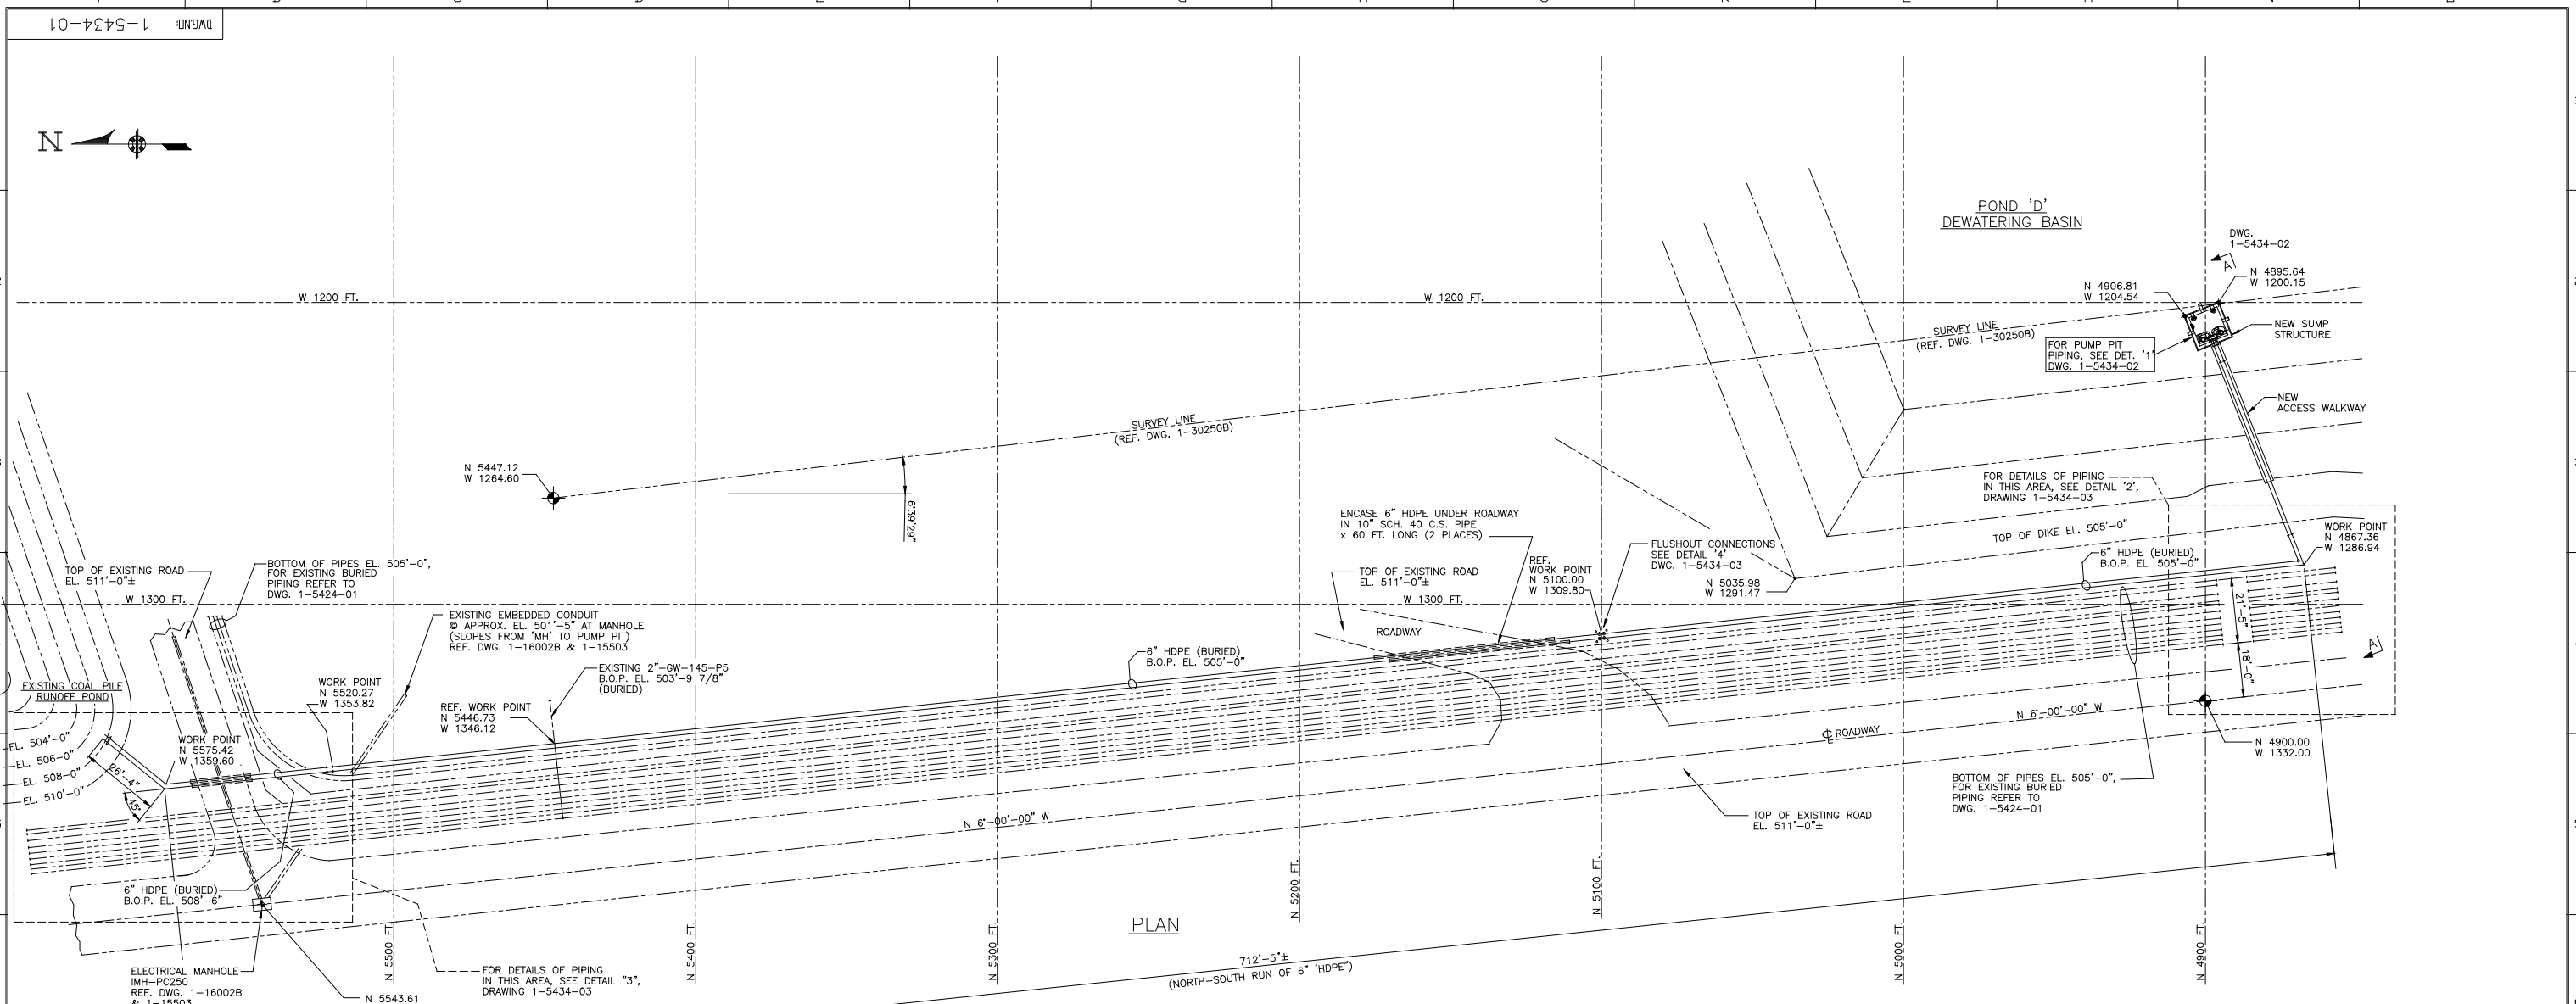

PLAN

GENERAL NOTES:

1. WORK THIS DWG. WITH DWGS. 1-5434-02 & 03
2. FOR PROJECT DRAWING LIST REFER TO DWG. 1-30250A
3. PIPING DESIGN, FABRICATION, ERECTION, CLEANING, TESTING, SUPPORTING TO BE PER THE CODE FOR PRESSURE PIPING B31.3, THE PLASTIC PIPE INSTITUTE THE DRAWINGS AND CENERGY STANDARDS.
4. THESE DRAWINGS ARE BASIC DESIGN DRAWINGS WITH LIMITED DETAILS. ALL EXISTING CONDITIONS DO NOT APPEAR ON THE DRAWINGS. THE CONTRACTOR SHALL FIELD VERIFY ALL PERTINENT DIMENSIONS AND ELEVATIONS THAT APPEAR ON THE DRAWINGS PRIOR TO FABRICATION AND INSTALLATION.
5. "HDPE" PIPE IS NORMALLY FIELD FABRICATED. IF THE CONTRACTOR ELECTS TO SHOP FABRICATE PIPE SPOOLS, HE SHALL HAVE DIMENSIONS FIELD VERIFIED PRIOR TO FABRICATION.
6. PIPING MATERIALS AS FOLLOWS: (UNLESS OTHERWISE NOTED ON THE DWGS.)
7. COORDINATES ARE SHOWN IN DECIMAL/FEET UNITS.
8. FOR TRENCHING BEDDING AND BACKFILL SEE DETAIL '6', DWG. 1-5434-03
9. WEIR GATE SPECIFICATIONS AS FOLLOWS:

PIPING INSIDE THE PUMP PIT (INCLUDING PENETRATIONS)

PIPE: 12", 6" & 4" PIPE, STD. WALL, STN. STL. SEAMLESS, ASTM A-312 GRADE TP316, BEVELED ENDS

FITTINGS: 6", STD. WALL, STN. STL. BUTT WELD, SEAMLESS, ASTM A-403 GRADE TP316

FLANGES: 12" 150# R.F. SLIP ON, 316 STN. STL., ASTM A-182, GR. F316
6" & 4" 150# R.F. OR F.F. (AS SHOWN) WELD NECK, 316 STN. STL., ASTM A-182, FR. F316

GASKETS: 150# RING TYPE OR FULL FACE, 1/8" THICK EPDM RUBBER

BOLTING: ALL THREAD STUD BOLTS, A-193 B7, WITH A-194 2H NUTS (USE HEX. CAP SCREWS AT 12" KNIFE GATE VALVES) A354 GRADE 'BD'

CHECK VALVE: 6" 150# FLANGED SWING CHECK, DUCTILIR IRON BODY WITH S.S. TYPE 304 TRIM STOCKHAM FIG. D-931

GATE VALVES: 12" DEZURIK SERIES 'L' KNIFE GATE No. KGL-12-WI-SI-ZI-M-MNH016 EXX049CWS 316 STN. STL., SUPPLIED WITH STEM EXTENSION FOR 210" Ø OF VALVE TO Ø OF 16" HANDWHEEL, WITH (2) 316 STN. STL. ADJUSTABLE STEM GUIDES EACH No. 367-5960CWS (2"-25")

PIPING OUTSIDE THE PUMP PIT:

PIPE: HIGH DENSITY EXTRA HIGH MOLECULAR WEIGHT POLYETHYLENE (HDPE), ASTM D-1248 & D-3350, PE3408, SDR-17 CLASS 100 PSI AT 73.4°F, CELL CLASSIFICATION PE-345434C.

FITTINGS: SAME MATERIAL & PRESSURE RATING AS PIPE, MOLDED BUTT FUSION TYPE ENDS.

JOINTS: BUTT FUSION TYPE IN STRICT ACCORDANCE WITH THE MFG. RECOMMENDATIONS

FLANGES: MADE UP WITH 'HDPE' STUB ENDS & CARBON STEEL BACK-UP FLANGES, 150# RATING

BOLTING AND GASKETS: AS LISTED FOR STN. STL. ABOVE.

QUANTITY: ONE (1), AS MANUFACTURED BY FRESNO VALVES & CASTINGS INC. OR APPROVED EQUAL.

SIZE: 4'-0" WIDE CLEAR OPENING x 4'-10" HIGH CLEAR OPENING.

TYPE: SELF CONTAINED WITH YOKE
FACE OF WALL MOUNTED - MOUNTED ON POND SIDE FACE OF NEW CONCRETE PUMP PIT
MANUAL HAND WHEEL OPERATED - HAND WHEEL MOUNTED TO YOKE
MAXIMUM LEAKAGE RATE OF .1 GALLONS PER MINUTE PER AWWA C-501

APPLICATION: DEWATERING POND PUMP PIT (WET WELL)
UPWARD ACTING GATE TO PROVIDE AN ADJUSTABLE WEIR HEIGHT
MAXIMUM HEAD OF LIQUID ON GATE: 5'-0" SEATING
MOUNTED ON POND SIDE FACE OF PUMP PIT
LIQUID: ABRASIVE SLURRY (WATER WITH 5% TO 15% SOLIDS PARTICLES)
SOLIDS PARTICLES: COMBINATION OF FLY ASK, BOTTOM ASH & GYPSUM PH: 9

MATERIAL: TYPE 304 STAINLESS STEEL, ASTM A-276 GATE, FRAME, RAILS, YOKE & STEM
TYPE 304 STAINLESS STEEL, ASTM A-593 FASTENERS (UHMW) ULTRA HIGH MOLECULAR WEIGHT POLYETHYLENE GUIDES, SLIDES OR SEATS
EPDM SEALS
MANUFACTURES STANDARD MATERIAL HAND WHEEL

INSTALLATION: STAINLESS STEEL ANCHORS AND GROUT BY OTHERS PER THE MANUFACTURERS DRAWINGS AND INSTRUCTIONS

DES. BY	03/20/03
CHK'D. BY	
APP'D. BY	
JOB NO.	(New Const)
REV'D BY	ORBITAL
FOR BID	

FOR BID

CAD FILENAME: 1x5434x01.dwg
Last Edit: Mar. 19, 2003

RECEIVED BY:	
W.C. WZ438AB-S	
DATE	

SIGNATURE: SEAN R. MARSHALL, P.E.
REGISTRATION NO. E-60212



DATE: _____

ORBITAL ENGINEERING, INC.
PITTSBURGH • CHICAGO • CLEVELAND • PHILADELPHIA
OAK BROOK • TOLEDO • CHARLESTON, WV • BIRMINGHAM

PROJECT 01-7796

DWG. NO.	1-5434-01
SCALE	1"=20'
BY	MJK
CHK'D. BY	S. MARSHALL
DATE	03/20/03
APP'D. BY	
GEN'D.	
NO. NO.	WZ438
JOB NO.	
STAND.	14

GENERAL ENGINEERING DEPARTMENT
THE CINCINNATI GAS & ELECTRIC COMPANY

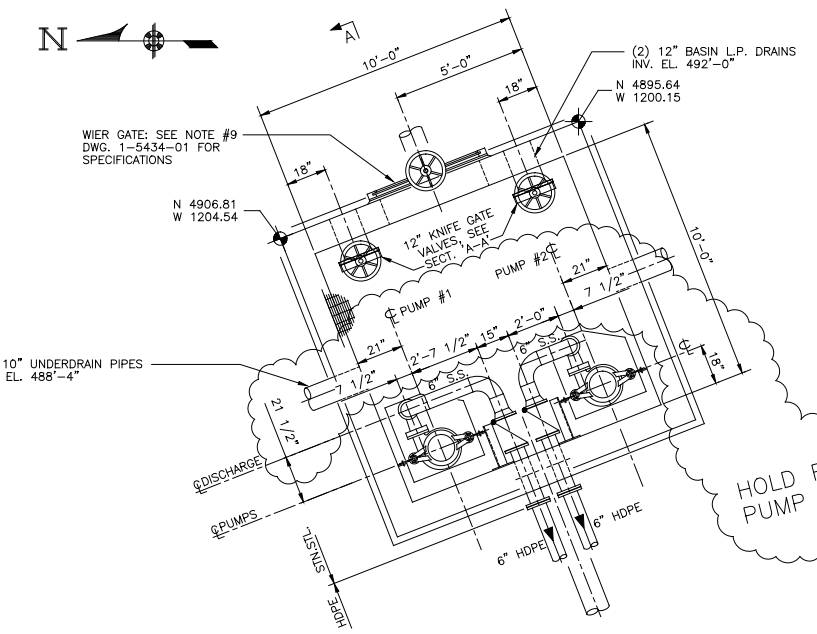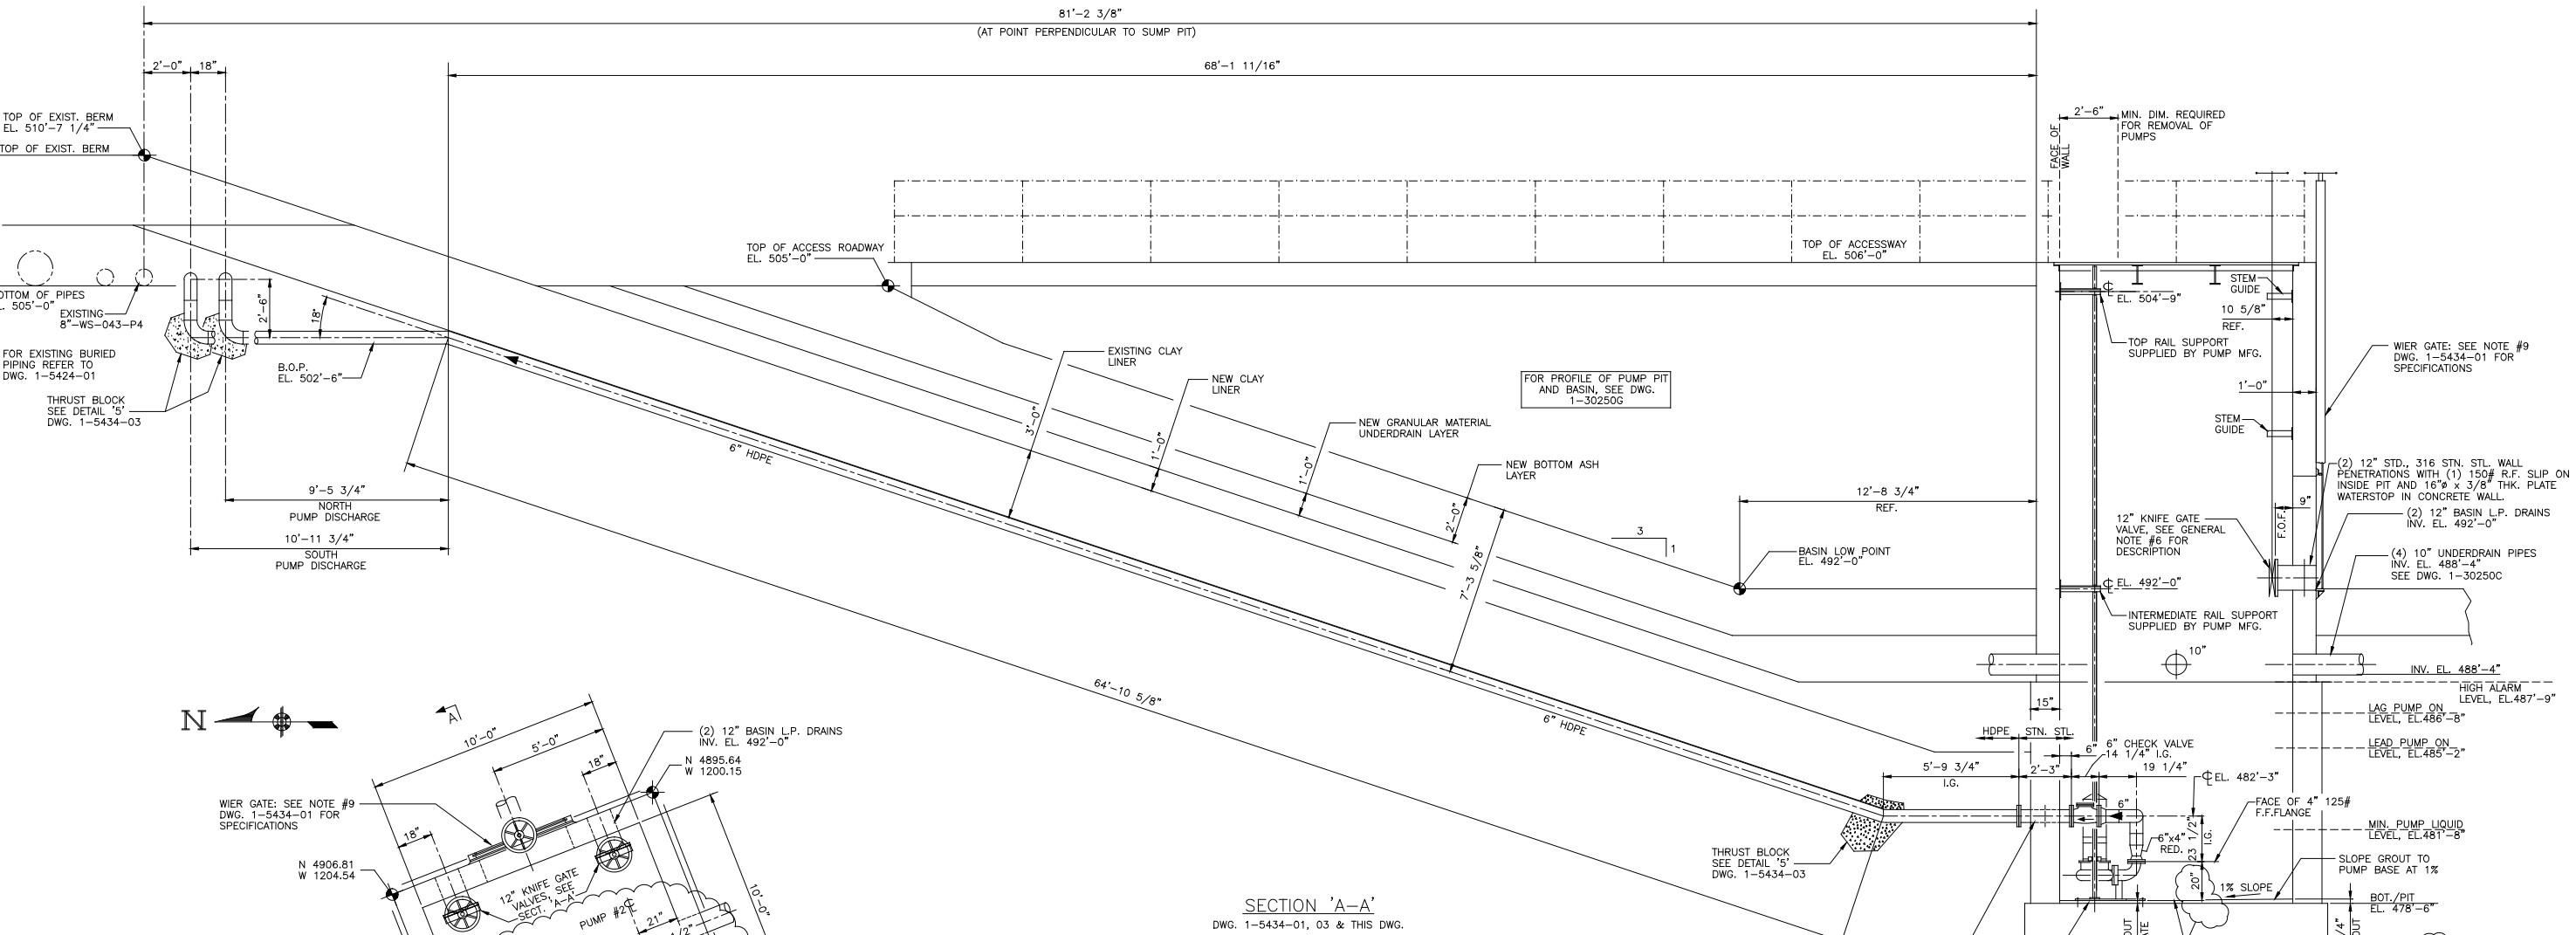

SECTION 'A-A'
DWG. 1-5434-01, 03 & THIS DWG.

HOLD FOR CERTIFIED PUMP DIMENSIONS

HOLD FOR CERTIFIED PUMP DIMENSIONS

- NOTES:**
1. WORK THIS DWG. WITH DWGS. 1-5434-01 & 03
 2. FOR GENERAL NOTES REFER TO DWG. 1-5434-01


FOR BID

DES. BY	03/20/03
CHK'D. BY	MLK
APP'D.	
JOB NO.	(New Const)
REV'D BY	ORBITAL
FOR BID	

REVISION


Last Edit: Mar. 20, 2003 CAD FILENAME: 1x5434x02.dwg

<p>RECEIVED BY: ORBITAL E&C W.C. WZ438AB-S DATE</p>		<p>WM. ZIMMER GENERATING STATION THE CINCINNATI GAS & ELECTRIC CO. COLUMBUS SOUTHERN POWER CO. THE DAYTON POWER AND LIGHT CO. OWNERS</p>	
<p>SIGNATURE SEAN R. MARSHALL, P.E. REGISTRATION NO. E-60212</p>		<p>COAL STORAGE AREA AND PONDS DEWATERING BASIN "D" PIPING SECT. A-A & DET.</p>	
<p>DATE</p>		<p>DWG. NO. 1-5434-02</p>	
<p>ORBITAL ENGINEERING, INC. PITTSBURGH • CHICAGO • CLEVELAND • PHILADELPHIA OAK BROOK • TOLEDO • CHARLESTON, WV • BIRMINGHAM</p>		<p>SCALE: 3/8"=1'-0" ENGINEER BY: MLK S. MARSHALL WZ438 CHK'D. BY: ORBITAL APPROVED BY: WZ438 DATE: 03/20/03 STAND: 14 GEN'D.</p>	
<p>PROJECT 01-7796 GENERAL ENGINEERING DEPARTMENT THE CINCINNATI GAS & ELECTRIC COMPANY</p>			

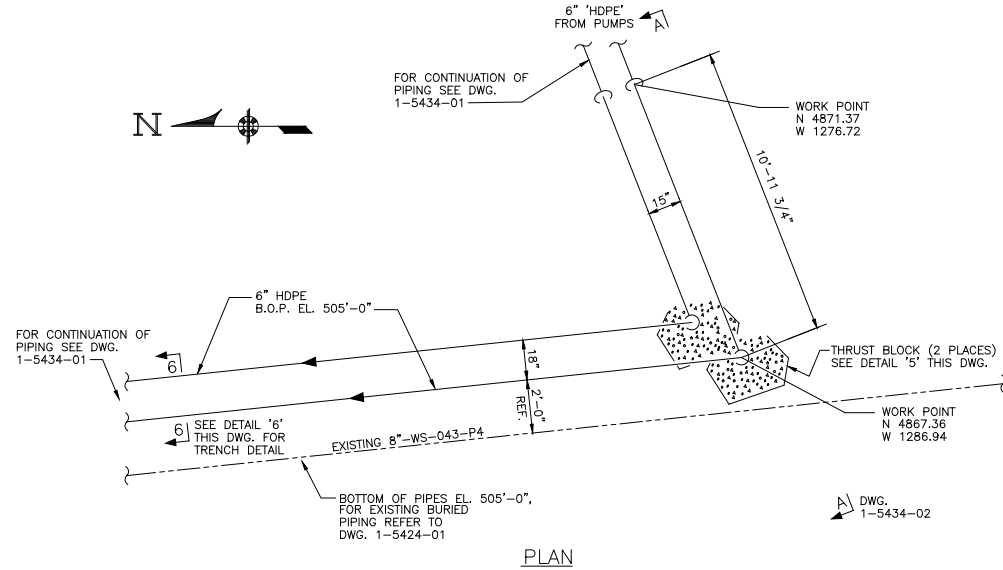


PLAN

DETAIL '2'
DWG. 1-5434-01

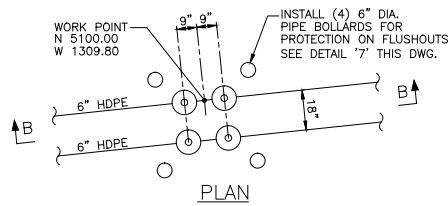


PLAN

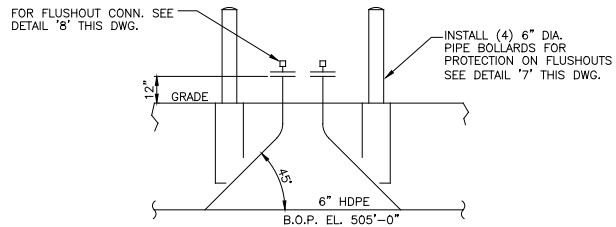


ELEVATION 'B-B'

DETAIL '4'
FLUSHOUT CONNECTIONS
DWG. 1-5434-01

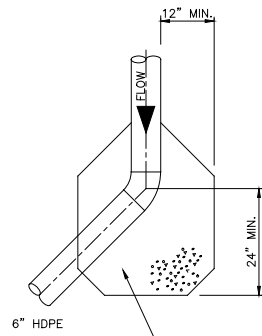


PLAN

DETAIL '5'
TYPICAL THRUST BLOCK DETAIL
(NOT TO SCALE)
DWG. 1-5434-02 & THIS DWG.

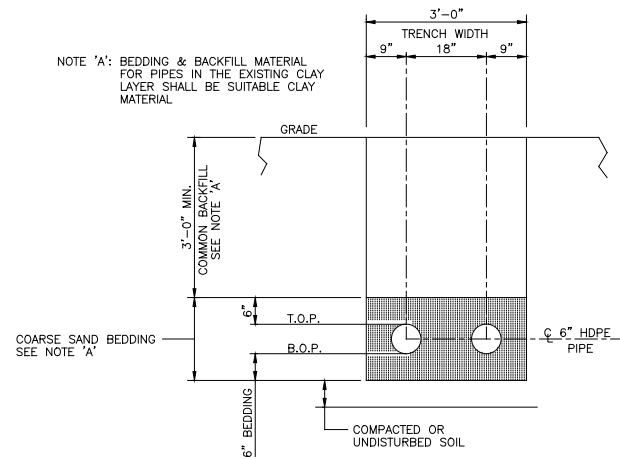


ELEVATION


DETAIL '6'
TRENCHING DETAIL
DWG. 1-5434-01 & 02
(NO SCALE)

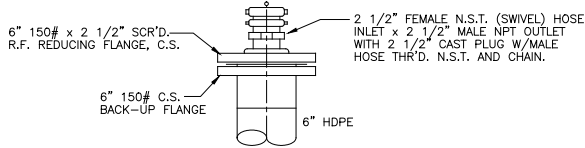

DETAIL '8'
HOSE CONNECTION
(4 PLACES)
NO SCALE
(SEE DETAIL '4')

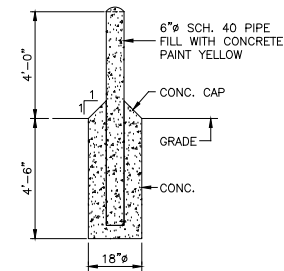

DETAIL '7'
BOLLARD
(AS INDICATED)
DWG. 1-5434-02

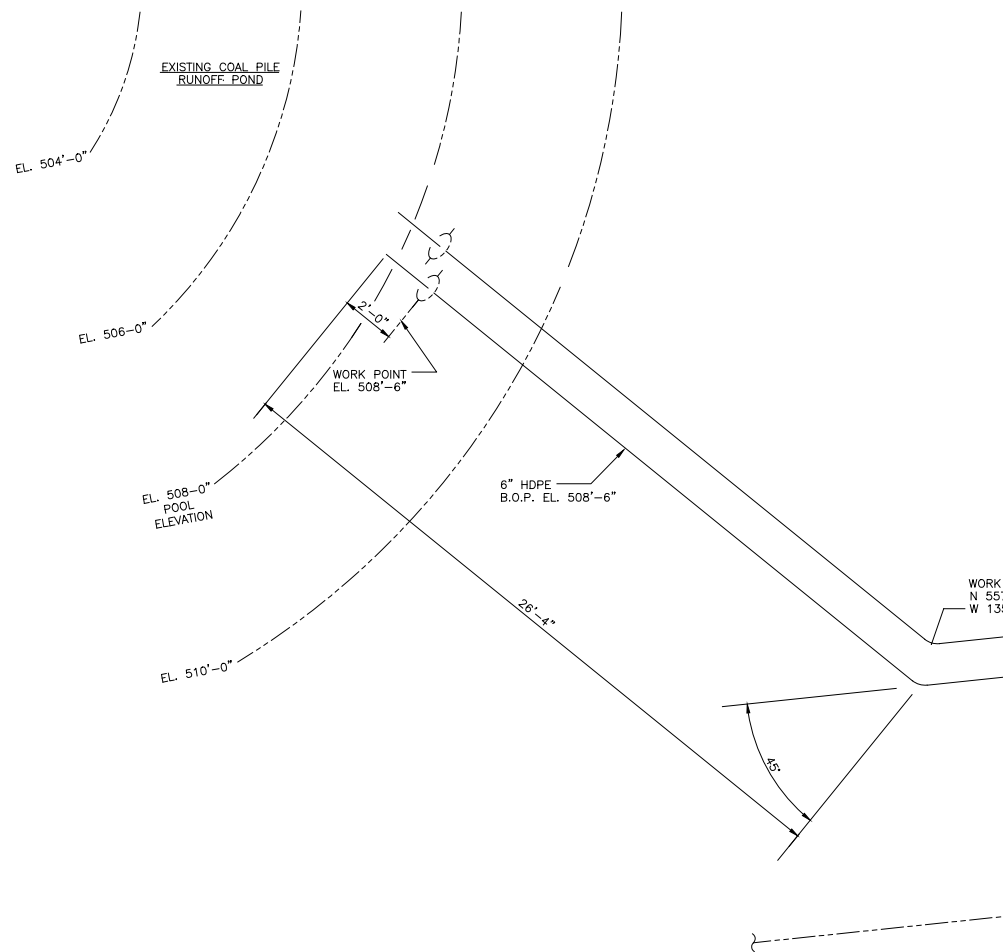

PLAN

DETAIL '3'
DWG. 1-5434-01

NOTES:

1. WORK THIS DWG. WITH DWGS. 1-5434-01 & 02
2. FOR GENERAL NOTES REFER TO DWG. 1-5434-01


FOR BID

REVISION
DES. BO. 03/20/03
CHK'D. BO. MJK
APP'D. BO. ...
JOB NO. (New Const) 1-5434-03
REV'D BY ORBITAL FOR BID

CAD FILENAME: 1x5434x03.dwg

Last Edit: Mar. 20, 2003

RECEIVED BY: W.C. WZ438AB-S DATE:		WM.ZIMMER GENERATING STATION THE CINCINNATI GAS & ELECTRIC CO. COLUMBUS SOUTHERN POWER CO. THE DAYTON POWER AND LIGHT CO. OWNERS	
SIGNATURE: SEAN R. MARSHALL, P.E. REGISTRATION NO. E-60212		DWG. NO. 1-5434-03 SCALE: 3/8"=1'-0" ENGINEER: S. MARSHALL JOB NO. WZ438	
ORBITAL ENGINEERING, INC. PITTSBURGH • CHICAGO • CLEVELAND • PHILADELPHIA OAK BROOK • TOLEDO • CHARLESTON, WV • BIRMINGHAM		CHECKED BY: MJK DATE: 03/20/03 APPROVED BY: [Signature] STAND. 14	
PROJECT 01-7796 GENERAL ENGINEERING DEPARTMENT THE CINCINNATI GAS & ELECTRIC COMPANY			

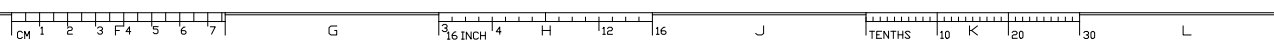


61-5434-03(1)




Appendix C: Zimmer Power Station Boring and Piezometer Locations

Images: ~ POB - Z-series.tif ~ POB and Cross-Sections - B Series_1.tif ~ WHZ Aerial of Plant.tif ~ ZIM-7 - As-Built Drawings W.DIM & EL.tif
 Xrefs:
 File Last Updated: Mar 11, 2015
 Plot Info: 3-11-2015 @ 12:53pm By: dverhulst
 S&ME Filename: Q:\Projects\7217-14-001\DIPLANS\7217-14-001D - Stability Analysis on Complex Embankments - 1-13-15.dwg Layout: Site Plan

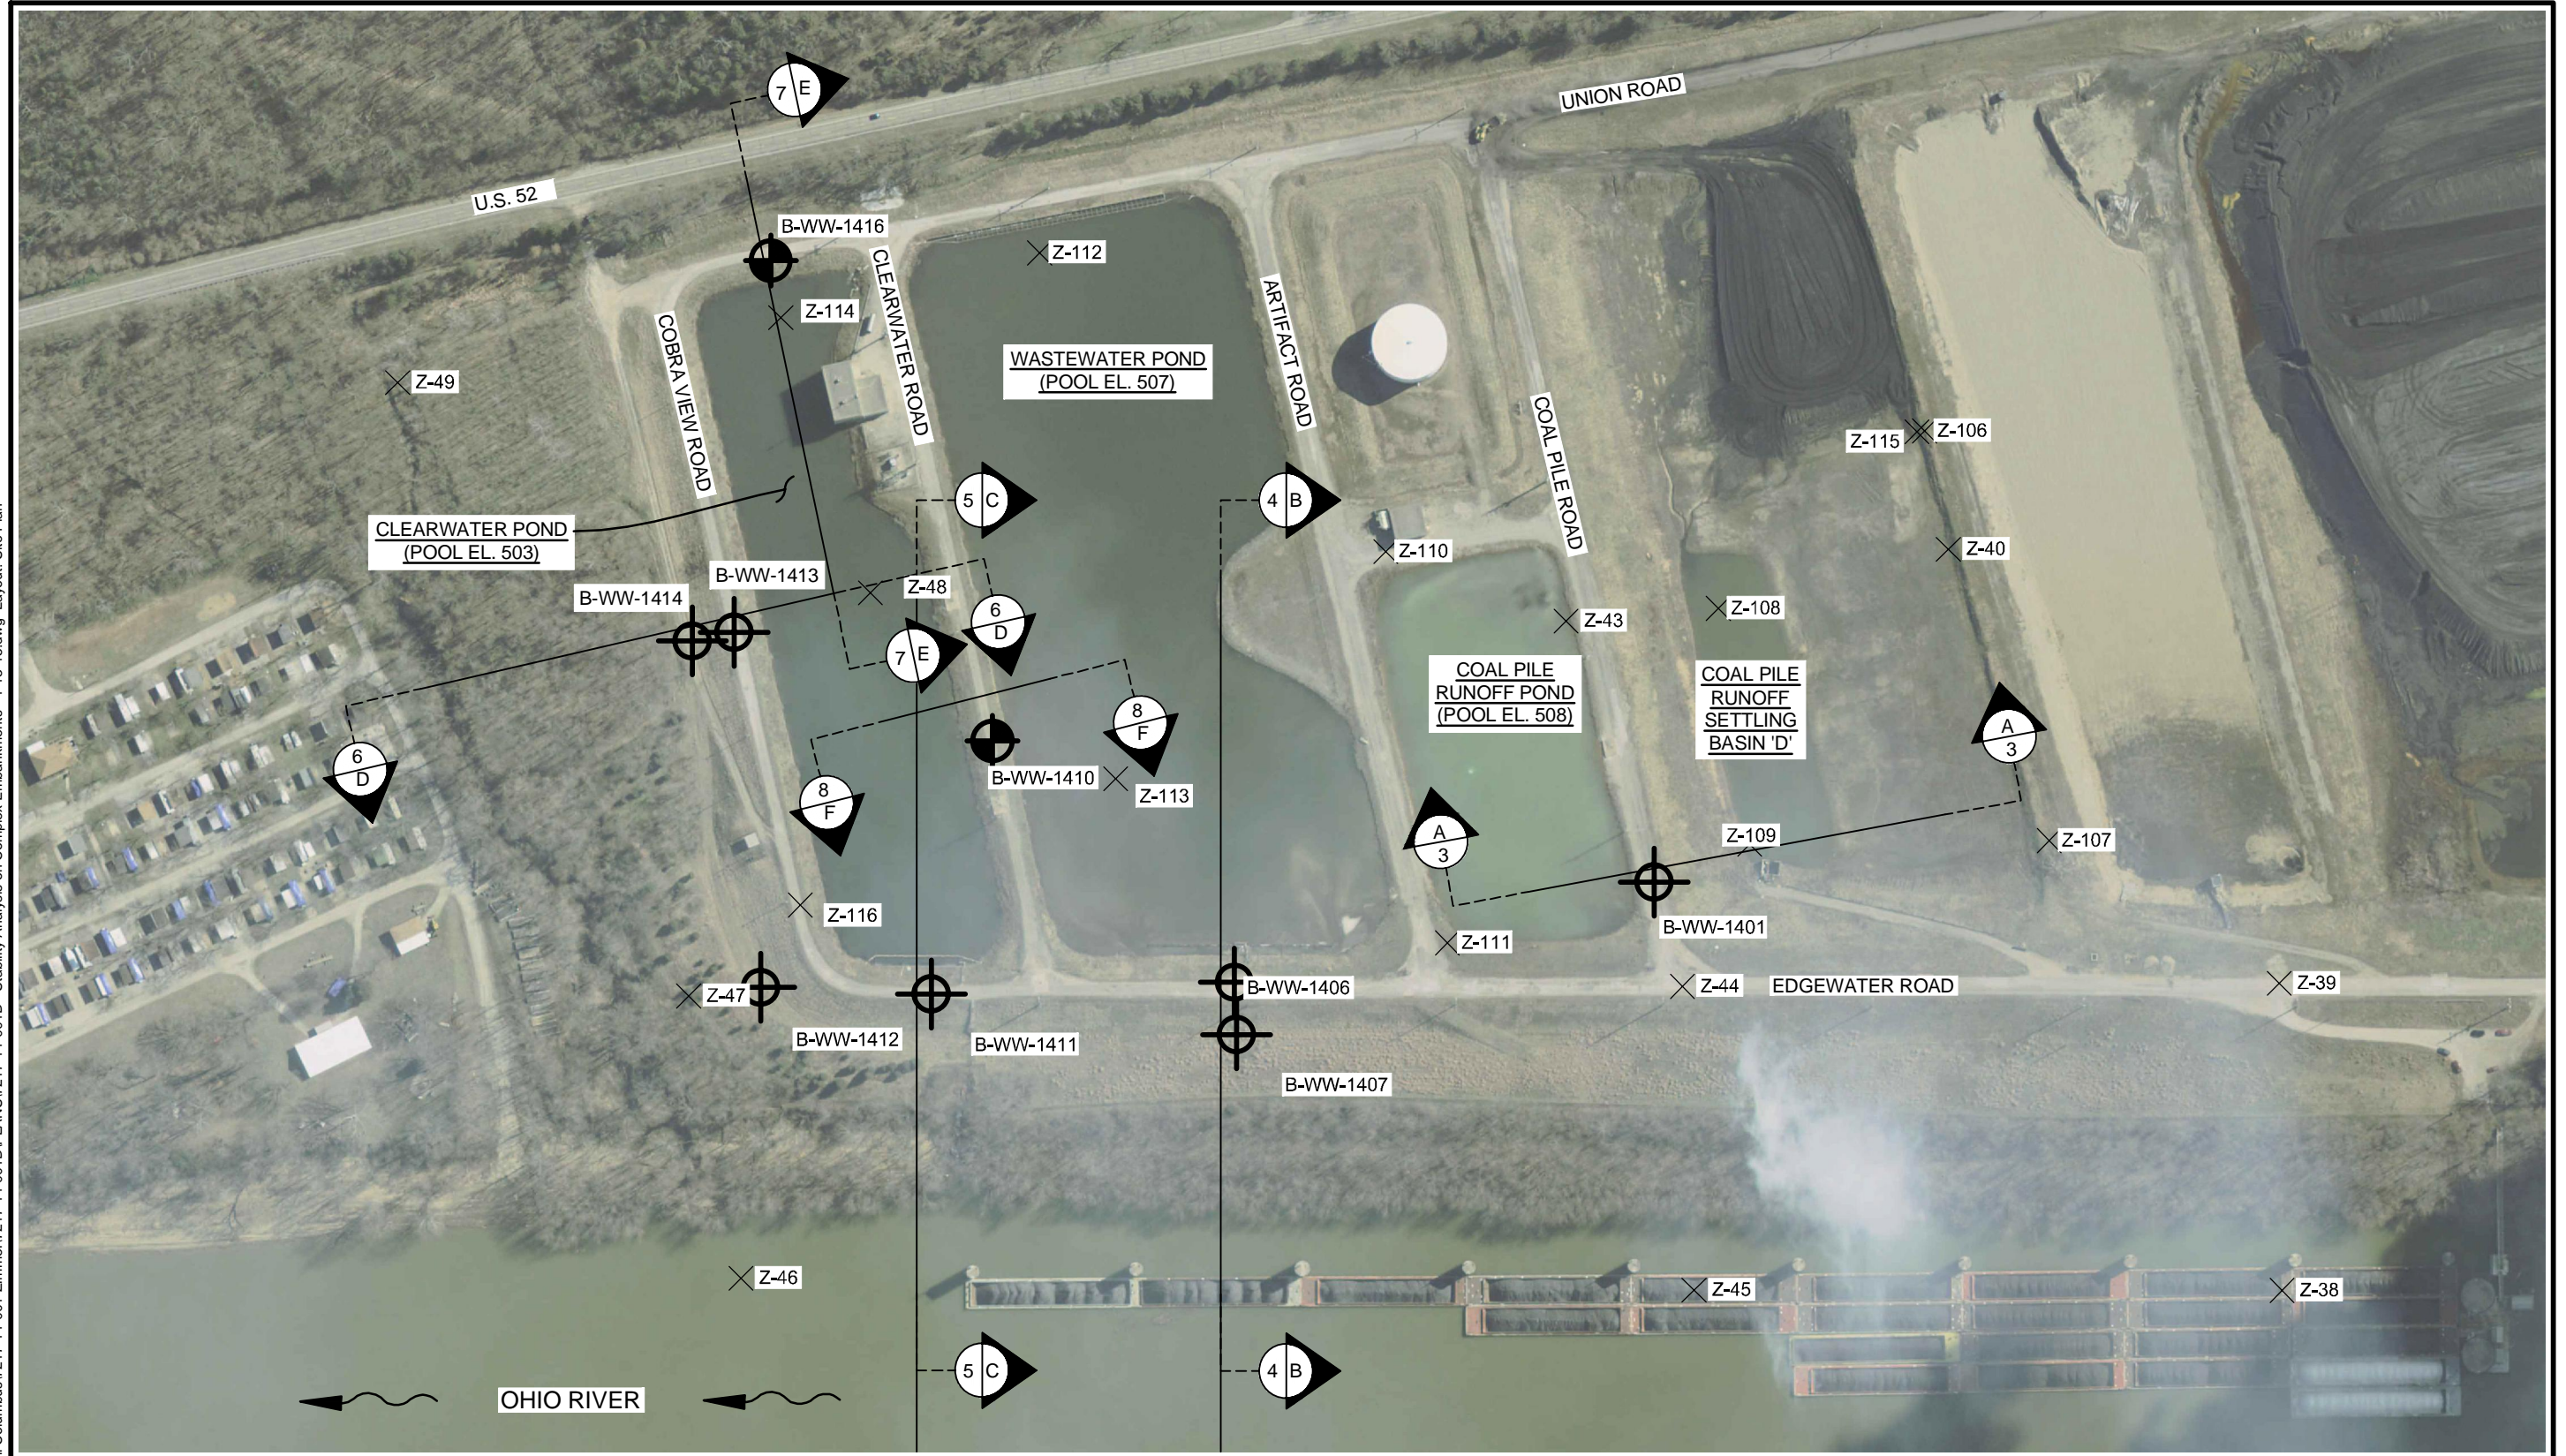

- LEGEND**
- B-WW-1401 PIEZOMETER INSTALLATION NUMBER AND LOCATION (2014)
 - B-WW-1404 BORING NUMBER AND LOCATION (2014)
 - CROSS SECTION LOCATION SECTION IDENTIFIER SECTION SHEET
 - Z-111 AEP AND H.C. NUTTING HISTORIC BORING, LOCATION IS APPROXIMATE (1985-1986)

NOTE: AERIAL IMAGERY SHOWN OBTAINED FROM 2012 OHIO STATE IMAGERY PROGRAM (OSIP), GROUND SURFACE CONTOURS FROM 2006/2007 OSIP LIDAR DATA.

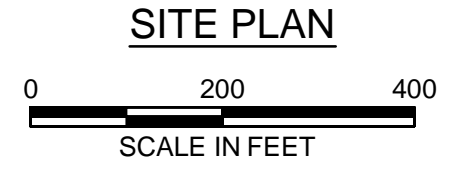

PLAN OF BORINGS AND CROSS SECTIONS			
DUKE ENERGY ZIMMER STATION ABSAT RESPONSE ZIM-7 CLERMONT COUNTY, OHIO			
Project: 7217-14-001D	Drawn By: DCV	 WWW.SMEINC.COM ENGINEERING FIRM. 03530	
Drawing Date: 1-15-2015	Approved By: JDR		
Last Updated: 3-11-2015	Scale: GRAPHIC		

File: P:\PROJECTS\GEOTECH\60428794_DYNEGY\CCR\DATASKS\00 PROGRAM TASKS\1.0 TASK 1 INITIAL ASSESSMENT\CCR FACT SHEETS\SITE MAPS\FIGURE 2A PIEZOMETER LOCATION PLAN (ZIMMER D BASIN).DWG Last edited: NOV. 03. 15 @ 5:05 p.m. by: david_dequire




EXPLORATION METHOD
(B=BORING, C=CPT,
P=PIEZOMETER)


XXX-X###
ID NUMBER


STATION ABBREVIATION

SOURCE:
MAP PROVIDED BY GOOGLE EARTH PRO 2015

LEGEND

 PIEZOMETER LOCATION

 CCR UNIT BERM ALIGNMENT

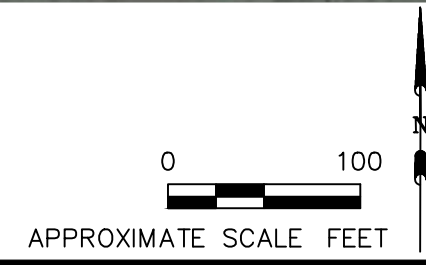

DYNEGY, INC		PROJECT NO. 60440139
AECOM		
DRN. BY:djd October 2015 DSGN. BY:eg CHKD. BY:eg	Zimmer D Basin Piezometer Locations	FIG. NO. 2A