



REPORT

HISTORY OF CONSTRUCTION ADDENDUM NO. 1

*Martin Lake Steam Electric Station - Ash Ponds
Rusk County, Texas*

Submitted to:

Luminant Generation Company LLC


Submitted by:

WSP GOLDER

1601 S MoPac Expressway
Suite 325D
Austin, Texas, USA 78746
+1 737 703 3900


31404097.007

December 2022

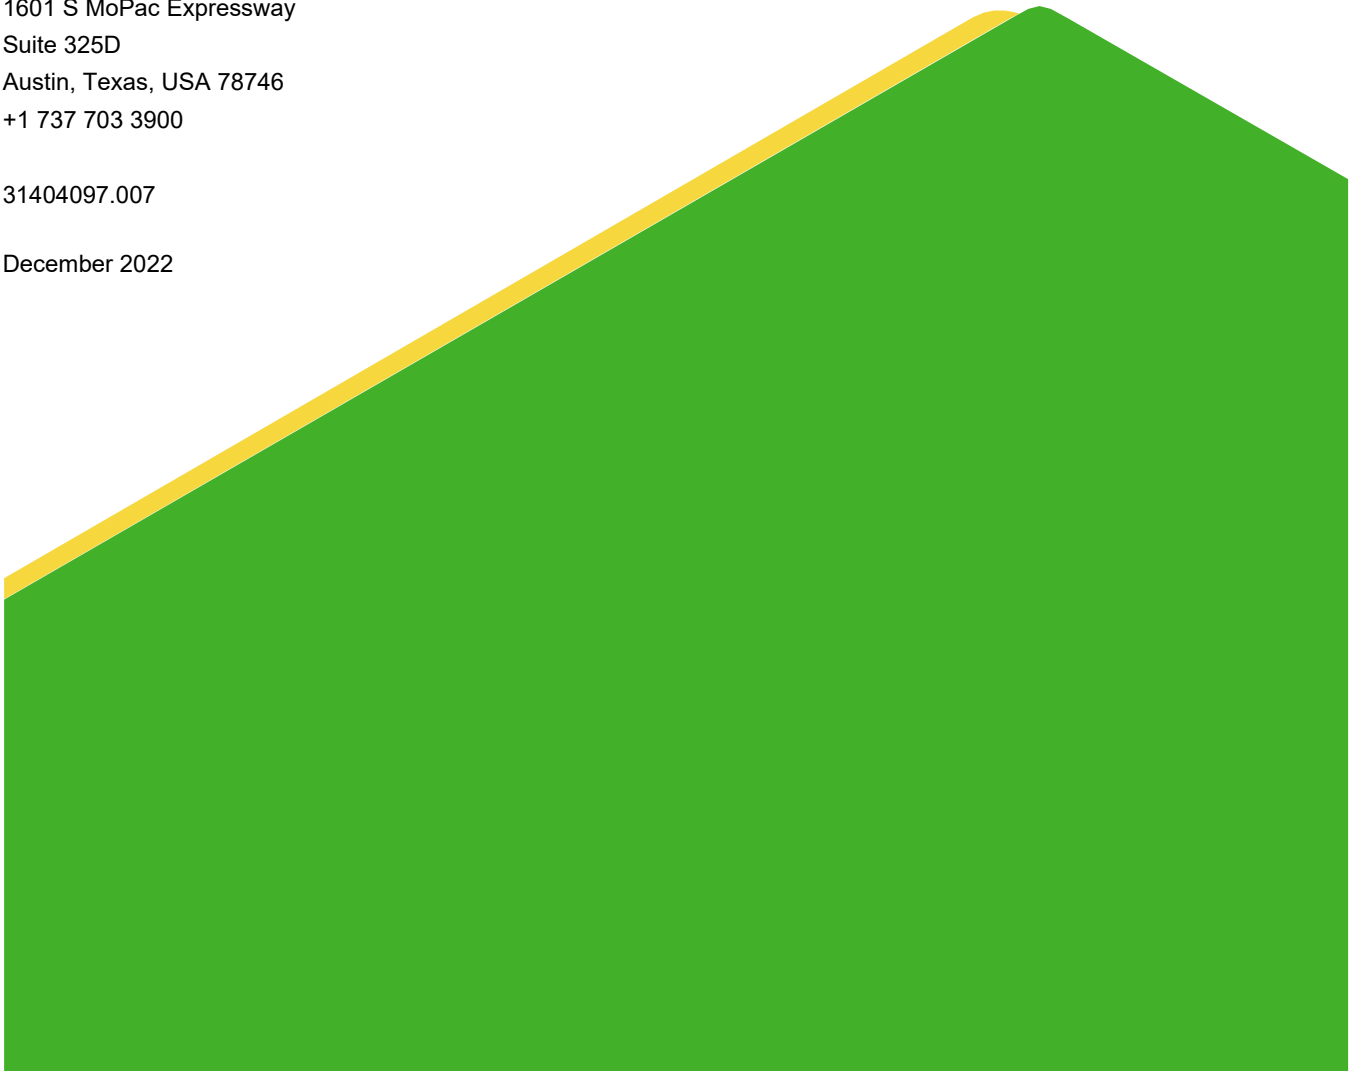

PROFESSIONAL CERTIFICATION

This document and all attachments were prepared by WSP Golder under my direction or supervision in accordance with a system designed to assure that qualified personnel properly gather and evaluate the information submitted. Based on my inquiry of those persons directly responsible for gathering the information, the information submitted is, to the best of my knowledge and belief, true, accurate, and complete. I hereby certify that Addendum No.1 to the History of Construction Report for the Ash Ponds at the Martin Lake Steam Electric Station has been prepared in accordance with the requirements of 40 C.F.R. §257.73(c).

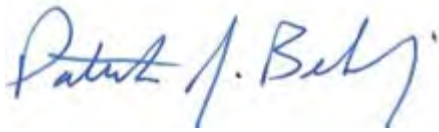

Patrick J. Behling, P.E.
Principal Engineer
WSP Golder
Texas Firm Registration No. 22771



Table of Contents

DOCUMENT REVISION RECORD ii

1.0 INTRODUCTION 1

2.0 RETROFIT OF ASH POND LINER SYSTEMS 2

3.0 REFERENCES 3

APPENDICES

Appendix A EAP, WAP and NSP Liner Retrofits – Engineering Drawings

Appendix B EAP and WAP Liner Retrofits – As-Built Drawings

DOCUMENT REVISION RECORD

Issue No.	Date	Details of Revisions
Revision 0	October 2016	Original Document
Addendum 1	December 2022	Added retrofitted EAP, WAP and NSP liner system information

1.0 INTRODUCTION

On behalf of Luminant Generation Company LLC (Luminant), WSP Golder (Golder) has prepared this Addendum No. 1 to the History of Construction Report (HCR) for East Ash Pond (EAP), West Ash Pond (WAP), and New Scrubber Pond (NSP) (collectively referred to as the “Ash Ponds”) located at the Martin Lake Steam Electric Station (MLSES) in Rusk County, Texas (hereafter, the “Site”). Coal Combustion Residuals (CCR) including flue gas desulfurization (FGD) wastewater and bottom ash generated as part of MLSES operation are managed in the Ash Ponds. The Ash Ponds are regulated as Existing CCR Impoundments under 40 C.F.R. §257, Subpart D (the “CCR Rule”).

The original HCR for the Site was prepared in October 2016 in accordance with 40 C.F.R. §257.73(c) and placed in the MLSES operating record in accordance with 40 C.F.R. §257.105(h)(10) (B&M, 2016a). This Addendum No. 1 updates the HCR to reflect the following:

- Retrofit of the EAP, WAP and NSP liner systems to comply with the requirements of 40 C.F.R. §257.71(a)(1)(ii) completed in accordance 40 C.F.R. §257.102(k).

2.0 RETROFIT OF ASH POND LINER SYSTEMS

The EAP, WAP and NSP are constructed partially above and partially below grade and are surrounded by engineered earthen dikes that extend above surrounding ground level. The EAP and WAP share an interior embankment and cover areas of approximately 10 acres and 15 acres, respectively. The NSP is an approximately 13 acre surface impoundment.

At the time the CCR Rule was promulgated, the liner systems in the EAP, WAP and NSP consisted of the following (from bottom to top):

- 18-inch thick compacted clay layer with a hydraulic conductivity of 1×10^{-7} cm/sec;
- a 60-mil HDPE geomembrane;
- a geosynthetic drainage layer;
- a second 60-mil HDPE geomembrane; and
- a 4-inch thick concrete revetment mat.

The EAP, WAP and NSP were considered unlined CCR surface impoundments in accordance with 40 C.F.R. §257.71(a)(1) of the CCR Rule (B&M, 2016b). Luminant decided to retrofit the Ash Pond liner systems to satisfy the requirements of 40 C.F.R. §257.71(a)(1)(ii) and maintain compliance with the CCR Rule. A Liner Retrofit Plan for the Ash Ponds were prepared in February 2020 in accordance with 40 C.F.R. §257.102(k)(2) and placed in the MLSES operating record in accordance with 40 C.F.R. §257.105(h)(10) (HDR, 2020). The Ash Pond liner systems were retrofitted sequentially, starting with the EAP, followed by the WAP and finally the NSP.

The liner system retrofit measures for each of the Ash Ponds consisted of the following.

- Pumping of free water from the pond and transfer to one of the other Ash Ponds;
- Excavation of all CCR from the pond and placement in MLSES A1 Landfill; and
- Construction of an alternative composite liner system meeting the requirements of 40 C.F.R. §257.71(a)(1)(ii).

In each impoundment, the retrofitted liner system was installed on top of the existing liner system and consisted of the following (from bottom to top):

- a 6-inch thick layer of general soil fill material placed over the existing liner system;
- a polymer-enhanced geosynthetic clay liner (GCL); and
- a 60-mil HDPE geomembrane.

From 2020 through 2022, the EAP and WAP were each retrofitted with a new composite liner system and a similar composite liner system is currently being installed in the NSP. Engineering drawings for the EAP, WAP and NSP Liner Retrofits are reproduced in Appendix A of this Addendum. As-built drawings for the EAP and WAP Liner Retrofits are reproduced in Appendix B of this Addendum.

The retrofitted liner systems in the EAP, WAP and NSP are alternative composite liners meeting the requirements of 40 C.F.R. §257.71(a)(1)(ii).

3.0 REFERENCES

Burns and McDonnell (B&M), 2016a. History of Construction – CCR Surface Impoundments, Martin Lake Steam Electric Station. October 5.

B&M, 2016b. Summary of Liner Construction – Martin Lake Impoundments, Martin Lake Steam Electric Station. September 16.

HDR, 2020. Retrofit Plan for Ash Pond Area – East ASH Pond, West Ash Pond and New Scrubber Pond, Martin Lake Steam Electric Station. February 28.

APPENDIX A

Ash Pond Liner Retrofits Engineering Drawings



HDR
 Firm Registration No. F-754
 17111 Preston Road, Suite 300
 Dallas, Texas 75248-1229
 972.960.4400



VICINITY MAP
 NOT TO SCALE

Construction Drawings For

Martin Lake Steam Electric Station

CCR Impoundment Reline East Ash Pond

Project No.
 10172630

Rusk County, Texas
 January 2020

INDEX OF DRAWINGS

GENERAL	
00G-01	COVER SHEET
00G-02	ABBREVIATIONS AND GENERAL NOTES
CIVIL	
00C-01	SITE LAYOUT
00C-02	EAST ASH POND
00C-03	CROSS SECTIONS
00C-04	DETAILS (1 OF 2)
00C-05	DETAILS (2 OF 2)
00C-06	EXISTING YARD PIPING
00C-07	MODIFIED YARD PIPING
00C-08	YARD PIPING CONNECTIONS AND DETAILS
00C-09	YARD PIPING CONNECTIONS AND DETAILS
00C-10	YARD PIPING DETAILS
00C-11	STOCKPILE AND HAUL ROUTE




STANDARD ABBREVIATIONS

& APPROX	AND APPROXIMATELY	NTS	NOT TO SCALE
@	AT	NTYS	NORTH THICKENER YARD SUMP
AVG	AVERAGE	OC	ON CENTER
BOE	BOTTOM OF EXCAVATION	OZ	OUNCE
BOL	BOTTOM OF LINER	%	PERCENT
X	BY	PLCP	PERFORATED LEACHATE COLLECTION PIPE
CL	CENTERLINE	PERF	PERFORATED
CMP	CORRUGATED METAL PIPE	PGL	PROFILE GRADE LINE
CO	CLEAN OUT	PDP	PERMANENT DISPOSAL POND
CY	CUBIC YARD	PC	POINT OF CURVATURE
DIA	DIAMETER	PVI	POINT OF INTERSECTION
DET	DETAIL	PT	POINT OF TANGENT INTERSECTION
DWG	DRAWING	PZ	PIEZOMETER
E	EAST	Q	FLOW
EAP	EAST ASH POND	QTY	QUANTITY
ELEV	ELEVATION	R	RADIUS
EW	EACH WAY	RCP	REINFORCED CONCRETE PIPE
EXIST	EXISTING	REF	REFERENCE
EXC	EXCAVATION	REQ	REQUIRED
FGD	FLUE GAS DESULFICATION	RD	ROAD
FML	FLEXIBLE MEMBRANE LINER	SCH	SCHEDULE
FT	FEET	SDL	SAND DRAINAGE LAYER
GAL	GALLON	SEC	SECTION
GND	GROUND	SHT	SHEET
GDL	GRAVEL DRAINAGE LAYER	S	SOUTH
GNDL	GEONET DRAINAGE LAYER	SDR	STANDARD DIMENSION RATIO
HDPE	HIGH DENSITY POLYETHYLENE	SLQCP	SOIL LINER QUALITY CONTROL PLAN
HORIZ	HORIZONTAL	SP	STEEL PIPE
ID	INSIDE DIAMETER	SQ	SQUARE
IN	INCHES	SS	SIDE SLOPE
IE	INVERT ELEVATION	STA	STATION
LCSRS	LEACHATE COLLECTION AND REMOVAL SYSTEM	STYS	SOUTH THICKENER SECTION
LCS	LEACHATE COLLECTION SYSTEM	T.A.S.	TERMINAL ANCHOR SECTION
LCP	LEACHATE COLLECTION PIPE	TL	TANGENT LENGTH
LCPR	LEACHATE COLLECTION PIPE RISER	TOC	TOP OF COVER
LF	LINEAR FEET	TOF	TOP OF FINAL COVER
LB	LOAD	TOL	TOP OF LINER
MH	MANHOLE	TOS	TOE OF SLOPE
MAX	MAXIMUM	TS	TOP SLOPE
ML	MINIMUM	TEMP	TEMPORARY
MIN	MINIMUM	TYP	TYPICAL
MW	MONITOR WELL	UNO	UNLESS NOTED OTHERWISE
MLSES	MARTIN LAKE STEAM ELECTRIC STATION	VERT	VERTICAL
MSL	MEAN SEA LEVEL	W	WEST
N	NORTH	W/	WITH
NIC	NOT IN CONTRACT	WAP	WEST ASH POND
NO	NUMBER	WW	WESTWELL
		YD	YARD


SYMBOLS

SECTION DETAIL INDICATORS


DRAWING ON WHICH SECTION IS CUT:

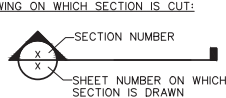




DRAWING ON WHICH SECTION APPEARS:

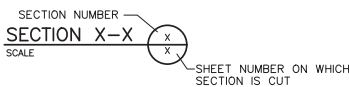


DRAWING ON WHICH DETAIL IS INDICATED:

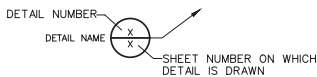


DRAWING ON WHICH DETAIL APPEARS:

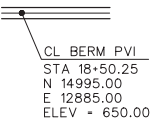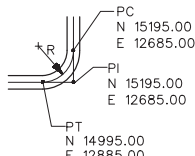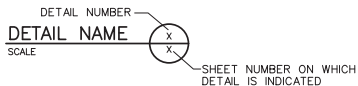

CURVE WITH HORIZONTAL CONTROL:

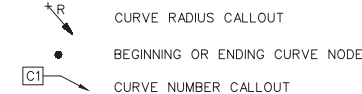

VERTICAL CONTROL DESIGNATION

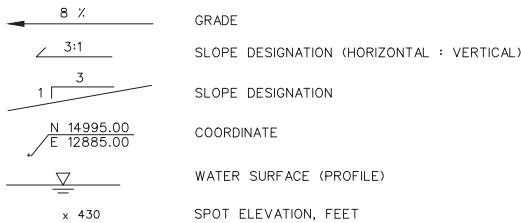

CONSTRUCTION SEQUENCE

- A. CONTRACTOR SHALL REMOVE EXISTING COR MATERIAL, ROCKS AND SEDIMENT FROM THE EAP, HAUL AND STOCKPILE IT AT THE BECANT BASIN. LUMINANT WILL LOAD THE STOCKPILED MATERIAL ONTO RAIL CARS FOR DISPOSAL AT THE MARTIN LAKE #1 AREA LANDFILL.
- B. CONTRACTOR SHALL USE WATER FROM THE ADJACENT WEST ASH POND (WAP) OR NEW SCRUBBER POND (SP) TO WASH REMAINING COR MATERIAL OFF THE SIDES AND FLOOR OF THE CAP AND REMOVE IT. EAP WILL BE VISUALLY INSPECTED BY OWNER'S COA CONSULTANT TO CONFIRM COR MATERIAL, ROCKS, AND SEDIMENT HAVE BEEN REMOVED.
- C. CONTRACTOR SHALL MODIFY THE EXISTING 48-INCH SECTION LINE ON THE SOUTH END OF THE POND BY INCREASING THE SCREENED AREA AS SHOWN IN THE PLANS.
- D. CONTRACTOR SHALL LOAD AND HAUL GENERAL SOIL FILL MATERIAL FROM THE OWNER'S STOCKPILE LOCATED AT LIBERTY MINE, A LOCATION UNDER THE PROVISIONS OF THE MINE SAFETY AND HEALTH ADMINISTRATION (MSHA) AND APPROXIMATELY 4.5 MILES FROM EAP.
- E. CONTRACTOR SHALL PLACE THE GENERAL FILL MATERIAL OVER THE EXISTING CONCRETE RETEMENT TO A DEPTH OF AT LEAST SIX (6) INCHES, NOMINALLY COMPACT, AND SMOOTH ROLL TO FINISH THE INSTALLATION.
- F. CONTRACTOR SHALL INSTALL A GEOSYNTHETIC CLAY LINER (GCL) OVER THE SIDES AND FLOOR OF THE EAP AND SECURE IT IN A PERIMETER ANCHOR TRENCH/BATTEN AND STRIP.
- G. CONTRACTOR SHALL INSTALL A 60-ML HDPE LINER DIRECTLY ON THE GCL AND SECURE IT IN A PERIMETER ANCHOR TRENCH/BATTEN AND STRIP.
- H. CONTRACTOR SHALL INSTALL 12-INCH HDPE YARD PIPE AS SHOWN IN THE PLANS.

GENERAL NOTES

1. ALL WORK UNDER THIS CONTRACT SHALL BE PERFORMED IN ACCORDANCE WITH THE PLANS AND PROJECT SPECIFICATIONS. IN THE EVENT OF A DISCREPANCY BETWEEN THE PLANS AND THE PROJECT SPECIFICATIONS, THE SPECIFICATIONS SHALL GOVERN.
2. COORDINATE SYSTEM IS BASED ON LOCAL SURVEY. THE BENCHMARKS TO BE USED FOR CONSTRUCTION ARE LOCATED AS SHOWN ON DRAWING NO. 00G-01. EXISTING CONTOURS ARE BASED ON TOPOGRAPHICAL SURVEY PERFORMED FEBRUARY 12, 2019 BY LACY SURVEYING. CURRENT GROUND ELEVATIONS MAY VARY FROM THOSE SHOWN DUE TO SITE WORK THAT HAS BEEN PERFORMED SINCE THE SURVEY WAS PERFORMED.
3. THE CONTRACTOR SHALL VERIFY EXISTING CONTOURS PRIOR TO THE START OF WORK.
4. THERE SHALL NOT BE ANY ADDITIONAL PAYMENT OR EXTENSION OF CONTRACT TIME FOR WORKING WITH SATURATED SOILS OR HANDLING WATER SEEPAGE DUE TO RAINFALL, RUNOFF AND INFILTRATION.
5. THE CONTRACTOR SHALL TAKE ALL NECESSARY PRECAUTIONS TO PROTECT EXISTING ROADS, BENCHMARKS AND EXISTING GROUNDWATER MONITOR WELLS DURING THE CONSTRUCTION PERIOD. THE CONTRACTOR SHALL BE SOLELY RESPONSIBLE FOR ANY AND ALL DAMAGES WHICH MIGHT BE INCURRED BY THE CONTRACTOR'S FAILURE TO EXACTLY LOCATE AND PROTECT THE GROUNDWATER MONITOR WELLS, BENCHMARKS AND EXISTING ROADS.
6. THE LOCATIONS OF EXISTING UNDERGROUND UTILITIES HAVE NOT BEEN ESTABLISHED BY THE OWNER OR ENGINEER. THE CONTRACTOR SHALL DETERMINE THE EXACT LOCATION OF ALL EXISTING UTILITIES BEFORE COMMENCING WORK, AND AGREES TO BE FULLY RESPONSIBLE FOR ANY AND ALL DAMAGES WHICH MIGHT BE OCCURRED BY THE CONTRACTOR'S FAILURE TO EXACTLY LOCATE AND PRESERVE ANY AND ALL UTILITIES. THE CONTRACTOR SHALL BE RESPONSIBLE FOR MAINTAINING PROPER SAFE WORKING DISTANCE FROM ALL UTILITY EASEMENTS OR LINES.
7. EXCAVATION BY "BLASTING" IS NOT PERMITTED ON THIS PROJECT.
8. FINISHED GROUND ELEVATIONS SHALL MATCH EXISTING GROUND ELEVATIONS EXCEPT AS SHOWN ON THE PLANS. ALL EXCESS SOIL FROM THE EXCAVATION AND GRADING SHALL BE PLACED IN DESIGNATED STOCKPILE LOCATIONS AS APPROVED BY THE OWNER. IF WASTE IS ENCOUNTERED DURING EXCAVATION, THE OWNER SHALL BE NOTIFIED AND THE WASTE REMOVED AND PLACED IN AREAS DESIGNATED AS APPROVED BY THE OWNER. TRANSPORT OF SOIL TO FILL AREAS SHALL BE CONDUCTED BY THE CONTRACTOR AT NO ADDITIONAL EXPENSE TO THE OWNER.
9. GEOTECHNICAL INVESTIGATION REPORTS FOR THE SITE ARE AVAILABLE FOR REVIEW AT LUMINANT'S DALLAS OFFICES. THE CONTRACTOR MAY PERFORM ADDITIONAL GEOTECHNICAL INVESTIGATIONS, AS DEEMED NECESSARY FOR CONSTRUCTION ACTIVITIES. PROVIDED ALL NECESSARY PERMITS AND APPROVALS ARE OBTAINED FROM LUMINANT PRIOR TO INITIATING SUCH WORK, HOWEVER, THERE SHALL BE NO ADDITIONAL PAYMENT TO THE CONTRACTOR FOR ADDITIONAL GEOTECHNICAL INVESTIGATIONS.
10. THE CONTRACTOR SHALL CONSTRUCT, AND UPON COMPLETION OF THE PROJECT, REMOVE TEMPORARY CONSTRUCTION ACCESS ROADS. SUCH ROADS SHALL BE LOCATED AS APPROVED BY THE OWNER. DRAINAGE PATTERNS AT THE SITE SHALL NOT BE ALTERED BY ROAD CONSTRUCTION. THE CONTRACTOR SHALL BE RESPONSIBLE FOR CONSTRUCTION AND MAINTENANCE OF TEMPORARY DRAINAGE STRUCTURES, INCLUDING CULVERTS, AT NO ADDITIONAL COST TO THE OWNER.
11. THE CONTRACTOR SHALL INSTALL, MAINTAIN, AND UPON COMPLETION OF THE PROJECT, REMOVE TEMPORARY EROSION AND SEDIMENT CONTROLS AS APPROVED BY LUMINANT ENVIRONMENTAL SERVICES AND IN ACCORDANCE WITH THE SITE SWPPP AND PURSUANT TO TPDES REQUIREMENTS. SUCH CONTROLS SHALL BE PLACED AT THE LIMITS OF DISTURBED AREAS AND AT INTERMEDIATE LOCATIONS WHERE CONCENTRATED FLOW IS LIKELY.
12. TEMPORARY CONSTRUCTION SLOPES SHALL NOT BE GREATER THAN 2H:1V. STEEPER SLOPES WILL ONLY BE ALLOWED IF THE CONTRACTOR PROVIDES A GEOTECHNICAL ENGINEERING REPORT SPECIFYING MAXIMUM SLOPES AND THE DURATION FOR WHICH SUCH SLOPES SHALL REMAIN IN PLACE.
13. THE CONTRACTOR SHALL REMOVE ALL VEGETATION WITHIN THE CONSTRUCTION LIMITS AS REQUIRED TO CONSTRUCT THE PROJECT. ALL VEGETATION SHALL BE REMOVED BY CONTRACTOR AT NO ADDITIONAL EXPENSE TO OWNER.
14. THE CONTRACTOR SHALL OBTAIN AND CONDUCT WORK CONSISTENT WITH A TPDES PERMIT FOR CONSTRUCTION, REFER TO TECHNICAL SPECIFICATIONS. PREPARATION OF A SWPPP AND OBTAINING THE TPDES PERMIT ARE THE CONTRACTOR'S RESPONSIBILITY.
15. THE CONTRACTOR SHALL IMMEDIATELY REPORT TO THE ENGINEER ANY ERROR OR DISCREPANCY FOUND ONCE THE CONTRACT DOCUMENT IS CAREFULLY REVIEWED AND ALL ASPECTS OF FIELD WORK HAVE BEEN VERIFIED. IN THE EVENT THE CONTRACTOR CONTINUES TO WORK ON AN ITEM WHERE AN ERROR EXISTS, IT SHALL BE DEEMED THAT THE CONTRACTOR BID AND INTENDED TO EXECUTE THE MORE STRINGENT OR HIGHER QUALITY REQUIREMENT WITHOUT AN INCREASE IN CONTRACT SUM OR TIME. THE CONTRACTOR SHALL ALSO BE RESPONSIBLE TO CORRECT ANY FAILURE OF COMPANY PARTS TO COORDINATE OR FIT PROPERLY INTO FINAL POSITION, AS A RESULT OF CONTRACTOR FAILURE TO RAISE OR RESOLVE A DISCREPANCY.
16. THE DRAWINGS AND SPECIFICATIONS SHOULD AGREE WITH EACH OTHER, AND WORK CALLED FOR BY DRAWINGS AND NOT MENTIONED IN SPECIFICATIONS OR VICE VERSA SHALL BE FURNISHED BY BOTH. WHEN DISCREPANCIES EXIST BETWEEN SCALE AND DIMENSIONS, THE DIMENSIONED FIGURE SHALL BE USED.
17. CONTRACTOR AND EACH SUBCONTRACTOR SHALL VERIFY ALL GRADES, LINES, LEVELS, AND DIMENSIONS AS INDICATED ON DRAWINGS, AND HE SHALL REPORT ERRORS TO THE ENGINEER BEFORE COMMENCING WORK. THE CONTRACTOR SHALL ESTABLISH BENCHMARKS IN AT LEAST TWO WIDELY SEPARATED PLACES, AND AS WORK PROGRESSES THE CONTRACTOR WILL MAINTAIN ADEQUATE HORIZONTAL AND VERTICAL CONTROL.
18. CONTRACTOR SHALL PROVIDE EROSION CONTROL BY SEEDING FOR ALL AREAS DISTURBED BY CONTRACTOR DURING THE CONSTRUCTION OF THIS PROJECT. THE CONTRACTOR SHALL NOT DISTURB ANY AREA WITHOUT THE APPROVAL OF THE ENGINEER. EROSION CONTROL BY SEEDING SHALL CONFORM TO STANDARD SPECIFICATION 02930.
19. CONTRACTOR SHALL INSTALL EROSION AND SEDIMENT CONTROLS AS PER SPECIFICATIONS DURING CONSTRUCTION. SUCH CONTROLS SHALL BE PLACED AT LIMITS OF DISTURBED AREAS AND AT INTERMEDIATE LOCATIONS WHERE CONCENTRATED FLOW IS LIKELY.
20. STORMWATER THAT HAS COME INTO CONTACT WITH THE ASH WITHIN THE EXCAVATED POND IS TO BE CONSIDERED CONTACT STORMWATER. CONTRACTOR WILL CONTROL THE WATER ON SITE IN COMPLIANCE WITH THE TPDES PERMIT.
21. THE CONTRACTOR IS REQUIRED TO PRESENT THE SWPPP TO LUMINANT ENVIRONMENTAL SERVICES FOR APPROVAL PRIOR TO THE COMMENCEMENT OF CONSTRUCTION ACTIVITIES.
22. THE CONTRACTOR IS REQUIRED TO SUBMIT THE NOTICE OF INTENT AND NOTICE OF TERMINATION FOR THE TPDES PERMIT.
23. THE CONTRACTOR IS TO ACQUIRE A DIGGING PERMIT FROM THE PLANT BEFORE COMMENCING ANY EXCAVATION ACTIVITY.



ISSUE	DATE	DESCRIPTION
F	01/29/2020	ISSUED FOR BID
E	01/23/2020	ISSUED FOR CLIENT REVIEW
D	01/14/2020	ISSUED FOR CLIENT REVIEW
C	12/20/2019	ISSUED FOR CLIENT REVIEW
B	11/26/2019	ISSUED FOR CLIENT REVIEW
A	11/12/2019	ISSUED FOR CLIENT REVIEW

PROJECT MANAGER	D. VOGT, P.E.
DESIGNED BY	K. PERERA
DRAWN BY	J. RAYMOND
CHECKED BY	M. ROBERTS
PROJECT NUMBER	10172630




MARTIN LAKE STEAM ELECTRICAL STATION
EAST ASH POND RELINE
RUSK COUNTY, TEXAS



FILENAME 00G-02.dwg
SCALE

SHEET
00G-02

ABBREVIATIONS AND GENERAL NOTES

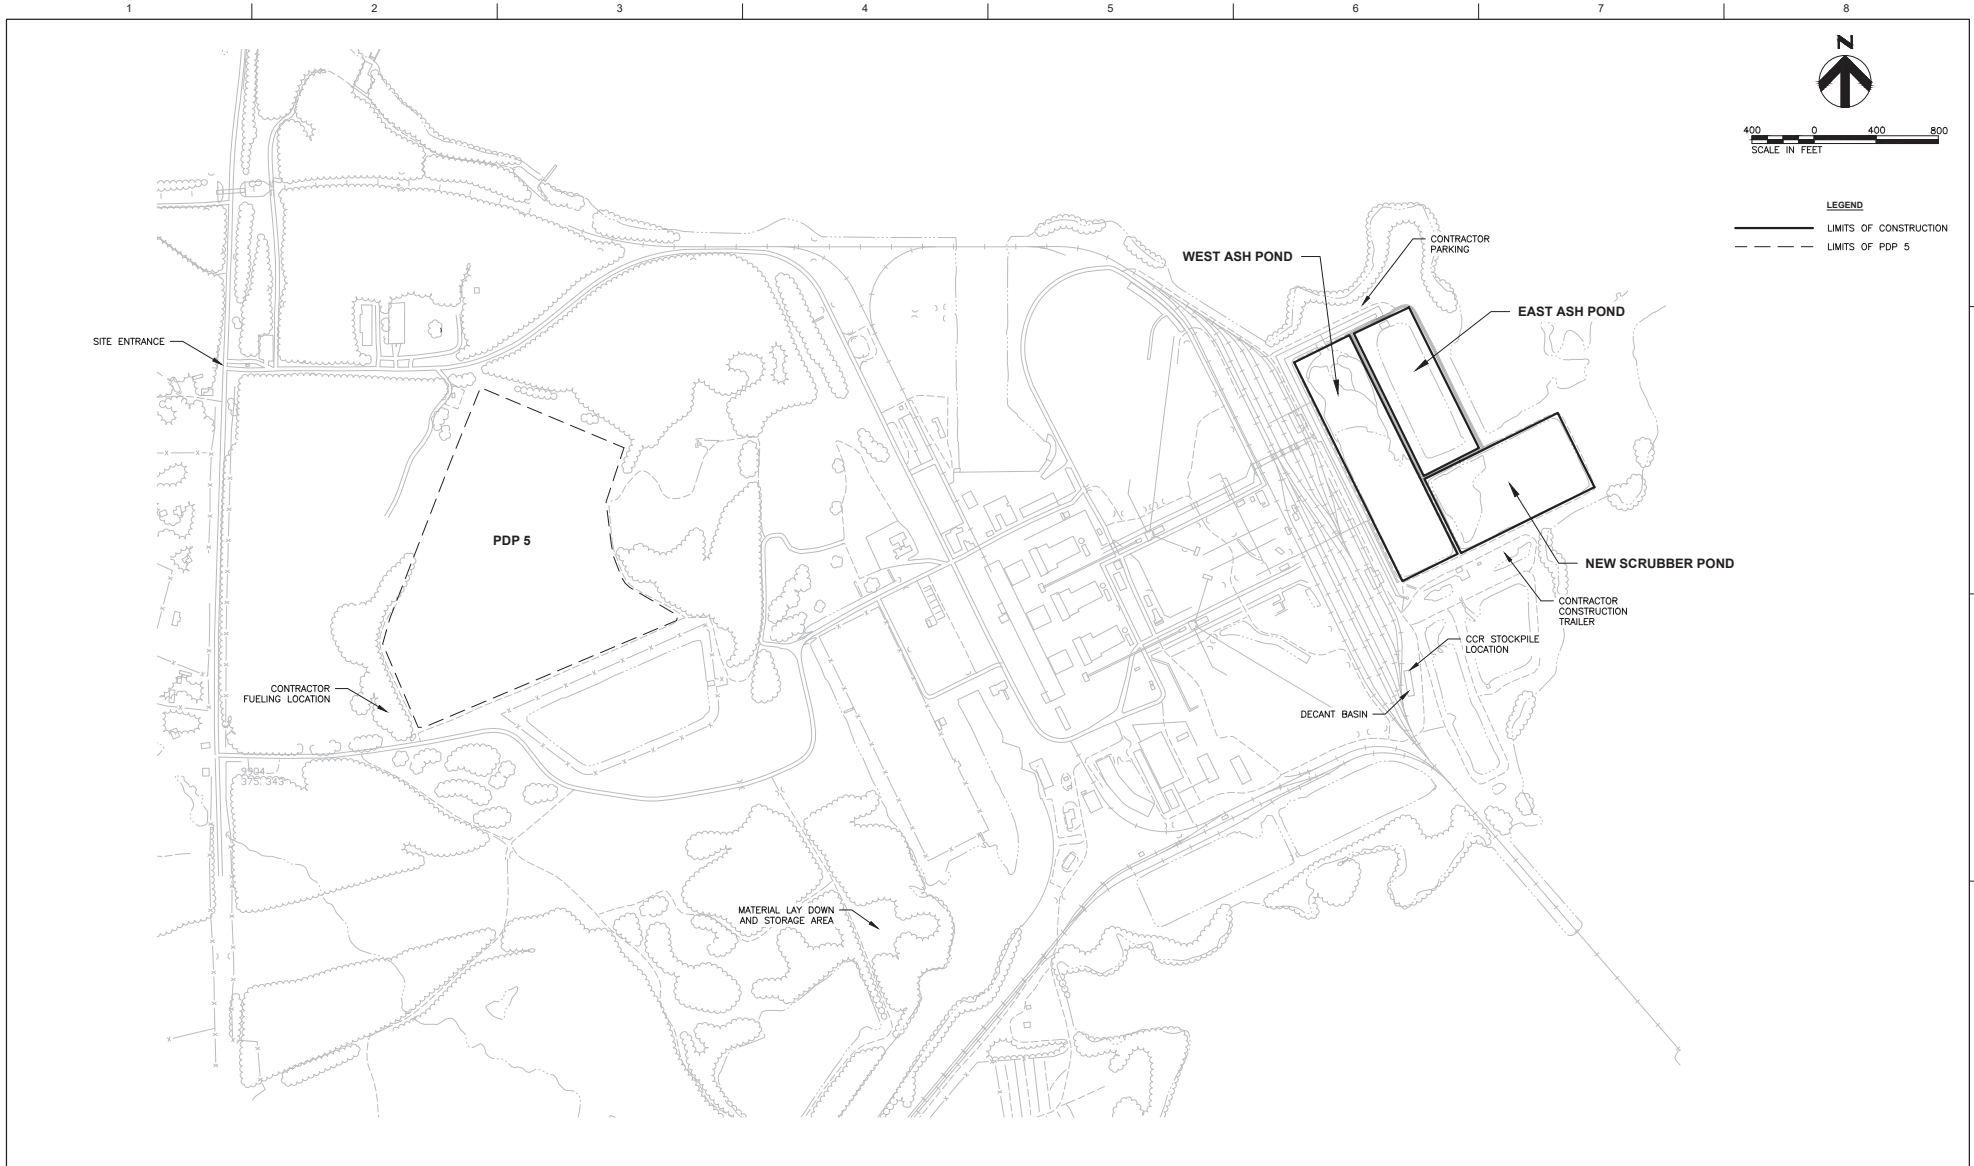

ISSUE	DATE	DESCRIPTION
F	01/29/2020	ISSUED FOR BID
E	01/23/2020	ISSUED FOR CLIENT REVIEW
D	01/14/2020	ISSUED FOR CLIENT REVIEW
C	12/20/2019	ISSUED FOR CLIENT REVIEW
B	11/26/2019	ISSUED FOR CLIENT REVIEW
A	11/12/2019	ISSUED FOR CLIENT REVIEW

PROJECT MANAGER	D. VOGT, P.E.
DESIGNED BY	K. PERERA
DRAWN BY	J. RAYMOND
CHECKED BY	M. ROBERTS
PROJECT NUMBER	10172630



**MARTIN LAKE STEAM ELECTRICAL STATION
EAST ASH POND RELINE
RUSK COUNTY, TEXAS**




SITE LAYOUT



FILENAME 00C-01.dwg
SCALE 1" = 400'

SHEET
00C-01

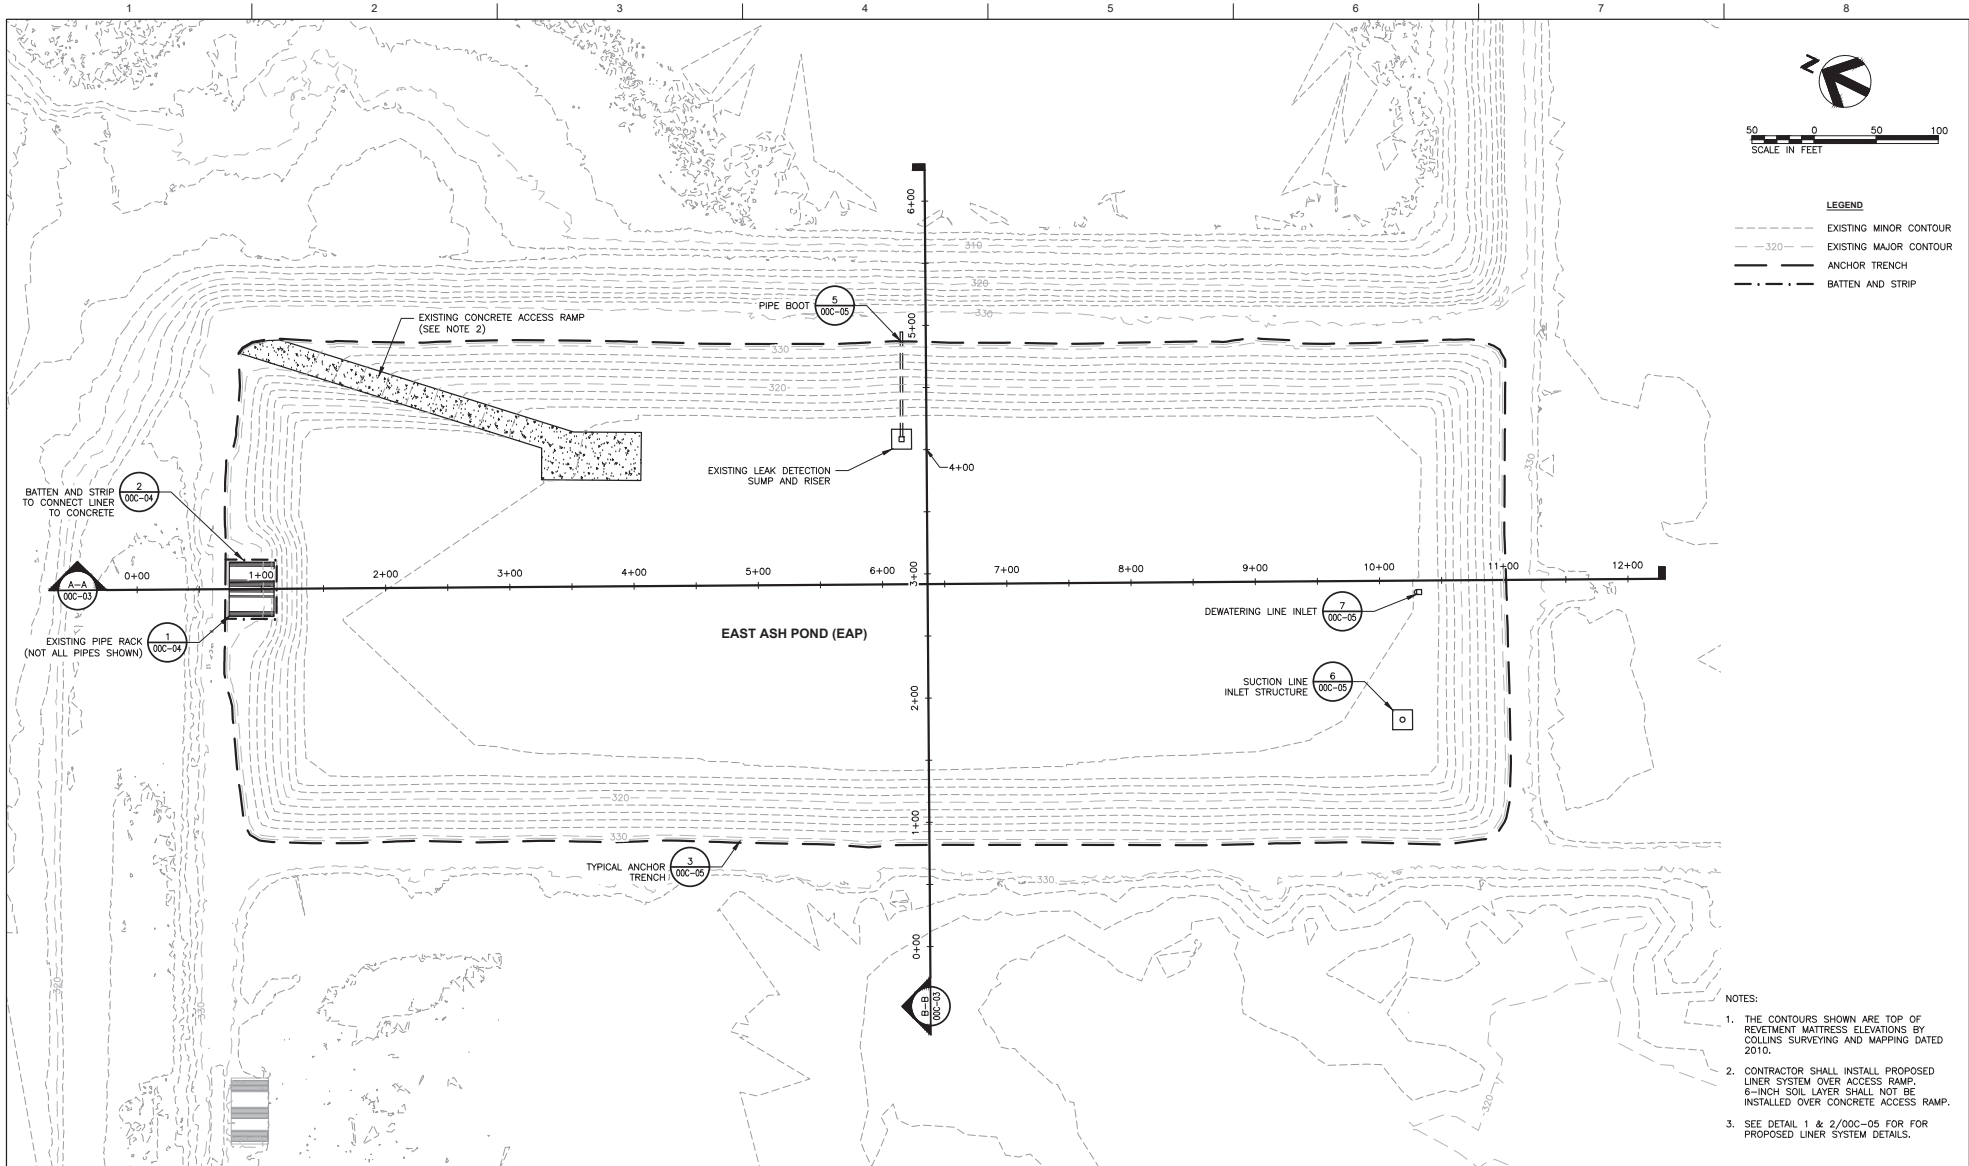

- NOTES:
1. THE CONTOURS SHOWN ARE TOP OF REVETMENT MATTRESS ELEVATIONS BY COLLINS SURVEYING AND MAPPING DATED 2010.
 2. CONTRACTOR SHALL INSTALL PROPOSED LINER SYSTEM OVER ACCESS RAMP. 6-INCH SOIL LAYER SHALL NOT BE INSTALLED OVER CONCRETE ACCESS RAMP.
 3. SEE DETAIL 1 & 2/00C-05 FOR PROPOSED LINER SYSTEM DETAILS.



ISSUE	DATE	DESCRIPTION
F	01/29/2020	ISSUED FOR BID
E	01/23/2020	ISSUED FOR CLIENT REVIEW
D	01/14/2020	ISSUED FOR CLIENT REVIEW
C	12/20/2019	ISSUED FOR CLIENT REVIEW
B	11/26/2019	ISSUED FOR CLIENT REVIEW
A	11/12/2019	ISSUED FOR CLIENT REVIEW

PROJECT MANAGER	D. VOGT, P.E.
DESIGNED BY	K. PERERA
DRAWN BY	J. RAYMOND
CHECKED BY	M. ROBERTS
PROJECT NUMBER	10172630




MARTIN LAKE STEAM ELECTRICAL STATION
EAST ASH POND RELINE
RUSK COUNTY, TEXAS





FILENAME 00C-02.dwg
SCALE 1" = 50'

SHEET
00C-02

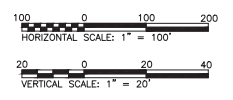


LEGEND
 - - - - - EXISTING GROUND SURFACE
 _____ PROPOSED GRADE

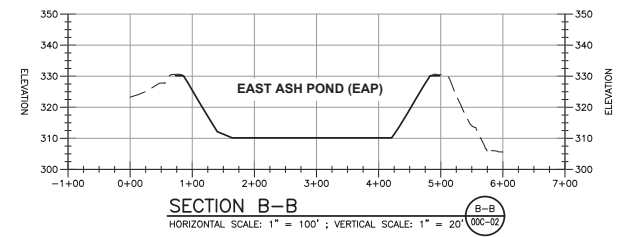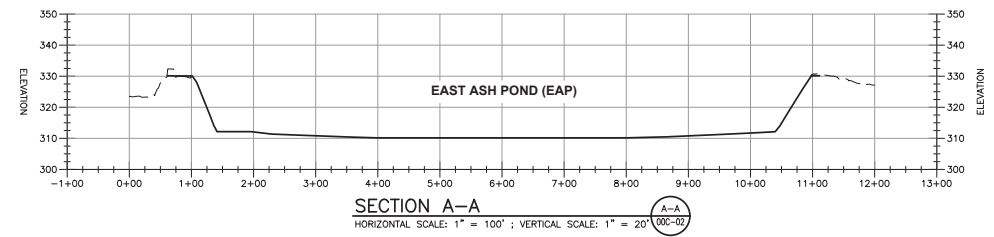

ISSUE	DATE	DESCRIPTION
F	01/29/2020	ISSUED FOR BID
E	01/23/2020	ISSUED FOR CLIENT REVIEW
D	01/14/2020	ISSUED FOR CLIENT REVIEW
C	12/20/2019	ISSUED FOR CLIENT REVIEW
B	11/26/2019	ISSUED FOR CLIENT REVIEW
A	11/12/2019	ISSUED FOR CLIENT REVIEW

PROJECT MANAGER	D. VOGT, P.E.
DESIGNED BY	K. PERERA
DRAWN BY	J. RAYMOND
CHECKED BY	M. ROBERTS
PROJECT NUMBER	10172630

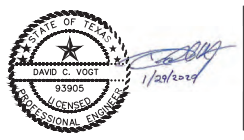

MARTIN LAKE STEAM ELECTRICAL STATION
 EAST ASH POND RELINE
 RUSK COUNTY, TEXAS





CROSS SECTIONS




FILENAME: 00C-03.dwg
 SCALE: H: 1" = 100' ; V: 1" = 20'

SHEET
00C-03

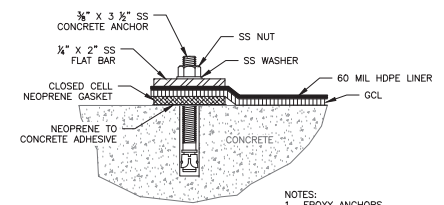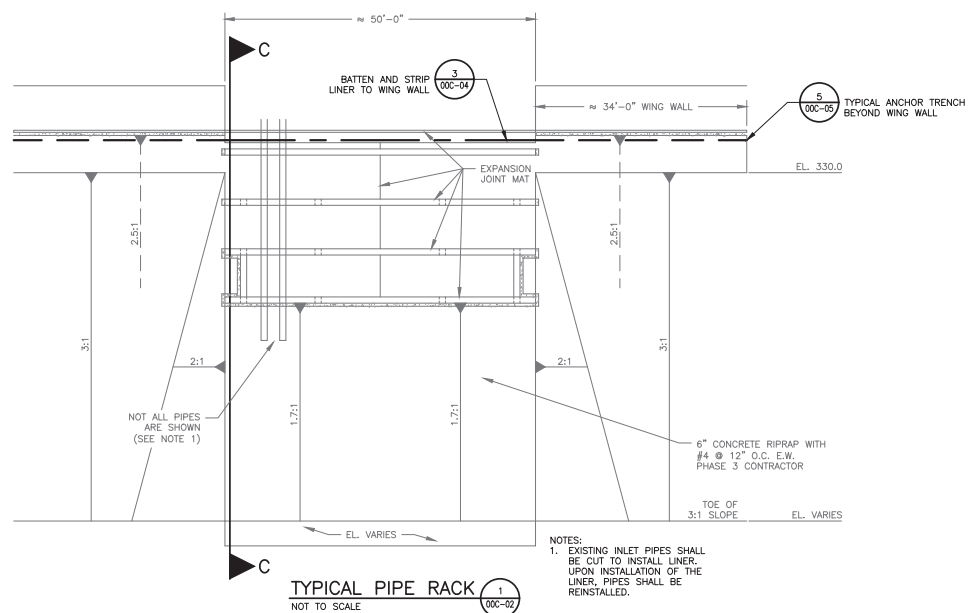


BATTEN AND STRIP CONNECTION AT ANCHOR TRENCH
NOT TO SCALE

2A 000-06

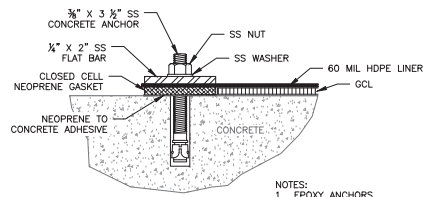

BATTEN AND STRIP CONNECTION BELOW WATER SURFACE
NOT TO SCALE

2B 000-06

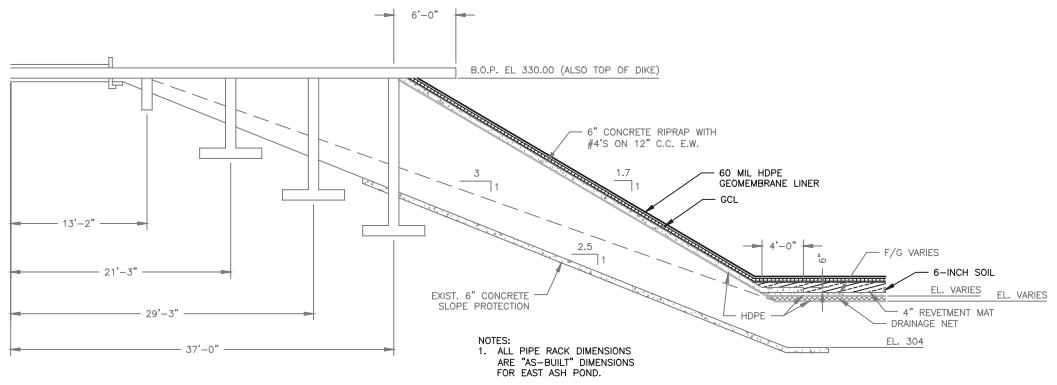


SECTION C-C
NOT TO SCALE



ISSUE	DATE	DESCRIPTION
F	01/29/2020	ISSUED FOR BID
E	01/23/2020	ISSUED FOR CLIENT REVIEW
D	01/14/2020	ISSUED FOR CLIENT REVIEW
C	12/20/2019	ISSUED FOR CLIENT REVIEW
B	11/26/2019	ISSUED FOR CLIENT REVIEW
A	11/12/2019	ISSUED FOR CLIENT REVIEW

PROJECT MANAGER	D. VOGT, P.E.
DESIGNED BY	K. PERERA
DRAWN BY	J. RAYMOND
CHECKED BY	M. ROBERTS
PROJECT NUMBER	10172630

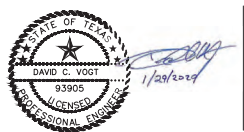


MARTIN LAKE STEAM ELECTRICAL STATION
EAST ASH POND RELINE
RUSK COUNTY, TEXAS




FILENAME | 00C-04.dwg
SCALE

SHEET
00C-04

DETAILS
(1 OF 2)

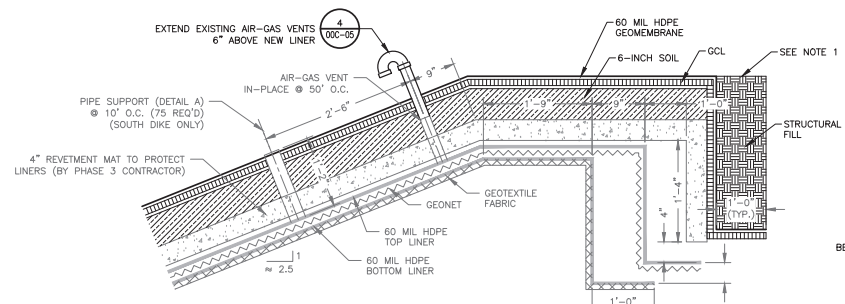


ANCHOR TRENCH
NOT TO SCALE

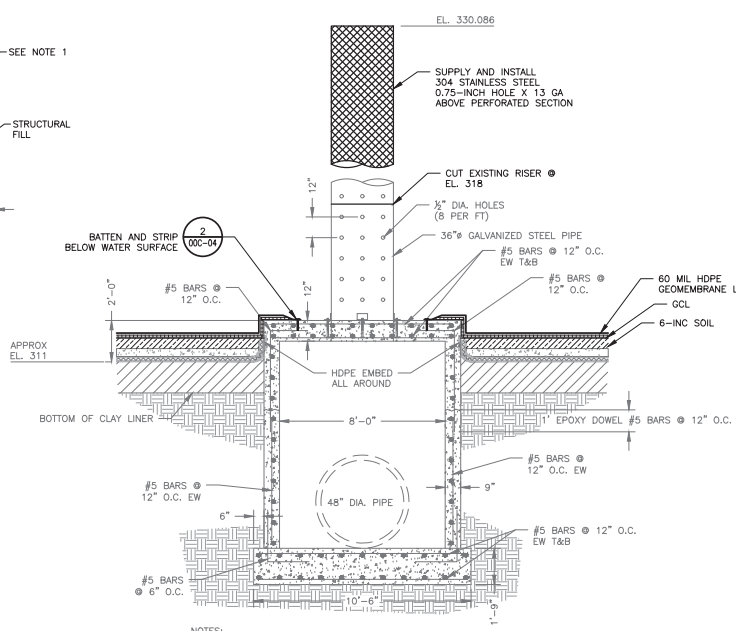


NOTES:
1. THE INTERIOR OF THE INLET STRUCTURE WAS LINED WITH AN EPOXY COATING OF RAVEN LINING 405 AT A MINIMUM THICKNESS OF 200 MILS.


SUCTION LINE INLET STRUCTURE
NOT TO SCALE

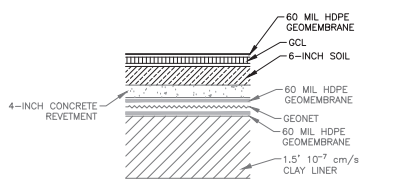


PROPOSED EAP RETROFIT SECTION (FLOOR)
NOT TO SCALE

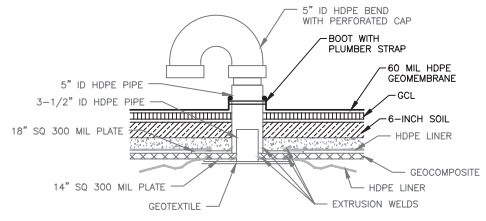


TYPICAL AIR-GAS VENT
NOT TO SCALE

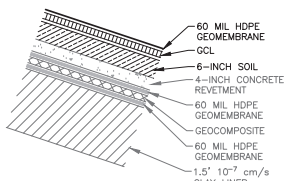

PROPOSED EAP RETROFIT SECTION (SIDESLOPE)
NOT TO SCALE

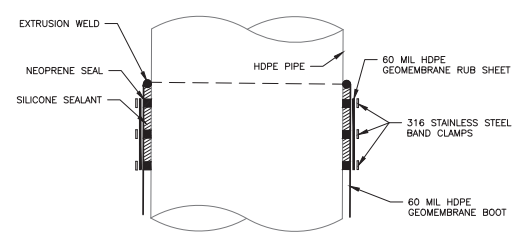

PIPE BOOT
NOT TO SCALE

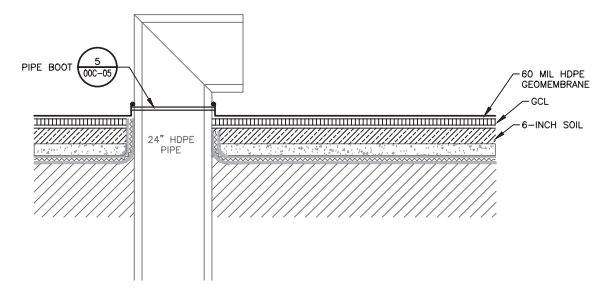


24\"/>



ISSUE	DATE	DESCRIPTION
F	01/29/2020	ISSUED FOR BID
E	01/23/2020	ISSUED FOR CLIENT REVIEW
D	01/14/2020	ISSUED FOR CLIENT REVIEW
C	12/20/2019	ISSUED FOR CLIENT REVIEW
B	11/26/2019	ISSUED FOR CLIENT REVIEW
A	11/12/2019	ISSUED FOR CLIENT REVIEW

PROJECT MANAGER	D. VOGT, P.E.
DESIGNED BY	K. PERERA
DRAWN BY	J. RAYMOND
CHECKED BY	M. ROBERTS
PROJECT NUMBER	10172630


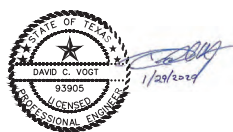


MARTIN LAKE STEAM ELECTRICAL STATION
EAST ASH POND RELINE
RUSK COUNTY, TEXAS



FILENAME: 00C-05.dwg
SCALE: NOT TO SCALE

SHEET
00C-05

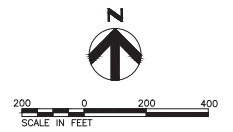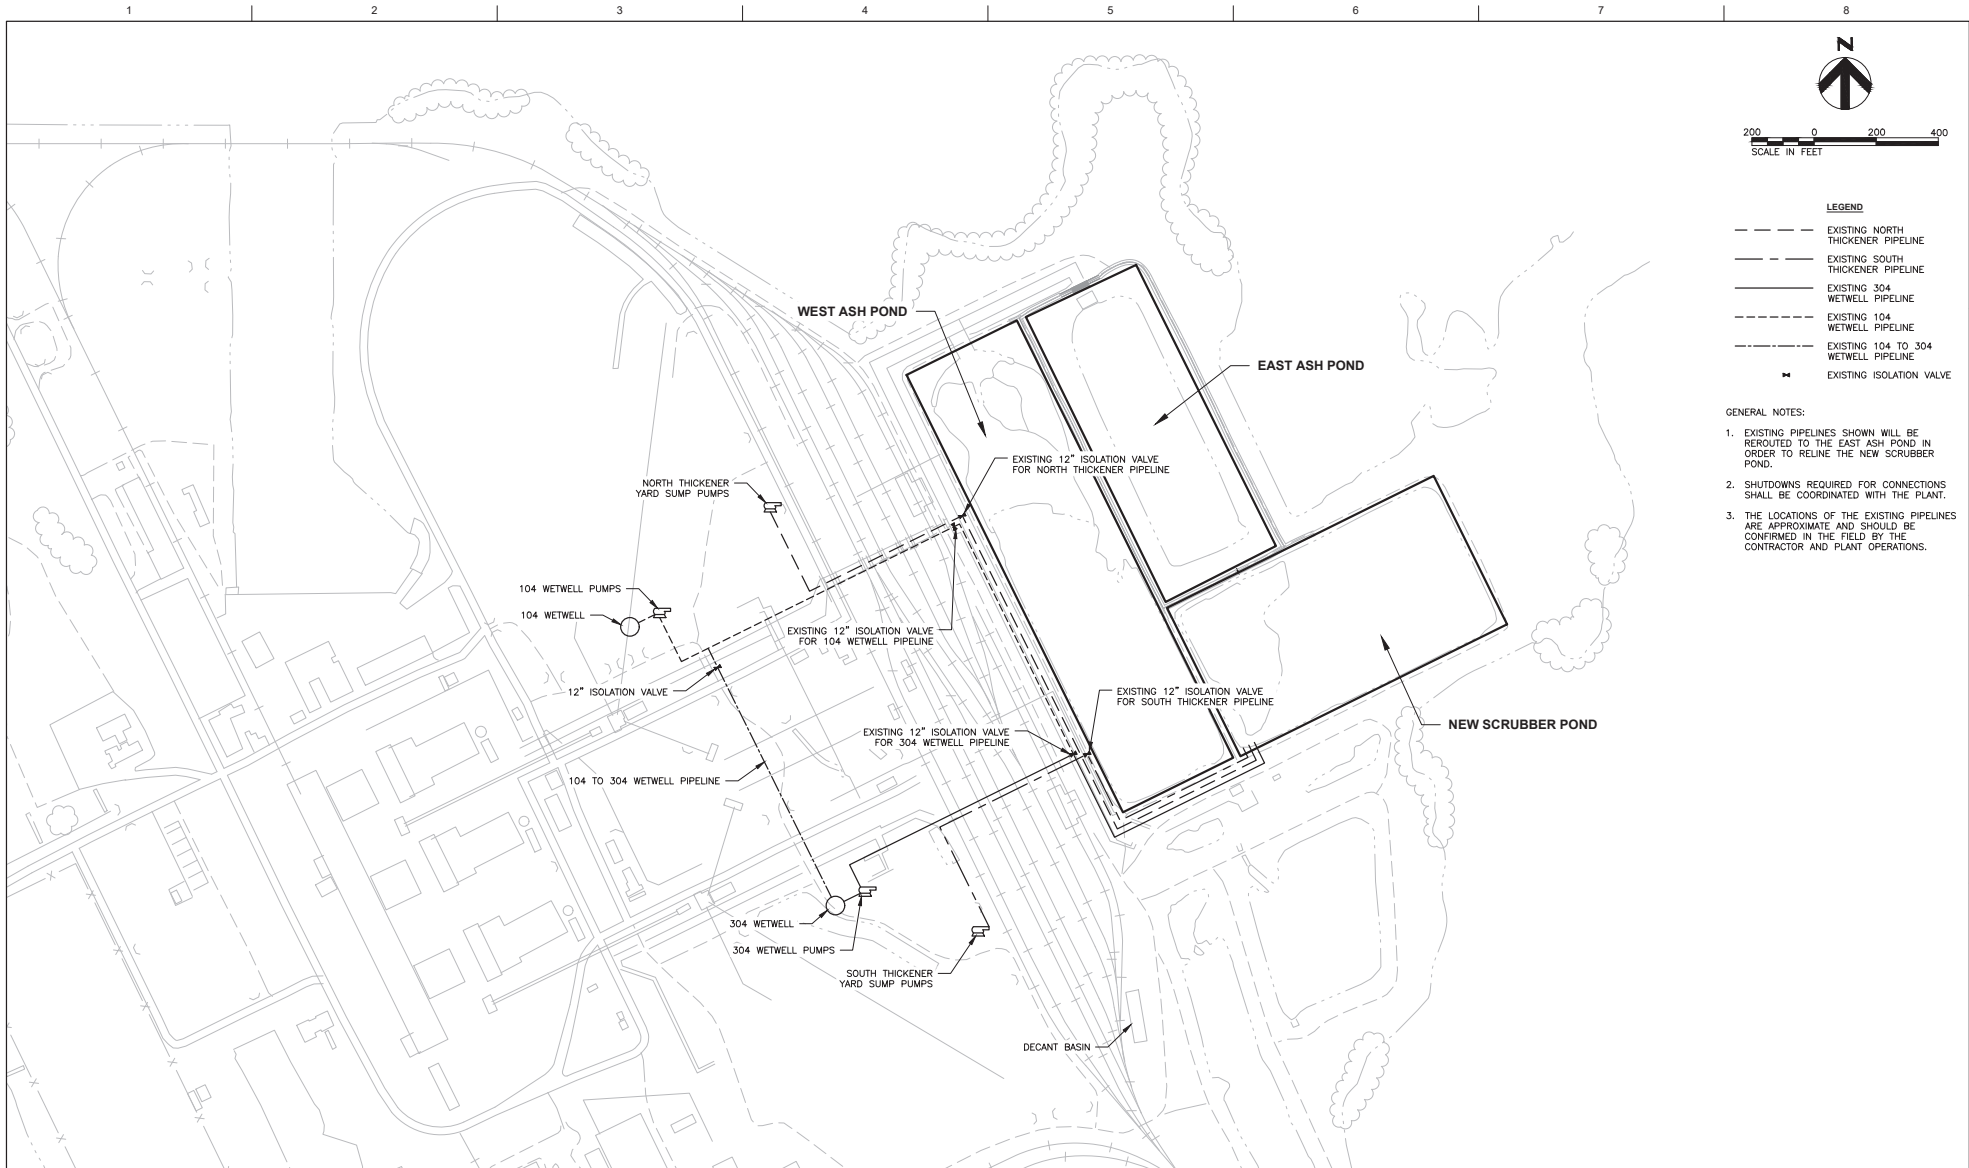

- LEGEND**
- EXISTING NORTH THICKENER PIPELINE
 - EXISTING SOUTH THICKENER PIPELINE
 - EXISTING 304 WETWELL PIPELINE
 - EXISTING 104 WETWELL PIPELINE
 - EXISTING 104 TO 304 WETWELL PIPELINE
 - EXISTING ISOLATION VALVE

- GENERAL NOTES:**
1. EXISTING PIPELINES SHOWN WILL BE REROUTED TO THE EAST ASH POND IN ORDER TO RELINE THE NEW SCRUBBER POND.
 2. SHUTDOWNS REQUIRED FOR CONNECTIONS SHALL BE COORDINATED WITH THE PLANT.
 3. THE LOCATIONS OF THE EXISTING PIPELINES ARE APPROXIMATE AND SHOULD BE CONFIRMED IN THE FIELD BY THE CONTRACTOR AND PLANT OPERATIONS.

ISSUE	DATE	DESCRIPTION
F	01/29/2020	ISSUED FOR BID
E	01/23/2020	ISSUED FOR CLIENT REVIEW
D	01/14/2020	ISSUED FOR CLIENT REVIEW
C	12/20/2019	ISSUED FOR CLIENT REVIEW
B	11/26/2019	ISSUED FOR CLIENT REVIEW
A	11/12/2019	ISSUED FOR CLIENT REVIEW


PROJECT MANAGER	D. VOGT, P.E.
DESIGNED BY	J. ORDONEZ, P.E.
DRAWN BY	J. RAYMOND
CHECKED BY	D. VOGT, P.E.
PROJECT NUMBER	10172630





**MARTIN LAKE STEAM ELECTRICAL STATION
EAST ASH POND RELINE
RUSK COUNTY, TEXAS**



EXISTING YARD PIPING

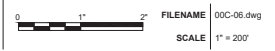

SHEET
00C-06

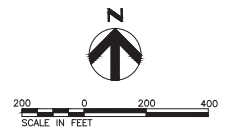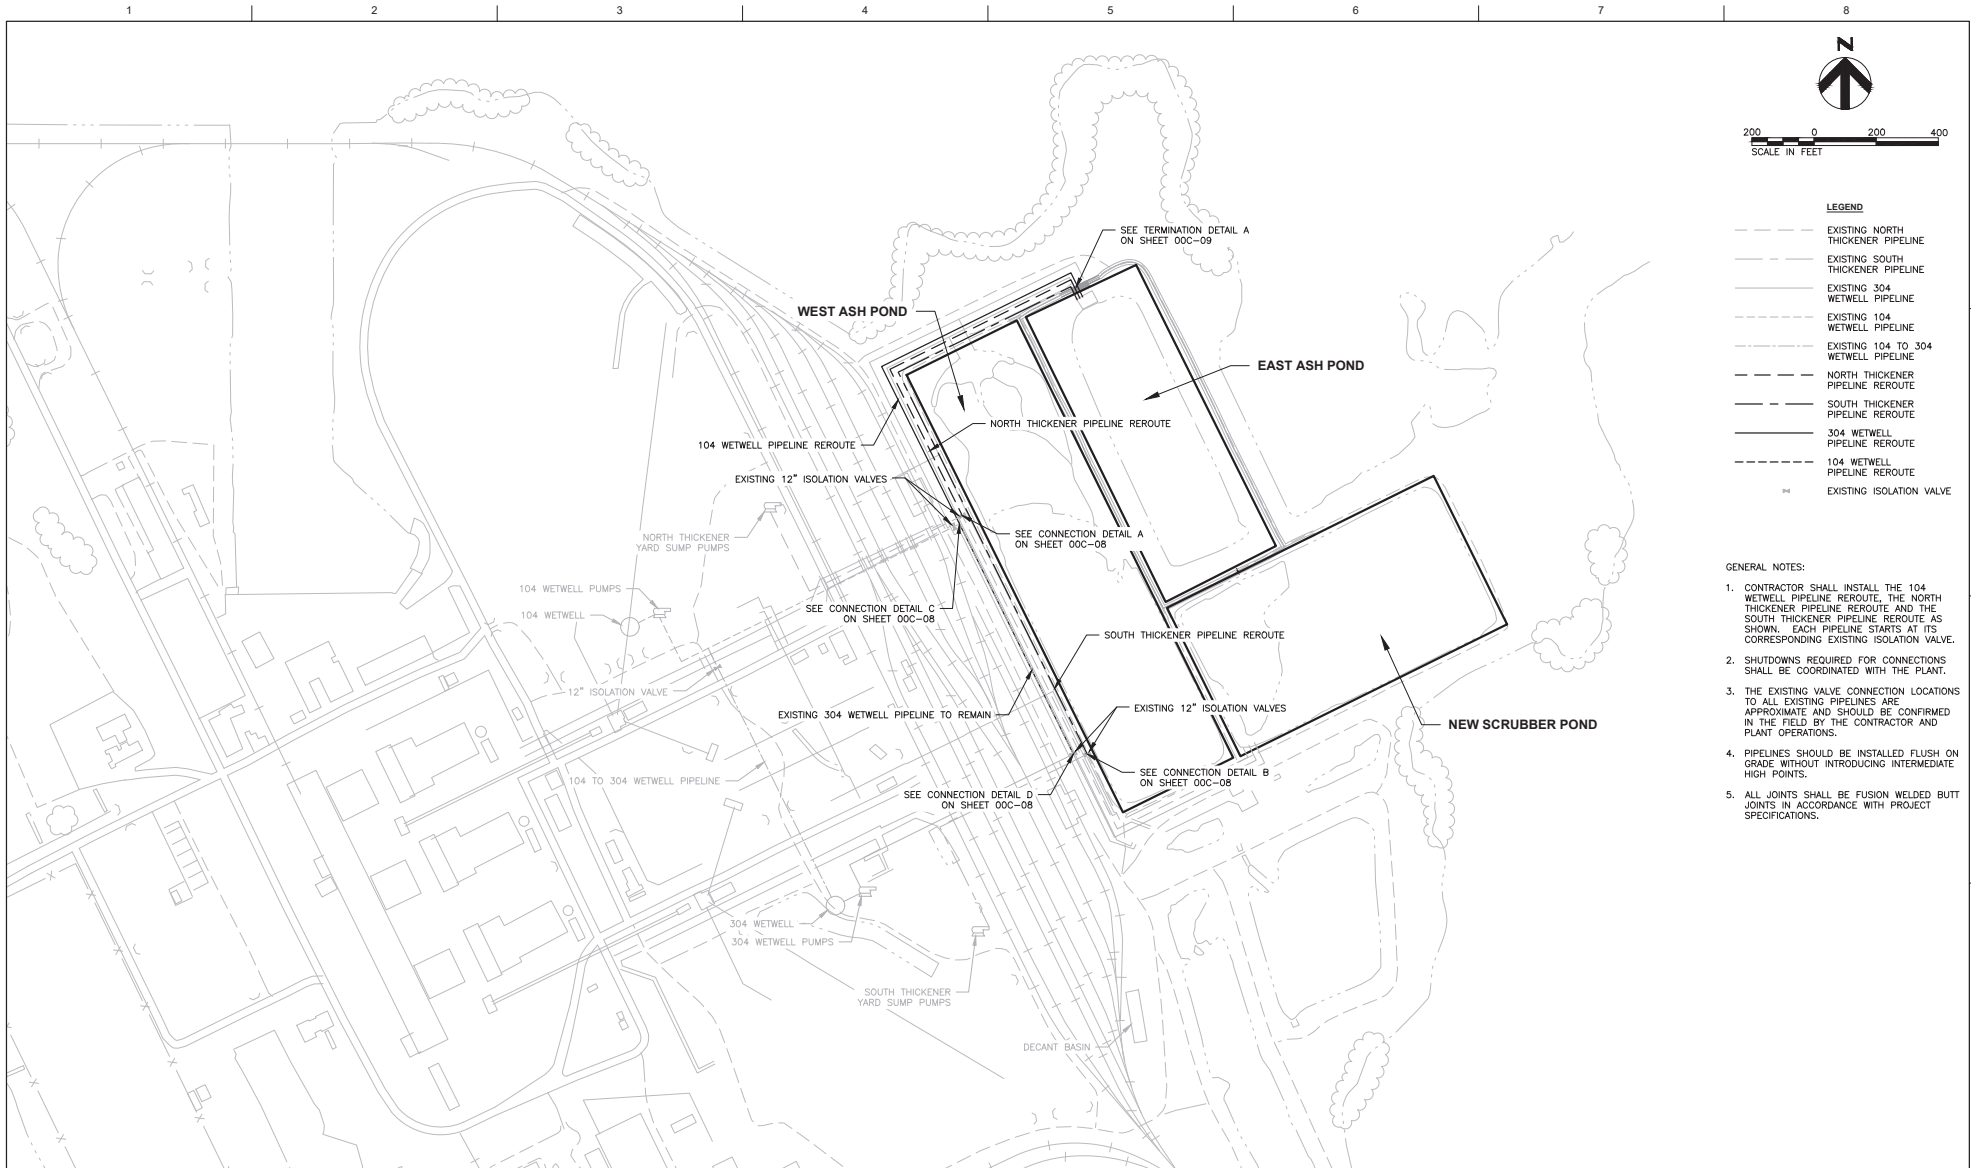

LEGEND

- EXISTING NORTH THICKENER PIPELINE
- EXISTING SOUTH THICKENER PIPELINE
- EXISTING 304 WETWELL PIPELINE
- EXISTING 104 WETWELL PIPELINE
- EXISTING 104 TO 304 WETWELL PIPELINE
- NORTH THICKENER PIPELINE REROUTE
- SOUTH THICKENER PIPELINE REROUTE
- 304 WETWELL PIPELINE REROUTE
- 104 WETWELL PIPELINE REROUTE
- EXISTING ISOLATION VALVE

- GENERAL NOTES:**
1. CONTRACTOR SHALL INSTALL THE 104 WETWELL PIPELINE REROUTE, THE NORTH THICKENER PIPELINE REROUTE AND THE SOUTH THICKENER PIPELINE REROUTE AS SHOWN. EACH PIPELINE STARTS AT ITS CORRESPONDING EXISTING ISOLATION VALVE.
 2. SHUTDOWNS REQUIRED FOR CONNECTIONS SHALL BE COORDINATED WITH THE PLANT.
 3. THE EXISTING VALVE CONNECTION LOCATIONS TO ALL EXISTING PIPELINES ARE APPROXIMATE AND SHOULD BE CONFIRMED IN THE FIELD BY THE CONTRACTOR AND PLANT OPERATIONS.
 4. PIPELINES SHOULD BE INSTALLED FLUSH ON GRADE WITHOUT INTRODUCING INTERMEDIATE HIGH POINTS.
 5. ALL JOINTS SHALL BE FUSION WELDED BUTT JOINTS IN ACCORDANCE WITH PROJECT SPECIFICATIONS.



ISSUE	DATE	DESCRIPTION
F	01/29/2020	ISSUED FOR BID
E	01/23/2020	ISSUED FOR CLIENT REVIEW
D	01/14/2020	ISSUED FOR CLIENT REVIEW
C	12/20/2019	ISSUED FOR CLIENT REVIEW
B	11/26/2019	ISSUED FOR CLIENT REVIEW
A	11/12/2019	ISSUED FOR CLIENT REVIEW

PROJECT MANAGER	D. VOGT, P.E.
DESIGNED BY	J. ORDONEZ, P.E.
DRAWN BY	J. RAYMOND
CHECKED BY	D. VOGT, P.E.
PROJECT NUMBER	10172630




**MARTIN LAKE STEAM ELECTRICAL STATION
EAST ASH POND RELINE
RUSK COUNTY, TEXAS**




MODIFIED YARD PIPING

0	1'	2'	FILENAME	00C-07.dwg
			SCALE	1" = 200'


SHEET
00C-07

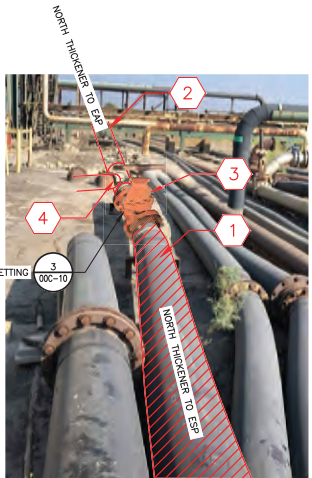

CONNECTION TO NORTH THICKENER PIPELINE A
 NOT TO SCALE 00C-07

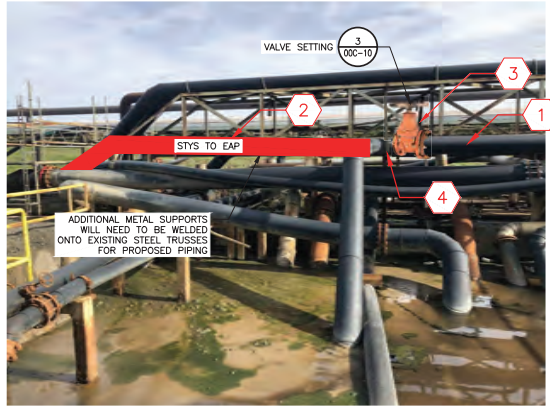

CONNECTION TO SOUTH THICKENER PIPELINE B
 NOT TO SCALE 00C-07

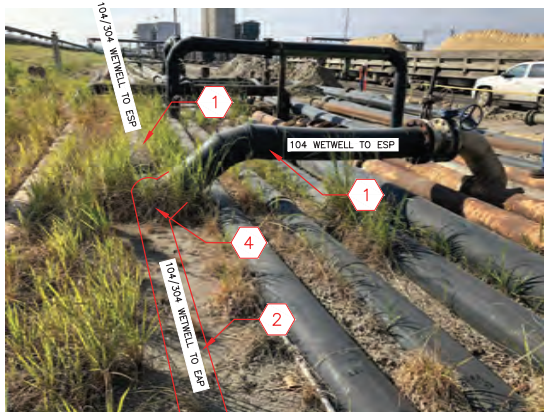

CONNECTION TO 104 WETWELL TO ESP PIPELINE C
 NOT TO SCALE 00C-07



CONNECTION TO 304 WETWELL TO ESP PIPELINE C
 NOT TO SCALE 00C-07

- GENERAL NOTES:
1. SHUTDOWNS REQUIRED FOR CONNECTIONS SHALL BE COORDINATED WITH THE PLANT.
 2. THE CONNECTIONS LOCATION TO ALL EXISTING PIPELINES ARE APPROXIMATE AND SHOULD BE CONFIRMED IN THE FIELD BY THE CONTRACTOR AND PLANT OPERATIONS.
 3. CONNECTIONS C AND D MUST BOTH BE COMPLETE BEFORE MAKING EITHER OF THESE LINES OPERATIONAL.
 4. ALL PIPE AND FITTING SIZES SHALL BE CONFIRMED IN THE FIELD BY THE CONTRACTOR PRIOR TO ORDERING OR MANUFACTURING OF PIPE.

- KEY NOTES:
- 1 EXISTING TO REMAIN
 - 2 PIPELINE REROUTE
 - 3 12" ISOLATION VALVE
 - 4 INSTALL SIZE ON SIZE TEE



ISSUE	DATE	DESCRIPTION
F	01/29/2020	ISSUED FOR BID
E	01/23/2020	ISSUED FOR CLIENT REVIEW
D	01/14/2020	ISSUED FOR CLIENT REVIEW
C	12/20/2019	ISSUED FOR CLIENT REVIEW
B	11/26/2019	ISSUED FOR CLIENT REVIEW
A	11/12/2019	ISSUED FOR CLIENT REVIEW

PROJECT MANAGER	D. VOGT, P.E.
DESIGNED BY	J. ORDONEZ, P.E.
DRAWN BY	J. RAYMOND
CHECKED BY	D. VOGT, P.E.
PROJECT NUMBER	10172630




MARTIN LAKE STEAM ELECTRICAL STATION
 EAST ASH POND RELINE
 RUSK COUNTY, TEXAS




YARD PIPING CONNECTIONS AND DETAILS

0 1' 2' FILENAME 00C-08.dwg
 SCALE NOT TO SCALE

SHEET
00C-08

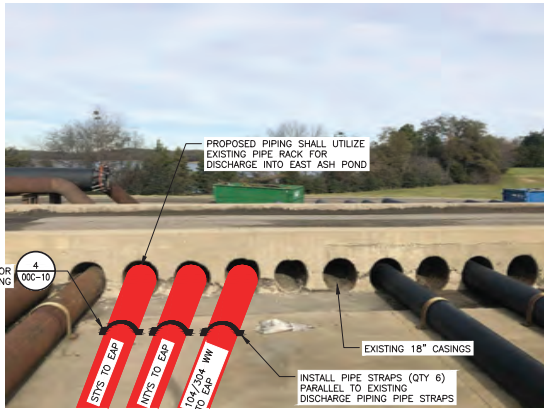


TERMINATION DETAIL A AT EXISTING PIPE RACK (A) 00C-08
NOT TO SCALE

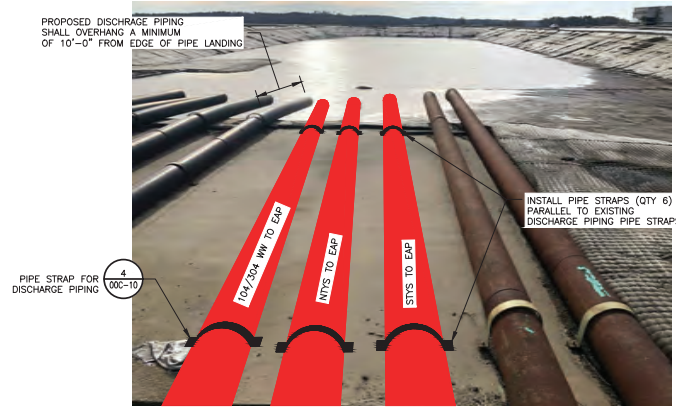

TERMINATION DETAIL B AT EXISTING PIPE RACK (B) 00C-09
NOT TO SCALE



TERMINATION DETAIL C AT EXISTING PIPE RACK (C) 00C-09
NOT TO SCALE

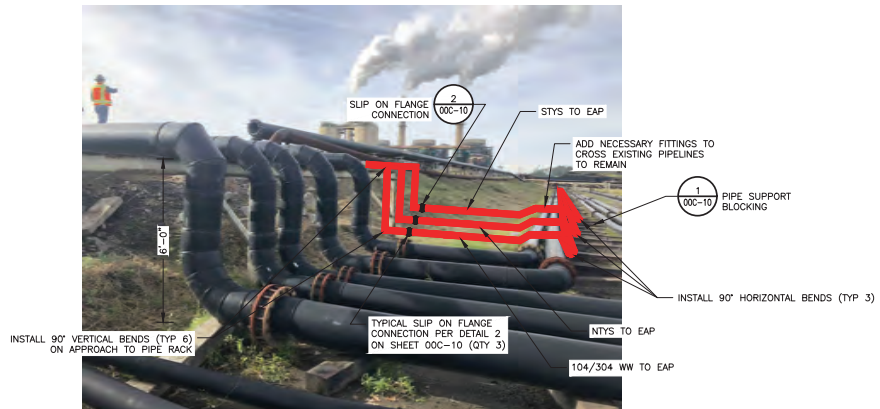

TERMINATION DETAIL D AT EXISTING PIPE RACK (D) 00C-09
NOT TO SCALE

GENERAL NOTES:

- EXISTING PIPELINES SHOWN SHALL BE REROUTED TO THE EAST ASH POND IN ORDER TO RELINE THE NEW SCRUBBER POND.
- SHUTDOWNS REQUIRED FOR CONNECTIONS SHALL BE COORDINATED WITH THE PLANT.
- THE CONNECTIONS LOCATION TO ALL EXISTING PIPELINES ARE APPROXIMATE AND SHOULD BE CONFIRMED IN THE FIELD BY THE CONTRACTOR AND PLANT OPERATIONS.
- ALL JOINTS SHALL BE FUSION WELDED BUTT JOINTS IN ACCORDANCE WITH PROJECT SPECIFICATIONS, UNLESS OTHERWISE NOTED.
- ALL PIPE AND FITTING SIZES SHALL BE CONFIRMED IN THE FIELD BY THE CONTRACTOR PRIOR TO ORDERING OR MANUFACTURING OF PIPE.



ISSUE	DATE	DESCRIPTION
F	01/29/2020	ISSUED FOR BID
E	01/23/2020	ISSUED FOR CLIENT REVIEW
D	01/14/2020	ISSUED FOR CLIENT REVIEW
C	12/20/2019	ISSUED FOR CLIENT REVIEW
B	11/26/2019	ISSUED FOR CLIENT REVIEW
A	11/12/2019	ISSUED FOR CLIENT REVIEW

PROJECT MANAGER	D. VOGT, P.E.
DESIGNED BY	J. ORDONEZ, P.E.
DRAWN BY	J. RAYMOND
CHECKED BY	D. VOGT, P.E.
PROJECT NUMBER	10172630




MARTIN LAKE STEAM ELECTRICAL STATION
EAST ASH POND RELINE
RUSK COUNTY, TEXAS



YARD PIPING CONNECTIONS AND DETAILS

SCALE 1" = 2'
FILENAME 00C-09.dwg
SCALE NOT TO SCALE

SHEET
00C-09

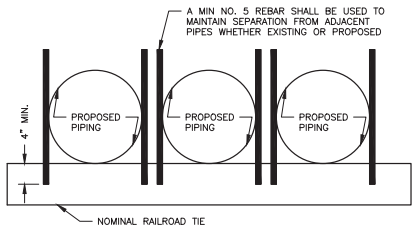


PIPE SUPPORT BLOCKING 1
NOT TO SCALE
00C-09




ALL COMPONENTS SHALL BE IN ACCORDANCE WITH PROJECT SPECIFICATIONS

SLIP ON FLANGE CONNECTION 2
NOT TO SCALE
00C-09

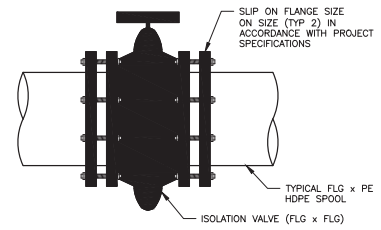

VALVE SETTING 3
NOT TO SCALE
00C-09

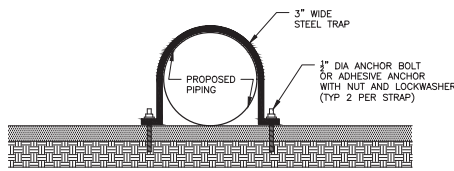

PIPE STRAP FOR DISCHARGE PIPING 4
NOT TO SCALE
00C-09



ISSUE	DATE	DESCRIPTION
F	01/29/2020	ISSUED FOR BID
E	01/23/2020	ISSUED FOR CLIENT REVIEW
D	01/14/2020	ISSUED FOR CLIENT REVIEW
C	12/20/2019	ISSUED FOR CLIENT REVIEW
B	11/26/2019	ISSUED FOR CLIENT REVIEW
A	11/12/2019	ISSUED FOR CLIENT REVIEW

PROJECT MANAGER	D. VOGT, P.E.
DESIGNED BY	J. ORDONEZ, P.E.
DRAWN BY	J. RAYMOND
CHECKED BY	D. VOGT, P.E.
PROJECT NUMBER	10172630



MARTIN LAKE STEAM ELECTRICAL STATION
EAST ASH POND RELINE
RUSK COUNTY, TEXAS



YARD PIPING DETAILS



FILENAME 00C-10.dwg
SCALE NOT TO SCALE

SHEET
00C-10



N

600 0 600 1200
SCALE IN FEET

LEGEND

- LIMITS OF CONSTRUCTION
- - - LIMITS OF PDP 5
- HAUL ROUTE



ISSUE	DATE	DESCRIPTION
F	01/29/2020	ISSUED FOR BID
E	01/23/2020	ISSUED FOR CLIENT REVIEW
D	01/14/2020	ISSUED FOR CLIENT REVIEW
C	12/20/2019	ISSUED FOR CLIENT REVIEW
B	11/26/2019	ISSUED FOR CLIENT REVIEW
A	11/12/2019	ISSUED FOR CLIENT REVIEW

PROJECT MANAGER	D. VOGT, P.E.
DESIGNED BY	K. PERERA
DRAWN BY	J. RAYMOND
CHECKED BY	M. ROBERTS
PROJECT NUMBER	10172630



**MARTIN LAKE STEAM ELECTRICAL STATION
EAST ASH POND RELINE
RUSK COUNTY, TEXAS**



0 1" 2"	FILENAME	00C-11.dwg
	SCALE	1" = 600'

SHEET
00C-11

STOCKPILE AND HAUL ROUTE



HDR
 Firm Registration No. F-754
 17111 Preston Road, Suite 300
 Dallas, Texas 75248-1229
 972.960.4400



VICINITY MAP
 NOT TO SCALE

Construction Drawings For

Martin Lake Steam Electric Station

CCR Impoundment Reline West Ash Pond

Project No.
 10172630

Rusk County, Texas
 January 2020

INDEX OF DRAWINGS

GENERAL	
00G-01	COVER SHEET
00G-02	ABBREVIATIONS AND GENERAL NOTES
CIVIL	
00C-01	SITE LAYOUT
00C-02	WEST ASH POND
00C-03	CROSS SECTIONS
00C-04	DETAILS (1 OF 2)
00C-05	DETAILS (2 OF 2)
00C-06	STOCKPILE AND HAUL ROUTE




STANDARD ABBREVIATIONS

& APPROX	AND APPROXIMATELY	NTS	NOT TO SCALE
AVG	AVERAGE	NTYS	NORTH THICKENER YARD SUMP
BOE	BOTTOM OF EXCAVATION	OC	ON CENTER
BOL	BOTTOM OF LINER	OZ	OUNCE
X	BY	PC	PERCENT
CL	CENTERLINE	PLCP	PERFORATED LEACHATE COLLECTION PIPE
CMP	CORRUGATED METAL PIPE	PERF	PERFORATED
CO	CLEAN OUT	PGL	PROFILE GRADE LINE
CY	CUBIC YARD	PDP	PERMANENT DISPOSAL POND
DIA	DIAMETER	PC	POINT OF CURVATURE
DET	DETAIL	PI	POINT OF INTERSECTION
DWG	DRAWING	PVI	POINT OF VERTICAL INTERSECTION
E	EAST	PT	POINT OF TANGENT
EAP	EAST ASH POND	PZ	PIEZOMETER
ELEV	ELEVATION	Q	FLOW
EW	EACH WAY	QTY	QUANTITY
EXIST	EXISTING	R	RADIUS
EXC	EXCAVATION	RCP	REINFORCED CONCRETE PIPE
FGD	FLUE GAS DESULFICATION	REF	REFERENCE
FML	FLEXIBLE MEMBRANE LINER	REQ	REQUIRED
FT	FEET	RD	ROAD
GAL	GALLON	SCH	SCHEDULE
GND	GROUND	SDL	SAND DRAINAGE LAYER
GDL	GRAVEL DRAINAGE LAYER	SEC	SECTION
GNDL	GEONET DRAINAGE LAYER	SHT	SHEET
HDPE	HIGH DENSITY POLYETHYLENE	S	SOUTH
HORIZ	HORIZONTAL	SDR	STANDARD DIMENSION RATIO
ID	INSIDE DIAMETER	SLOCP	SOIL LINER QUALITY CONTROL PLAN
IN	INCHES	SP	STEEL PIPE
IE	INVERT ELEVATION	SQ	SQUARE
LCRS	LEACHATE COLLECTION AND REMOVAL SYSTEM	SS	SIDE SLOPE
LCS	LEACHATE COLLECTION SYSTEM	STA	STATION
LCP	LEACHATE COLLECTION PIPE	STYS	SOUTH THICKENER YARD SUMP
LCPR	LEACHATE COLLECTION PIPE RISER	T.A.S.	TERMINAL ANCHOR SECTION
LF	LINEAR FEET	TL	TANGENT LENGTH
LB	POUND	TOC	TOP OF COVER
MH	MANHOLE	TOL	TOP OF LINER
MAX	MAXIMUM	TOS	TOE OF SLOPE
MIN	.001 INCHES	TS	TOP SLOPE
MW	MONITOR WELL	TEMP	TEMPORARY
MLSES	MARTIN LAKE STEAM ELECTRIC STATION	TYP	TYPICAL
MSL	MEAN SEA LEVEL	UNO	UNLESS NOTED OTHERWISE
N	NORTH	VERT	VERTICAL
NIC	NOT IN CONTRACT	W	WEST
NO	NUMBER	W/	WITH
		WAP	WEST ASH POND
		WW	WETWELL
		YD	YARD


SYMBOLS

SECTION DETAIL INDICATORS


DRAWING ON WHICH SECTION IS CUT:

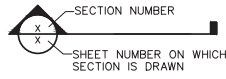




DRAWING ON WHICH SECTION APPEARS:

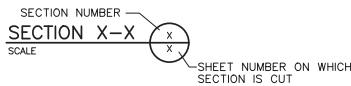


DRAWING ON WHICH DETAIL IS INDICATED:

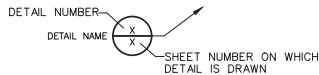

DRAWING ON WHICH DETAIL APPEARS:

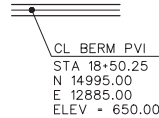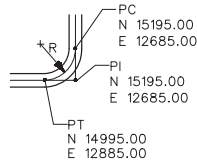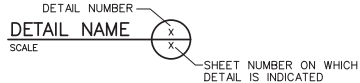

VERTICAL CONTROL DESIGNATION

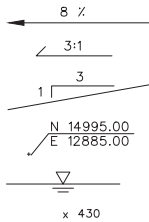

CONSTRUCTION SEQUENCE

- A. CONTRACTOR SHALL CLEAN THE WAP BY REMOVING ANY REMAINING CCR MATERIAL, ROCKS, AND SEDIMENT.
- B. CONTRACTOR SHALL USE WATER FROM THE ADJACENT EAST ASH POND (EAP) OR NEW SCRUBBER POND (SP) TO WASH REMAINING CCR MATERIAL OFF THE SIDES AND FLOOR OF THE WAP AND REMOVE IT. EAP WILL BE VISUALLY INSPECTED BY OWNER'S COA CONSULTANT TO CONFIRM CCR MATERIAL, ROCKS, AND SEDIMENT HAVE BEEN REMOVED.
- C. CONTRACTOR SHALL LOAD AND HAUL GENERAL SOIL FILL MATERIAL FROM THE OWNER'S STOCKPILE LOCATED AT LIBERTY MINE, A LOCATION UNDER THE PROVISIONS OF THE MINE SAFETY AND HEALTH ADMINISTRATION (MSHA) AND APPROXIMATELY 4.5 MILES FROM EAP.
- D. CONTRACTOR SHALL PLACE THE GENERAL FILL MATERIAL OVER THE EXISTING CONCRETE REVETMENT TO A DEPTH OF AT LEAST SIX (6) INCHES, NOMINALLY COMPACT, AND SMOOTH ROLL TO FINISH THE INSTALLATION.
- E. CONTRACTOR SHALL INSTALL A GEOSYNTHETIC CLAY LINER (GCL) OVER THE SIDES AND FLOOR OF THE WAP AND SECURE IT IN A PERIMETER ANCHOR TRENCH/BATTEN AND STRIP.
- F. CONTRACTOR SHALL INSTALL A 60-MIL HDPE LINER DIRECTLY ON THE GCL AND SECURE IT IN A PERIMETER ANCHOR TRENCH/BATTEN AND STRIP.

GENERAL NOTES

1. ALL WORK UNDER THIS CONTRACT SHALL BE PERFORMED IN ACCORDANCE WITH THE PLANS AND PROJECT SPECIFICATIONS. IN THE EVENT OF A DISCREPANCY BETWEEN THE PLANS AND THE PROJECT SPECIFICATIONS, THE SPECIFICATIONS SHALL GOVERN.
2. COORDINATE SYSTEM IS BASED ON LOCAL SURVEY. THE BENCHMARKS TO BE USED FOR CONSTRUCTION ARE LOCATED AS SHOWN ON DRAWING NO. 00G-01. EXISTING CONTOURS ARE BASED ON TOPOGRAPHICAL SURVEY PERFORMED FEBRUARY 12-20, 2019 BY LACY SURVEYING. CURRENT GROUND ELEVATIONS MAY VARY FROM THOSE SHOWN DUE TO SITE WORK THAT HAS BEEN PERFORMED SINCE THE SURVEY WAS PERFORMED.
3. THE CONTRACTOR SHALL VERIFY EXISTING CONTOURS PRIOR TO THE START OF WORK.
4. THERE SHALL NOT BE ANY ADDITIONAL PAYMENT OR EXTENSION OF CONTRACT TIME FOR WORKING WITH SATURATED SOLS OR HANDLING WATER SEEPAGE DUE TO RAINFALL, RUNOFF AND INFILTRATION.
5. THE CONTRACTOR SHALL TAKE ALL NECESSARY PRECAUTIONS TO PROTECT EXISTING ROADS, BENCHMARKS AND EXISTING GROUNDWATER MONITOR WELLS DURING THE CONSTRUCTION PERIOD. THE CONTRACTOR SHALL BE SOLELY RESPONSIBLE FOR ANY AND ALL DAMAGES WHICH MIGHT BE INCURRED BY THE CONTRACTOR'S FAILURE TO EXACTLY LOCATE AND PROTECT THE GROUNDWATER MONITOR WELLS, BENCHMARKS AND EXISTING ROADS.
6. THE LOCATIONS OF EXISTING UNDERGROUND UTILITIES HAVE NOT BEEN ESTABLISHED BY THE OWNER OR ENGINEER. THE CONTRACTOR SHALL DETERMINE THE EXACT LOCATION OF ALL EXISTING UTILITIES BEFORE COMMENCING WORK, AND AGREES TO BE FULLY RESPONSIBLE FOR ANY AND ALL DAMAGES WHICH MIGHT BE OCCASIONED BY THE CONTRACTOR'S FAILURE TO EXACTLY LOCATE AND PRESERVE ANY AND ALL UTILITIES. THE CONTRACTOR SHALL BE RESPONSIBLE FOR MAINTAINING PROPER SAFE WORKING DISTANCE FROM ALL UTILITY EASEMENTS OR LINES.
7. EXCAVATION BY "BLASTING" IS NOT PERMITTED ON THIS PROJECT.
8. FINISHED GROUND ELEVATIONS SHALL MATCH EXISTING GROUND ELEVATIONS EXCEPT AS SHOWN ON THE PLANS. ALL EXCESS SOIL FROM THE EXCAVATION AND GRADING SHALL BE PLACED IN DESIGNATED STOCKPILE LOCATIONS AS APPROVED BY THE OWNER. IF WASTE IS ENCOUNTERED DURING EXCAVATION, THE OWNER SHALL BE NOTIFIED AND THE WASTE REMOVED AND PLACED IN AREAS DESIGNATED AS APPROVED BY THE OWNER. TRANSPORT OF SOIL TO FILL AREAS SHALL BE CONDUCTED BY THE CONTRACTOR AT NO ADDITIONAL EXPENSE TO THE OWNER.
9. GEOTECHNICAL INVESTIGATION REPORTS FOR THE SITE ARE AVAILABLE FOR REVIEW AT LUMINANT DALLAS OFFICES. THE CONTRACTOR MAY PERFORM ADDITIONAL GEOTECHNICAL INVESTIGATIONS, AS DEEMED NECESSARY FOR CONSTRUCTION ACTIVITIES. PROVIDED ALL NECESSARY PERMITS AND APPROVALS ARE OBTAINED FROM LUMINANT PRIOR TO INITIATING SUCH WORK, HOWEVER, THERE SHALL BE NO ADDITIONAL PAYMENT TO THE CONTRACTOR FOR ADDITIONAL GEOTECHNICAL INVESTIGATIONS.
10. THE CONTRACTOR SHALL CONSTRUCT, AND UPON COMPLETION OF THE PROJECT, REMOVE TEMPORARY CONSTRUCTION ACCESS ROADS. SUCH ROADS SHALL BE LOCATED AS APPROVED BY THE OWNER. DRAINAGE PATTERNS AT THE SITE SHALL NOT BE ALTERED BY ROAD CONSTRUCTION. THE CONTRACTOR SHALL BE RESPONSIBLE FOR CONSTRUCTION AND MAINTENANCE OF TEMPORARY DRAINAGE STRUCTURES, INCLUDING CULVERTS, AT NO ADDITIONAL COST TO THE OWNER.
11. THE CONTRACTOR SHALL INSTALL, MAINTAIN, AND UPON COMPLETION OF THE PROJECT, REMOVE TEMPORARY EROSION AND SEDIMENT CONTROLS AS APPROVED BY LUMINANT ENVIRONMENTAL SERVICES AND IN ACCORDANCE WITH THE SITE SWPPP AND PERMITS TO TPDES REQUIREMENTS. SUCH CONTROLS SHALL BE PLACED AT THE LIMITS OF DISTURBED AREAS AND AT INTERMEDIATE LOCATIONS WHERE CONCENTRATED FLOW IS LIKELY.
12. TEMPORARY CONSTRUCTION SLOPES SHALL NOT BE GREATER THAN 2H:1V. STEEPER SLOPES WILL ONLY BE ALLOWED IF THE CONTRACTOR PROVIDES A GEOTECHNICAL ENGINEERING REPORT SPECIFYING MAXIMUM SLOPES AND THE DURATION FOR WHICH SUCH SLOPES SHALL REMAIN IN PLACE.
13. THE CONTRACTOR SHALL REMOVE ALL VEGETATION WITHIN THE CONSTRUCTION LIMITS AS REQUIRED TO CONSTRUCT THE PROJECT. ALL VEGETATION SHALL BE REMOVED BY CONTRACTOR AT NO ADDITIONAL EXPENSE TO OWNER.
14. THE CONTRACTOR SHALL OBTAIN AND CONDUCT WORK CONSISTENT WITH A TPDES PERMIT FOR CONSTRUCTION, REFER TO TECHNICAL SPECIFICATIONS. PREPARATION OF A SWPPP AND OBTAINING THE TPDES PERMIT ARE THE CONTRACTOR'S RESPONSIBILITY.
15. THE CONTRACTOR SHALL IMMEDIATELY REPORT TO THE ENGINEER ANY ERROR OR DISCREPANCY FOUND ONCE THE CONTRACT DOCUMENT IS CAREFULLY REVIEWED AND ALL ASPECTS OF FIELD WORK HAVE BEEN VERIFIED. IN THE EVENT THE CONTRACTOR CONTINUES TO WORK ON AN ITEM WHERE AN ERROR EXISTS, IT SHALL BE DEEMED THAT THE CONTRACTOR BID AND INTENDED TO EXECUTE THE MORE STRINGENT OR HIGHER QUALITY REQUIREMENT WITHOUT AN INCREASE IN CONTRACT SUM OR TIME. THE CONTRACTOR SHALL ALSO BE RESPONSIBLE TO CORRECT ANY FAILURE OF COMPANY PARTS TO COORDINATE OR FIT PROPERLY INTO FINAL POSITION, AS A RESULT OF CONTRACTOR FAILURE TO RAISE OR RESOLVE A DISCREPANCY.
16. THE DRAWINGS AND SPECIFICATIONS SHOULD AGREE WITH EACH OTHER, AND WORK CALLED FOR BY DRAWINGS AND NOT MENTIONED IN SPECIFICATION, OR VICE VERSA, SHALL BE FURNISHED BY BOTH. WHEN DISCREPANCIES EXIST BETWEEN SCALE AND DIMENSIONS, THE DIMENSIONED FIGURE SHALL BE USED.
17. CONTRACTOR AND EACH SUBCONTRACTOR SHALL VERIFY ALL GRADES, LINES, LEVELS, AND DIMENSIONS AS INDICATED ON DRAWINGS, AND HE SHALL REPORT ERRORS TO THE ENGINEER BEFORE COMMENCING WORK. THE CONTRACTOR SHALL ESTABLISH BENCHMARKS IN AT LEAST TWO WIDELY SEPARATED PLACES, AND AS WORK PROGRESSES THE CONTRACTOR WILL MAINTAIN ADEQUATE HORIZONTAL AND VERTICAL CONTROL.
18. CONTRACTOR SHALL PROVIDE EROSION CONTROL BY SEEDING FOR ALL AREAS DISTURBED BY CONTRACTOR DURING THE CONSTRUCTION OF THIS PROJECT. THE CONTRACTOR SHALL NOT DISTURB ANY AREA WITHOUT THE APPROVAL OF THE ENGINEER. EROSION CONTROL BY SEEDING SHALL CONFORM TO STANDARD SPECIFICATION 02930.
19. CONTRACTOR SHALL INSTALL EROSION AND SEDIMENT CONTROLS AS PER SPECIFICATIONS DURING CONSTRUCTION. SUCH CONTROLS SHALL BE PLACED AT LIMITS OF DISTURBED AREAS AND AT INTERMEDIATE LOCATIONS WHERE CONCENTRATED FLOW IS LIKELY.
20. STORMWATER THAT HAS COME INTO CONTACT WITH THE ASH WITHIN THE EXCAVATED POND IS TO BE CONSIDERED CONTACT STORMWATER. CONTRACTOR WILL CONTROL THE WATER ON SITE IN COMPLIANCE WITH THE TPDES PERMIT.
21. THE CONTRACTOR IS REQUIRED TO PRESENT THE SWPPP TO LUMINANT ENVIRONMENTAL SERVICES FOR APPROVAL PRIOR TO THE COMMENCEMENT OF CONSTRUCTION ACTIVITIES.
22. THE CONTRACTOR IS REQUIRED TO SUBMIT THE NOTICE OF INTENT AND NOTICE OF TERMINATION FOR THE TPDES PERMIT.
23. THE CONTRACTOR IS TO ACQUIRE A DIGGING PERMIT FROM THE PLANT BEFORE COMMENCING ANY EXCAVATION ACTIVITY.



ISSUE	DATE	DESCRIPTION
A	01/31/2020	ISSUED FOR BID

PROJECT MANAGER	D. VOGT, P.E.
DESIGNED BY	K. PERERA
DRAWN BY	J. RAYMOND
CHECKED BY	M. ROBERTS
PROJECT NUMBER	10172630




MARTIN LAKE STEAM ELECTRICAL STATION
WEST ASH POND RELINE
RUSK COUNTY, TEXAS

ABBREVIATIONS AND GENERAL NOTES



FILENAME 00G-02.dwg
SCALE
SHEET 00G-02

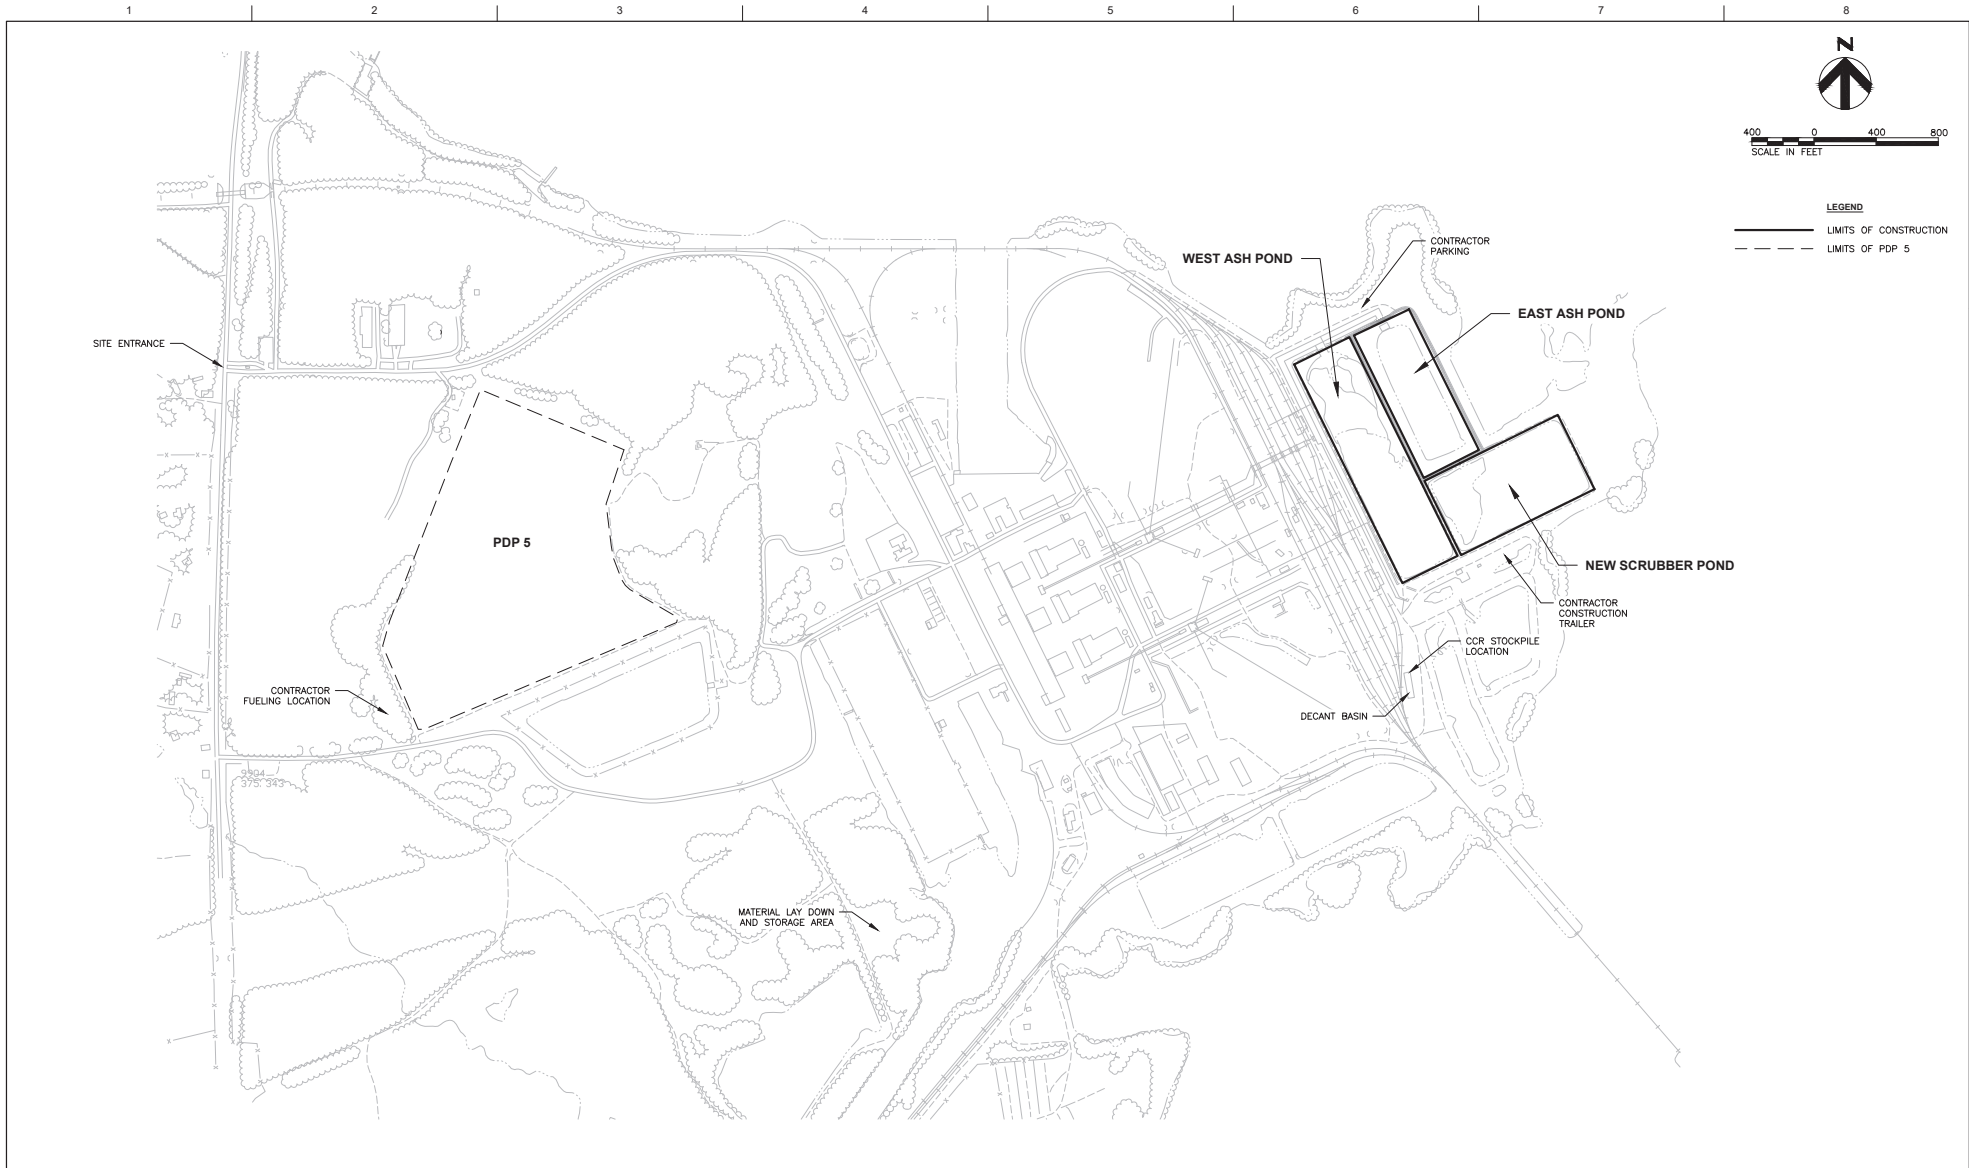

ISSUE	DATE	DESCRIPTION
A	01/31/2020	ISSUED FOR BID

PROJECT MANAGER	D. VOGT, P.E.
DESIGNED BY	K. PERERA
DRAWN BY	J. RAYMOND
CHECKED BY	M. ROBERTS
PROJECT NUMBER	10172630




MARTIN LAKE STEAM ELECTRICAL STATION
WEST ASH POND RELINE
RUSK COUNTY, TEXAS



FILENAME | 00C-01.dwg
SCALE | 1" = 400'

SHEET
00C-01

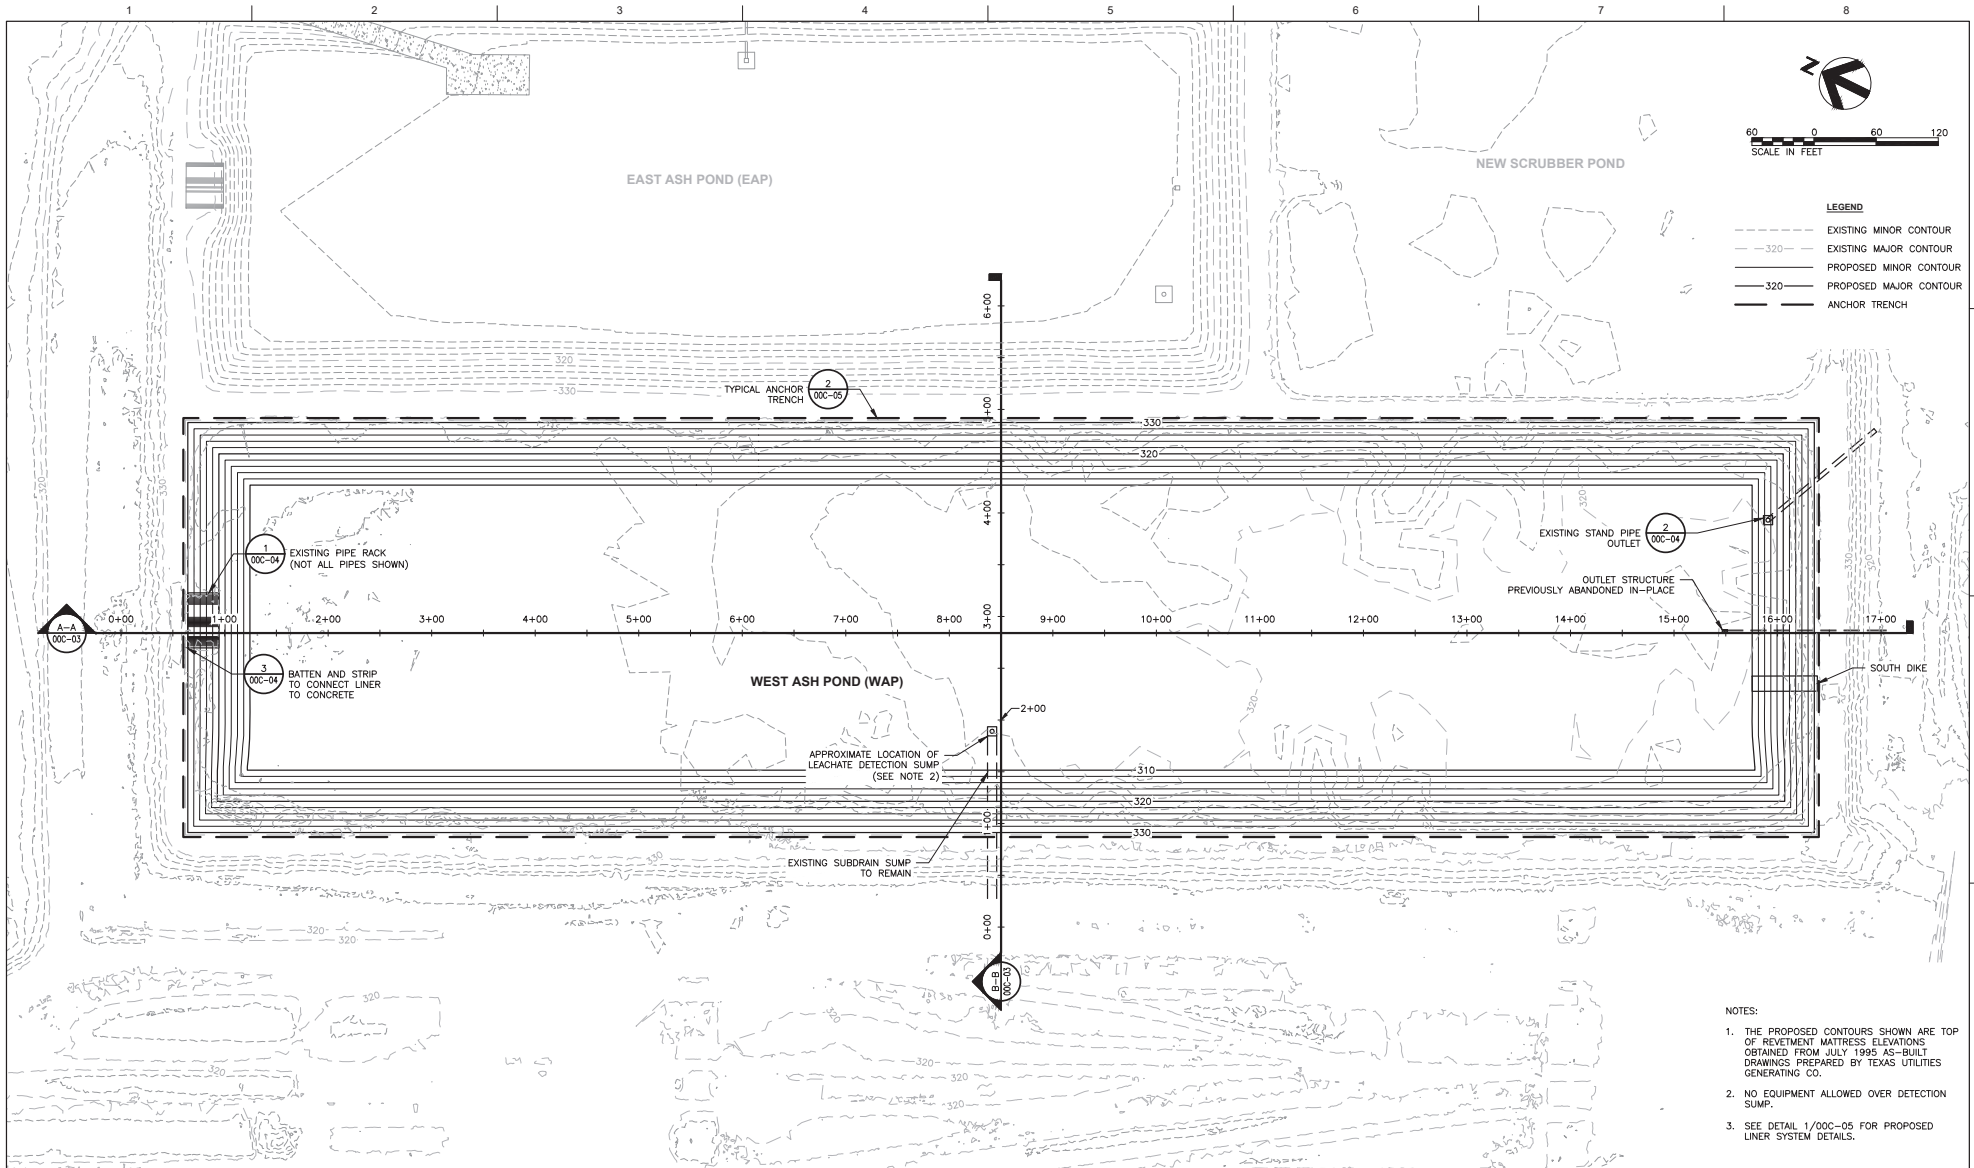


- LEGEND**
- - - - - EXISTING MINOR CONTOUR
 - - - - - EXISTING MAJOR CONTOUR
 - - - - - PROPOSED MINOR CONTOUR
 - - - - - PROPOSED MAJOR CONTOUR
 - — — — ANCHOR TRENCH

- NOTES:**
1. THE PROPOSED CONTOURS SHOWN ARE TOP OF RETEMENT MATTRESS ELEVATIONS OBTAINED FROM JULY 1995 AS-BUILT DRAWINGS PREPARED BY TEXAS UTILITIES GENERATING CO.
 2. NO EQUIPMENT ALLOWED OVER DETECTION SUMP.
 3. SEE DETAIL 1/00C-05 FOR PROPOSED LINER SYSTEM DETAILS.



ISSUE	DATE	DESCRIPTION
A	01/31/2020	ISSUED FOR BID

PROJECT MANAGER	D. VOGT, P.E.
DESIGNED BY	K. PERERA
DRAWN BY	J. RAYMOND
CHECKED BY	M. ROBERTS
PROJECT NUMBER	10172630

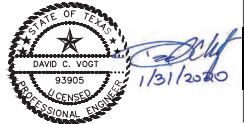


**MARTIN LAKE STEAM ELECTRICAL STATION
WEST ASH POND RELINE
RUSK COUNTY, TEXAS**





FILENAME: 00C-02.dwg
SCALE: 1" = 60'

SHEET
00C-02

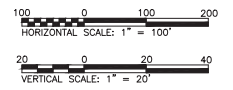

LEGEND
 - - - - - TOP OF CCR MATERIAL
 - - - - - EXISTING GROUND SURFACE
 _____ PROPOSED GRADE

NOTES:
 1. CCR ELEVATION FROM BATHYMETRIC SURVEY TAKEN FEBRUARY 2019 BY LACEY SURVEYING OF ARP, TEXAS. AT START OF PROJECT, OWNER WILL HAVE REMOVED BULK OF CCR MATERIAL FROM THE WEST ASH POND.
 2. CONTRACTOR WILL REMOVE REMAINING CCR MATERIAL, ROCKS AND SEDIMENT WITHIN POND BEFORE INSTALLATION OF THE LINER SYSTEM.

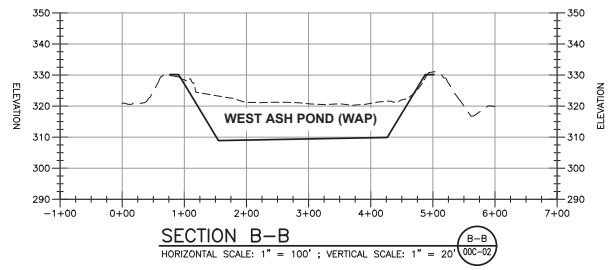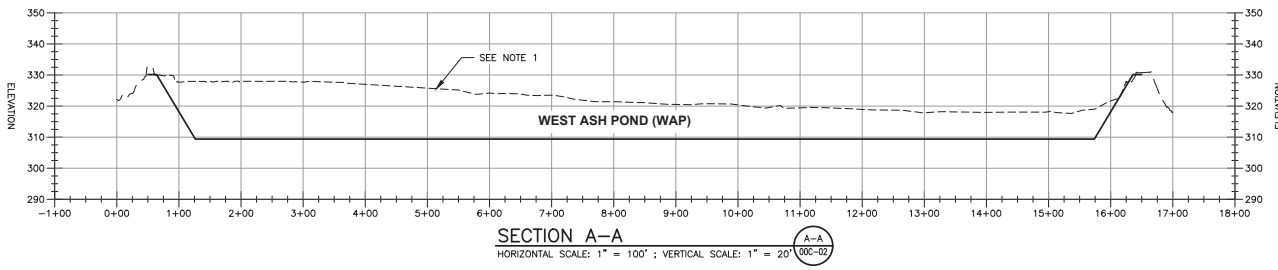

ISSUE	DATE	DESCRIPTION
A	01/31/2020	ISSUED FOR BID

PROJECT MANAGER	D. VOGT, P.E.
DESIGNED BY	K. PERERA
DRAWN BY	J. RAYMOND
CHECKED BY	M. ROBERTS
PROJECT NUMBER	10172630




MARTIN LAKE STEAM ELECTRICAL STATION
 WEST ASH POND RELINE
 RUSK COUNTY, TEXAS



CROSS SECTIONS



FILENAME: 00C-03.dwg
 SHEET: 00C-03

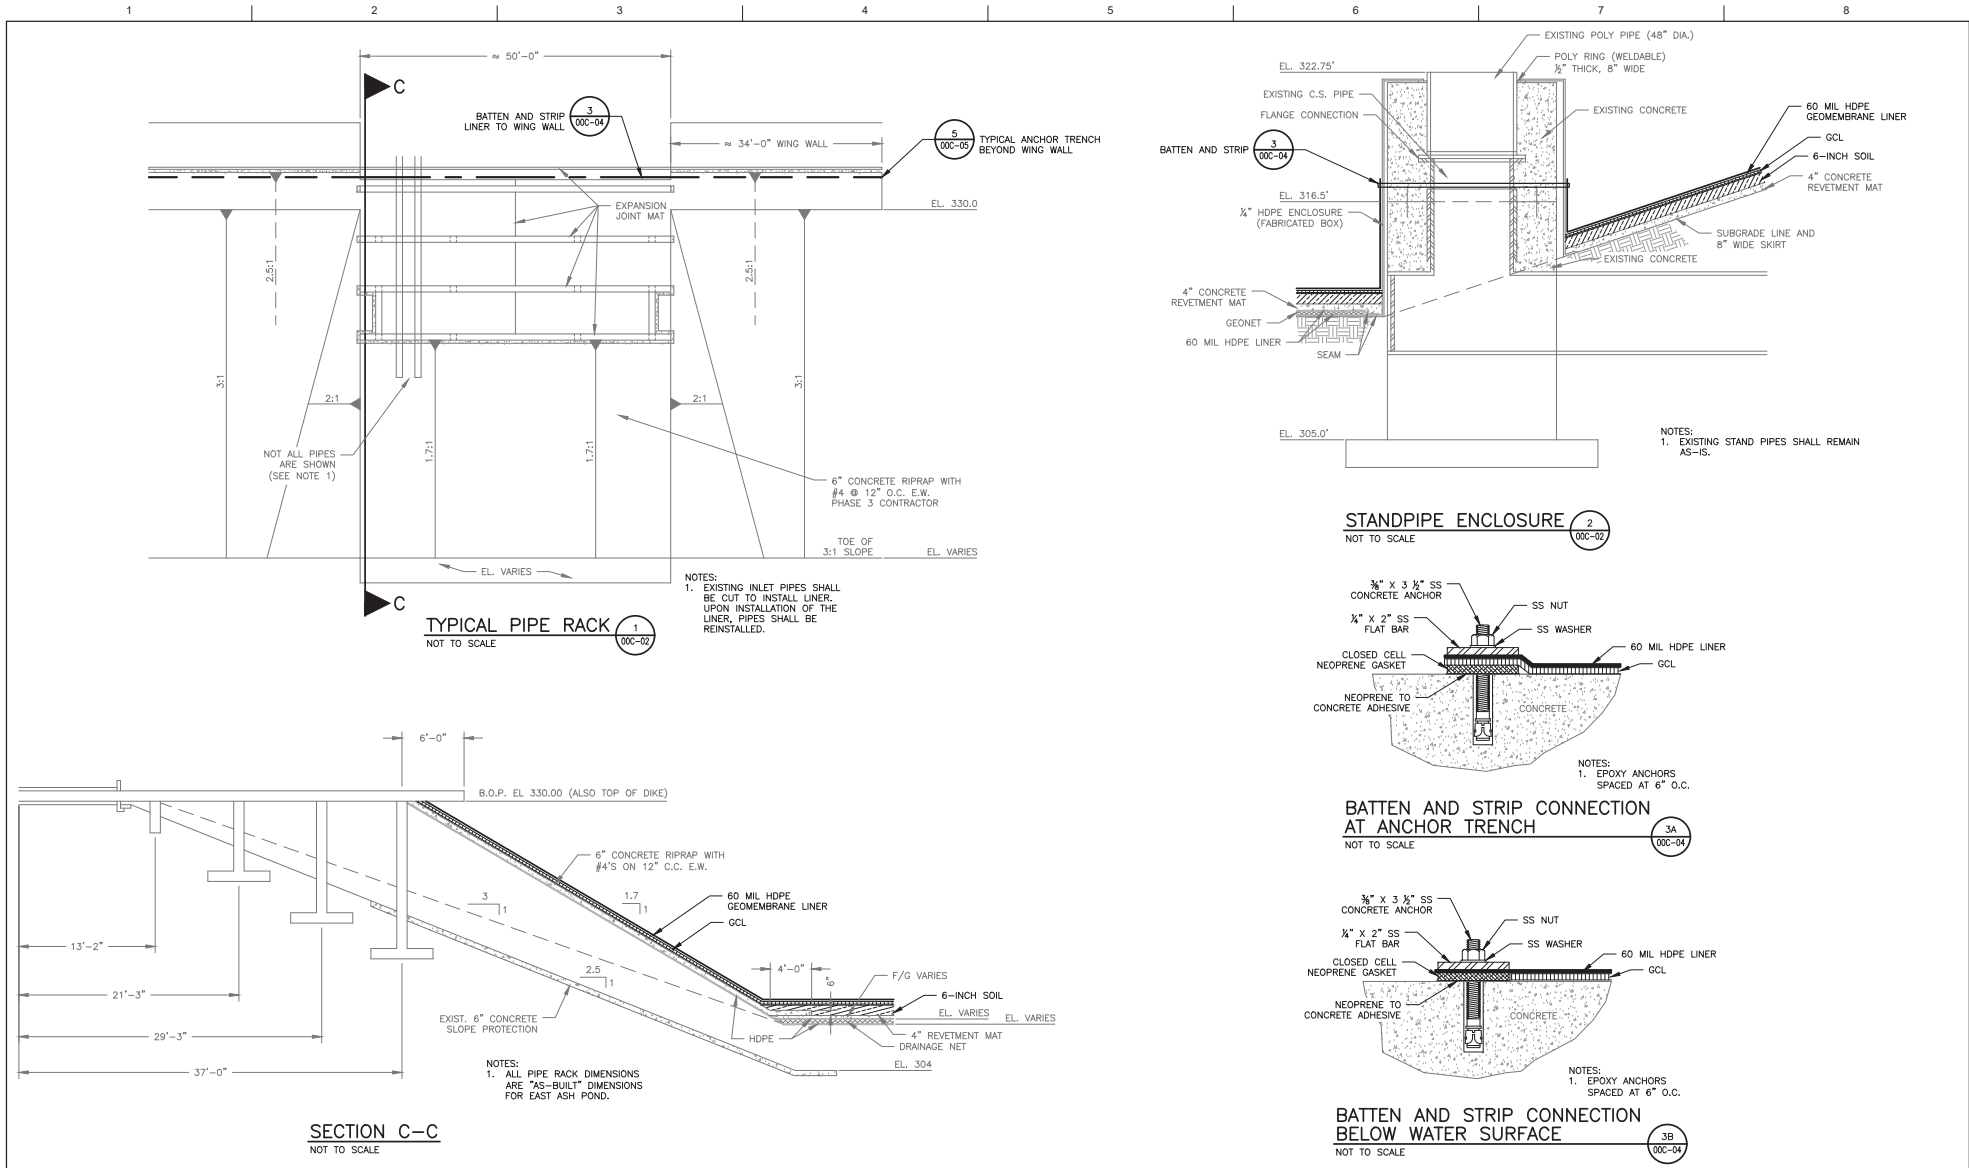

ISSUE	DATE	DESCRIPTION
A	01/31/2020	ISSUED FOR BID

PROJECT MANAGER	D. VOGT, P.E.
DESIGNED BY	K. PERERA
DRAWN BY	J. RAYMOND
CHECKED BY	M. ROBERTS
PROJECT NUMBER	10172630




MARTIN LAKE STEAM ELECTRICAL STATION
WEST ASH POND RELINE
RUSK COUNTY, TEXAS




FILENAME 00C-04.dwg
SCALE

SHEET
00C-04


DETAILS
(1 OF 2)

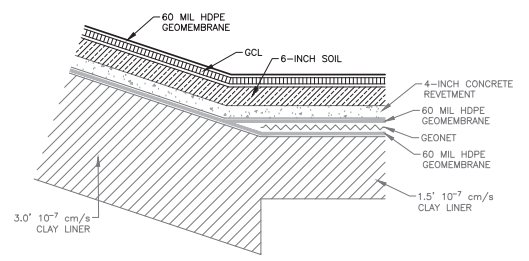

PROPOSED WAP SECTION 1
NOT TO SCALE 00C-05

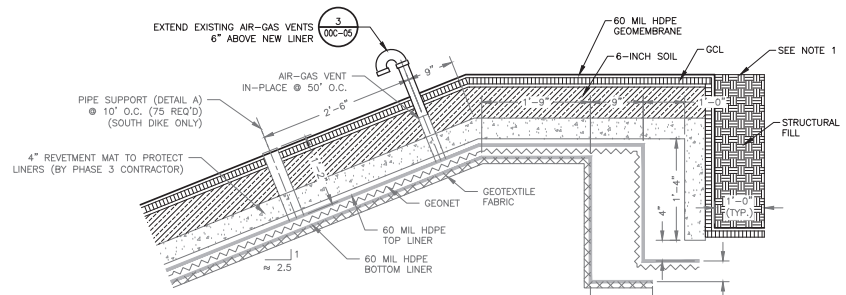

NOTES:
1. THE ANCHOR TRENCH SHALL BE INSTALLED OUTSIDE OF THE EXISTING ANCHOR TRENCH.
ANCHOR TRENCH 2
NOT TO SCALE 00C-02

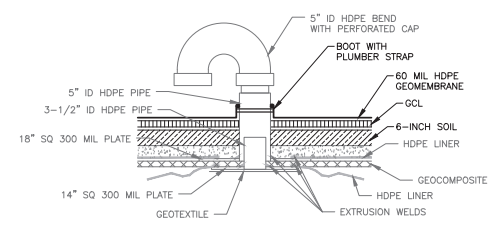

TYPICAL AIR-GAS VENT 3
NOT TO SCALE 00C-05



ISSUE	DATE	DESCRIPTION
A	01/31/2020	ISSUED FOR BID

PROJECT MANAGER	D. VOGT, P.E.
DESIGNED BY	K. PERERA
DRAWN BY	J. RAYMOND
CHECKED BY	M. ROBERTS
PROJECT NUMBER	10172630



MARTIN LAKE STEAM ELECTRICAL STATION
WEST ASH POND RELINE
RUSK COUNTY, TEXAS



FILENAME 00C-05.dwg
SCALE NOT TO SCALE


SHEET
00C-05

DETAILS
(2 OF 2)



A	01/31/2020	ISSUED FOR BID
ISSUE	DATE	DESCRIPTION


PROJECT MANAGER	D. VOGT, P.E.
DESIGNED BY	K. PERERA
DRAWN BY	J. RAYMOND
CHECKED BY	M. ROBERTS
PROJECT NUMBER	10172630

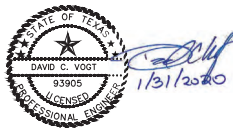

MARTIN LAKE STEAM ELECTRICAL STATION
 WEST ASH POND RELINE
 RUSK COUNTY, TEXAS



STOCKPILE AND HAUL ROUTE

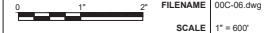

SHEET
00C-06



HDR ENGINEERING, INC.
76 SOUTH LAURA STREET, SUITE 1600
JACKSONVILLE, FL 32202
COA# 4213



VICINITY MAP
NOT TO SCALE

Construction Drawings For

Martin Lake Steam Electric Station

CCR Impoundment Reline New Scrubber Pond

Project No.
10172630

Rusk County, Texas
January 2020

INDEX OF DRAWINGS

GENERAL	
00G-01	COVER SHEET
00G-02	ABBREVIATIONS AND GENERAL NOTES
CIVIL	
00C-01	SITE LAYOUT
00C-02	NEW SCRUBBER POND
00C-03	ROSS SECTIONS
00C-04	DETAILS (1 OF 2)
00C-05	DETAILS (2 OF 2)
00C-06	STOCKPILE AND HAUL ROUTE




STANDARD ABBREVIATIONS

& APPROX	AND APPROXIMATELY	NTS	NOT TO SCALE
AVG	AT	NTYS	NORTH THICKENER YARD SUMP
BOE	AVERAGE	OC	ON CENTER
BOL	BOTTOM OF EXCAVATION	OZ	ONCE
X	BOTTOM OF LINER	%	PERCENT
CL	BY	PLCP	PERFORATED LEACHATE COLLECTION PIPE
CMP	CENTERLINE	PERF	PERFORATED
CO	CORRUGATED METAL PIPE	ROL	PROFILE GRADE LINE
CY	CLEAN OUT	PDP	PERMANENT DISPOSAL POND
DIA	CUBIC YARD	PC	POINT OF CURVATURE
DET	DIAMETER	PI	POINT OF INTERSECTION
DWG	DRAWING	PVI	POINT OF VERTICAL INTERSECTION
E	EAST	PT	POINT OF TANGENT
EAP	EAST ASH POND	PZ	PIEZOMETER
ELEV	ELEVATION	Q	FLOW
EW	EACH WAY	QTY	QUANTITY
EXIST	EXISTING	R	RADIUS
EXC	EXCAVATION	RCP	REINFORCED CONCRETE PIPE
FGD	FLUE GAS DESULFURATION	REF	REFERENCE
FML	FLEXIBLE MEMBRANE LINER	REQ	REQUIRED
FT	FEET	RD	ROAD
GAL	GALLON	SCH	SCHEDULE
GND	GROUND	SDL	SAND DRAINAGE LAYER
GDL	GRAVEL DRAINAGE LAYER	SEC	SECTION
GNDL	GEONET DRAINAGE LAYER	SHT	SHEET
HDPE	HIGH DENSITY POLYETHYLENE	S	SOUTH
HORIZ	HORIZONTAL	SDR	STANDARD DIMENSION RATIO
ID	INSIDE DIAMETER	SLQCP	SOIL LINER QUALITY CONTROL PLAN
IN	INCHES	SP	STEEL PIPE
IE	INVERT ELEVATION	SQ	SQUARE
LORS	LEACHATE COLLECTION AND REMOVAL SYSTEM	SS	SIDE SLOPE
LCS	LEACHATE COLLECTION SYSTEM	STA	STATION
LCP	LEACHATE COLLECTION PIPE	STYS	SOUTH THICKENER YARD SUMP
LCPR	LEACHATE COLLECTION PIPE RISER	T.A.S.	TERMINAL ANCHOR SECTION
LF	LINEAR FEET	TL	TANGENT LENGTH
LB	POUND	TOC	TOP OF COVER
MH	MANHOLE	TOFL	TOP OF FINAL COVER
MAX	MAXIMUM	TOL	TOP OF LINER
ML	.001 INCHES	TOS	TOE OF SLOPE
MIN	MINIMUM	TS	TOP SLOPE
MW	MONITOR WELL	TEMP	TEMPORARY
MLSES	MARTIN LAKE STEAM ELECTRIC STATION	TYP	TYPICAL
MSL	MEAN SEA LEVEL	UNLESS NOTED OTHERWISE	
N	NORTH	VERT	VERTICAL
NIC	NOT IN CONTRACT	W/	WITH
NO	NUMBER	W/	WEST ASH POND
		WW	WETWELL
		YD	YARD


SYMBOLS

SECTION DETAIL INDICATORS


DRAWING ON WHICH SECTION IS CUT:

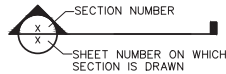




DRAWING ON WHICH SECTION APPEARS:

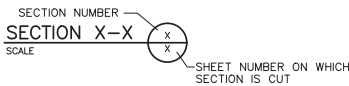


DRAWING ON WHICH DETAIL IS INDICATED:

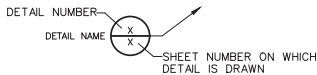

DRAWING ON WHICH DETAIL APPEARS:

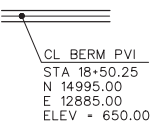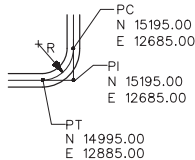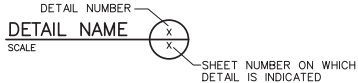

VERTICAL CONTROL DESIGNATION

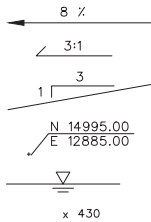

CONSTRUCTION SEQUENCE

- A. CONTRACTOR SHALL CLEAN THE NSP BY REMOVING ANY REMAINING CCR MATERIAL, ROCKS, AND SEDIMENT.
- B. CONTRACTOR SHALL USE WATER FROM THE ADJACENT WEST ASH POND (WAP) OR EAST ASH POND (EAP) TO WASH REMAINING CCR MATERIAL OFF THE SIDES AND FLOOR OF THE NSP AND REMOVE IT. EAP WILL BE VISUALLY INSPECTED BY OWNER'S COA CONSULTANT TO CONFIRM CCR MATERIAL, ROCKS, AND SEDIMENT HAVE BEEN REMOVED.
- C. CONTRACTOR SHALL LOAD AND HAUL GENERAL SOIL FILL MATERIAL FROM THE OWNER'S STOCKPILE LOCATED AT LIBERTY MINE, A LOCATION UNDER THE PROVISIONS OF THE MINE SAFETY AND HEALTH ADMINISTRATION (MSHA) AND APPROXIMATELY 4.5 MILES FROM EAP.
- D. CONTRACTOR SHALL PLACE THE GENERAL FILL MATERIAL OVER THE EXISTING CONCRETE RETEMENT TO A DEPTH OF AT LEAST SIX (6) INCHES, NOMINALLY COMPACT, AND SMOOTH ROLL TO FINISH THE INSTALLATION.
- E. CONTRACTOR SHALL INSTALL A GEOSYNTHETIC CLAY LINER (GCL) OVER THE SIDES AND FLOOR OF THE NSP AND SECURE IT IN A PERIMETER ANCHOR TRENCH/BATTEN AND STRIP.
- F. CONTRACTOR SHALL INSTALL A 60-MIL HDPE LINER DIRECTLY ON THE GCL AND SECURE IT IN A PERIMETER ANCHOR TRENCH/BATTEN AND STRIP.

GENERAL NOTES

1. ALL WORK UNDER THIS CONTRACT SHALL BE PERFORMED IN ACCORDANCE WITH THE PLANS AND PROJECT SPECIFICATIONS. IN THE EVENT OF A DISCREPANCY BETWEEN THE PLANS AND THE PROJECT SPECIFICATIONS, THE SPECIFICATIONS SHALL GOVERN.
2. COORDINATE SYSTEM IS BASED ON LOCAL SURVEY. THE BENCHMARKS TO BE USED FOR CONSTRUCTION ARE LOCATED AS SHOWN ON DRAWING NO. 00G-01. EXISTING CONTOURS ARE BASED ON TOPOGRAPHICAL SURVEY PERFORMED FEBRUARY 12-20, 2019 BY LACY SURVEYING. CURRENT GROUND ELEVATIONS MAY VARY FROM THOSE SHOWN DUE TO SITE WORK THAT HAS BEEN PERFORMED SINCE THE SURVEY WAS PERFORMED.
3. THE CONTRACTOR SHALL VERIFY EXISTING CONTOURS PRIOR TO THE START OF WORK.
4. THERE SHALL NOT BE ANY ADDITIONAL PAYMENT OR EXTENSION OF CONTRACT TIME FOR WORKING WITH SATURATED SOLS OR HANDLING WATER SEEPAGE DUE TO RAINFALL, RUNOFF AND INFILTRATION.
5. THE CONTRACTOR SHALL TAKE ALL NECESSARY PRECAUTIONS TO PROTECT EXISTING ROADS, BENCHMARKS AND EXISTING GROUNDWATER MONITOR WELLS DURING THE CONSTRUCTION PERIOD. THE CONTRACTOR SHALL BE SOLELY RESPONSIBLE FOR ANY AND ALL DAMAGES WHICH MIGHT BE INCURRED BY THE CONTRACTOR'S FAILURE TO EXACTLY LOCATE AND PROTECT THE GROUNDWATER MONITOR WELLS, BENCHMARKS AND EXISTING ROADS.
6. THE LOCATIONS OF EXISTING UNDERGROUND UTILITIES HAVE NOT BEEN ESTABLISHED BY THE OWNER OR ENGINEER. THE CONTRACTOR SHALL DETERMINE THE EXACT LOCATION OF ALL EXISTING UTILITIES BEFORE COMMENCING WORK, AND AGREES TO BE FULLY RESPONSIBLE FOR ANY AND ALL DAMAGES WHICH MIGHT BE OCCASIONED BY THE CONTRACTORS FAILURE TO EXACTLY LOCATE AND PRESERVE ANY AND ALL UTILITIES. THE CONTRACTOR SHALL BE RESPONSIBLE FOR MAINTAINING PROPER SAFE WORKING DISTANCE FROM ALL UTILITY EASEMENTS OR LINES.
7. EXCAVATION BY "BLASTING" IS NOT PERMITTED ON THIS PROJECT.
8. FINISHED GROUND ELEVATIONS SHALL MATCH EXISTING GROUND ELEVATIONS EXCEPT AS SHOWN ON THE PLANS. ALL EXCESS SOIL FROM THE EXCAVATION AND GRADING SHALL BE PLACED IN DESIGNATED STOCKPILE LOCATIONS AS APPROVED BY THE OWNER. IF WASTE IS ENCOUNTERED DURING EXCAVATION, THE OWNER SHALL BE NOTIFIED AND THE WASTE REMOVED AND PLACED IN AREAS DESIGNATED AS APPROVED BY THE OWNER. TRANSPORT OF SOIL TO FILL AREAS SHALL BE CONDUCTED BY THE CONTRACTOR AT NO ADDITIONAL EXPENSE TO THE OWNER.
9. GEOTECHNICAL INVESTIGATION REPORTS FOR THE SITE ARE AVAILABLE FOR REVIEW AT LUMINANT'S DALLAS OFFICES. THE CONTRACTOR MAY PERFORM ADDITIONAL GEOTECHNICAL INVESTIGATIONS, AS DEEMED NECESSARY FOR CONSTRUCTION OF TEMPORARY STRUCTURES, INCLUDING CULVERTS, AT NO ADDITIONAL COST TO THE CONTRACTOR PRIOR TO INITIATING SUCH WORK. HOWEVER, THERE SHALL BE NO ADDITIONAL PAYMENT TO THE CONTRACTOR FOR ADDITIONAL GEOTECHNICAL INVESTIGATIONS.
10. THE CONTRACTOR SHALL CONSTRUCT, AND UPON COMPLETION OF THE PROJECT, REMOVE TEMPORARY CONSTRUCTION ACCESS ROADS. SUCH ROADS SHALL BE LOCATED AS APPROVED BY THE OWNER. DRAINAGE PATTERNS AT THE SITE SHALL NOT BE ALTERED BY ROAD CONSTRUCTION. THE CONTRACTOR SHALL BE RESPONSIBLE FOR CONSTRUCTION AND MAINTENANCE OF TEMPORARY DRAINAGE STRUCTURES, INCLUDING CULVERTS, AT NO ADDITIONAL COST TO THE OWNER.
11. THE CONTRACTOR SHALL INSTALL, MAINTAIN, AND UPON COMPLETION OF THE PROJECT, REMOVE TEMPORARY EROSION AND SEDIMENT CONTROLS AS APPROVED BY LUMINANT ENVIRONMENTAL SERVICES AND IN ACCORDANCE WITH THE SITE SWPPP AND PERMITS TO TPDES REQUIREMENTS. SUCH CONTROLS SHALL BE PLACED AT THE LIMITS OF DISTURBED AREAS AND AT INTERMEDIATE LOCATIONS WHERE CONCENTRATED FLOW IS LIKELY.
12. TEMPORARY CONSTRUCTION SLOPES SHALL NOT BE GREATER THAN 2H:1V. STEEPER SLOPES WILL ONLY BE ALLOWED IF THE CONTRACTOR PROVIDES A GEOTECHNICAL ENGINEERING REPORT SPECIFYING MAXIMUM SLOPES AND THE DURATION FOR WHICH SUCH SLOPES SHALL REMAIN IN PLACE.
13. THE CONTRACTOR SHALL REMOVE ALL VEGETATION WITHIN THE CONSTRUCTION LIMITS AS REQUIRED TO CONSTRUCT THE PROJECT. ALL VEGETATION SHALL BE REMOVED BY CONTRACTOR AT NO ADDITIONAL EXPENSE TO OWNER.
14. THE CONTRACTOR SHALL OBTAIN AND CONDUCT WORK CONSISTENT WITH A TPDES PERMIT FOR CONSTRUCTION, REFER TO TECHNICAL SPECIFICATIONS. PREPARATION OF A SWPPP AND OBTAINING THE TPDES PERMIT ARE THE CONTRACTORS RESPONSIBILITY.
15. THE CONTRACTOR SHALL IMMEDIATELY REPORT TO THE ENGINEER ANY ERROR OR DISCREPANCY FOUND ONCE THE CONTRACT DOCUMENT IS CAREFULLY REVIEWED AND ALL ASPECTS OF FIELD WORK HAVE BEEN VERIFIED. IN THE EVENT THE CONTRACTOR CONTINUES TO WORK ON AN ITEM WHERE AN ERROR EXISTS, IT SHALL BE DEEMED THAT THE CONTRACTOR BID AND INTENDED TO EXECUTE THE MORE STRINGENT OR HIGHER QUALITY REQUIREMENT WITHOUT AN INCREASE IN CONTRACT SUM OR TIME. THE CONTRACTOR SHALL ALSO BE RESPONSIBLE TO CORRECT ANY FAILURE OF COMPANY PARTS TO COORDINATE OR FIT PROPERLY INTO FINAL POSITION, AS A RESULT OF CONTRACTOR FAILURE TO RAISE OR RESOLVE A DISCREPANCY.
16. THE DRAWINGS AND SPECIFICATIONS SHOULD AGREE WITH EACH OTHER, AND WORK CALLED FOR BY DRAWINGS AND NOT MENTIONED IN SPECIFICATION, OR VICE VERSA, SHALL BE FURNISHED BY BOTH. WHEN DISCREPANCIES EXIST BETWEEN SCALE AND DIMENSIONS, THE DIMENSIONED FIGURE SHALL BE USED.
17. CONTRACTOR AND EACH SUBCONTRACTOR SHALL VERIFY ALL GRADES, LINES, LEVELS, AND DIMENSIONS AS INDICATED ON DRAWINGS, AND HE SHALL REPORT ERRORS TO THE ENGINEER BEFORE COMMENCING WORK. THE CONTRACTOR SHALL ESTABLISH BENCHMARKS IN AT LEAST TWO WIDELY SEPARATED PLACES, AND AS WORK PROGRESSES THE CONTRACTOR WILL MAINTAIN ADEQUATE HORIZONTAL AND VERTICAL CONTROL.
18. CONTRACTOR SHALL PROVIDE EROSION CONTROL BY SEEDING FOR ALL AREAS DISTURBED BY CONTRACTOR DURING THE CONSTRUCTION OF THIS PROJECT. THE CONTRACTOR SHALL NOT DISTURB ANY AREA WITHOUT THE APPROVAL OF THE ENGINEER. EROSION CONTROL BY SEEDING SHALL CONFORM TO STANDARD SPECIFICATION 02930.
19. CONTRACTOR SHALL INSTALL EROSION AND SEDIMENT CONTROLS AS PER SPECIFICATIONS DURING CONSTRUCTION. SUCH CONTROLS SHALL BE PLACED AT LIMITS OF DISTURBED AREAS AND AT INTERMEDIATE LOCATIONS WHERE CONCENTRATED FLOW IS LIKELY.
20. STORMWATER THAT HAS COME INTO CONTACT WITH THE ASH WITHIN THE EXCAVATED POND IS TO BE CONSIDERED CONTACT STORMWATER. CONTRACTOR WILL CONTROL THE WATER ON SITE IN COMPLIANCE WITH THE TPDES PERMIT.
21. THE CONTRACTOR IS REQUIRED TO PRESENT THE SWPPP TO LUMINANT ENVIRONMENTAL SERVICES FOR APPROVAL PRIOR TO THE COMMENCEMENT OF CONSTRUCTION ACTIVITIES.
22. THE CONTRACTOR IS REQUIRED TO SUBMIT THE NOTICE OF INTENT AND NOTICE OF TERMINATION FOR THE TPDES PERMIT.
23. THE CONTRACTOR IS TO ACQUIRE A DIGGING PERMIT FROM THE PLANT BEFORE COMMENCING ANY EXCAVATION ACTIVITY.



PROJECT MANAGER	D. VOGT, P.E.	
DESIGNED BY	K. PERERA	
DRAWN BY	J. RAYMOND	
CHECKED BY	M. ROBERTS	
ISSUE	DATE	DESCRIPTION
A	01/31/2020	ISSUED FOR BID

PROJECT NUMBER	10172630
----------------	----------




MARTIN LAKE STEAM ELECTRICAL STATION
NEW SCRUBBER POND RELINE
RUSK COUNTY, TEXAS

ABBREVIATIONS AND GENERAL NOTES



FILENAME: 00G-02.dwg
SCALE: 1"=40'
SHEET: 00G-02

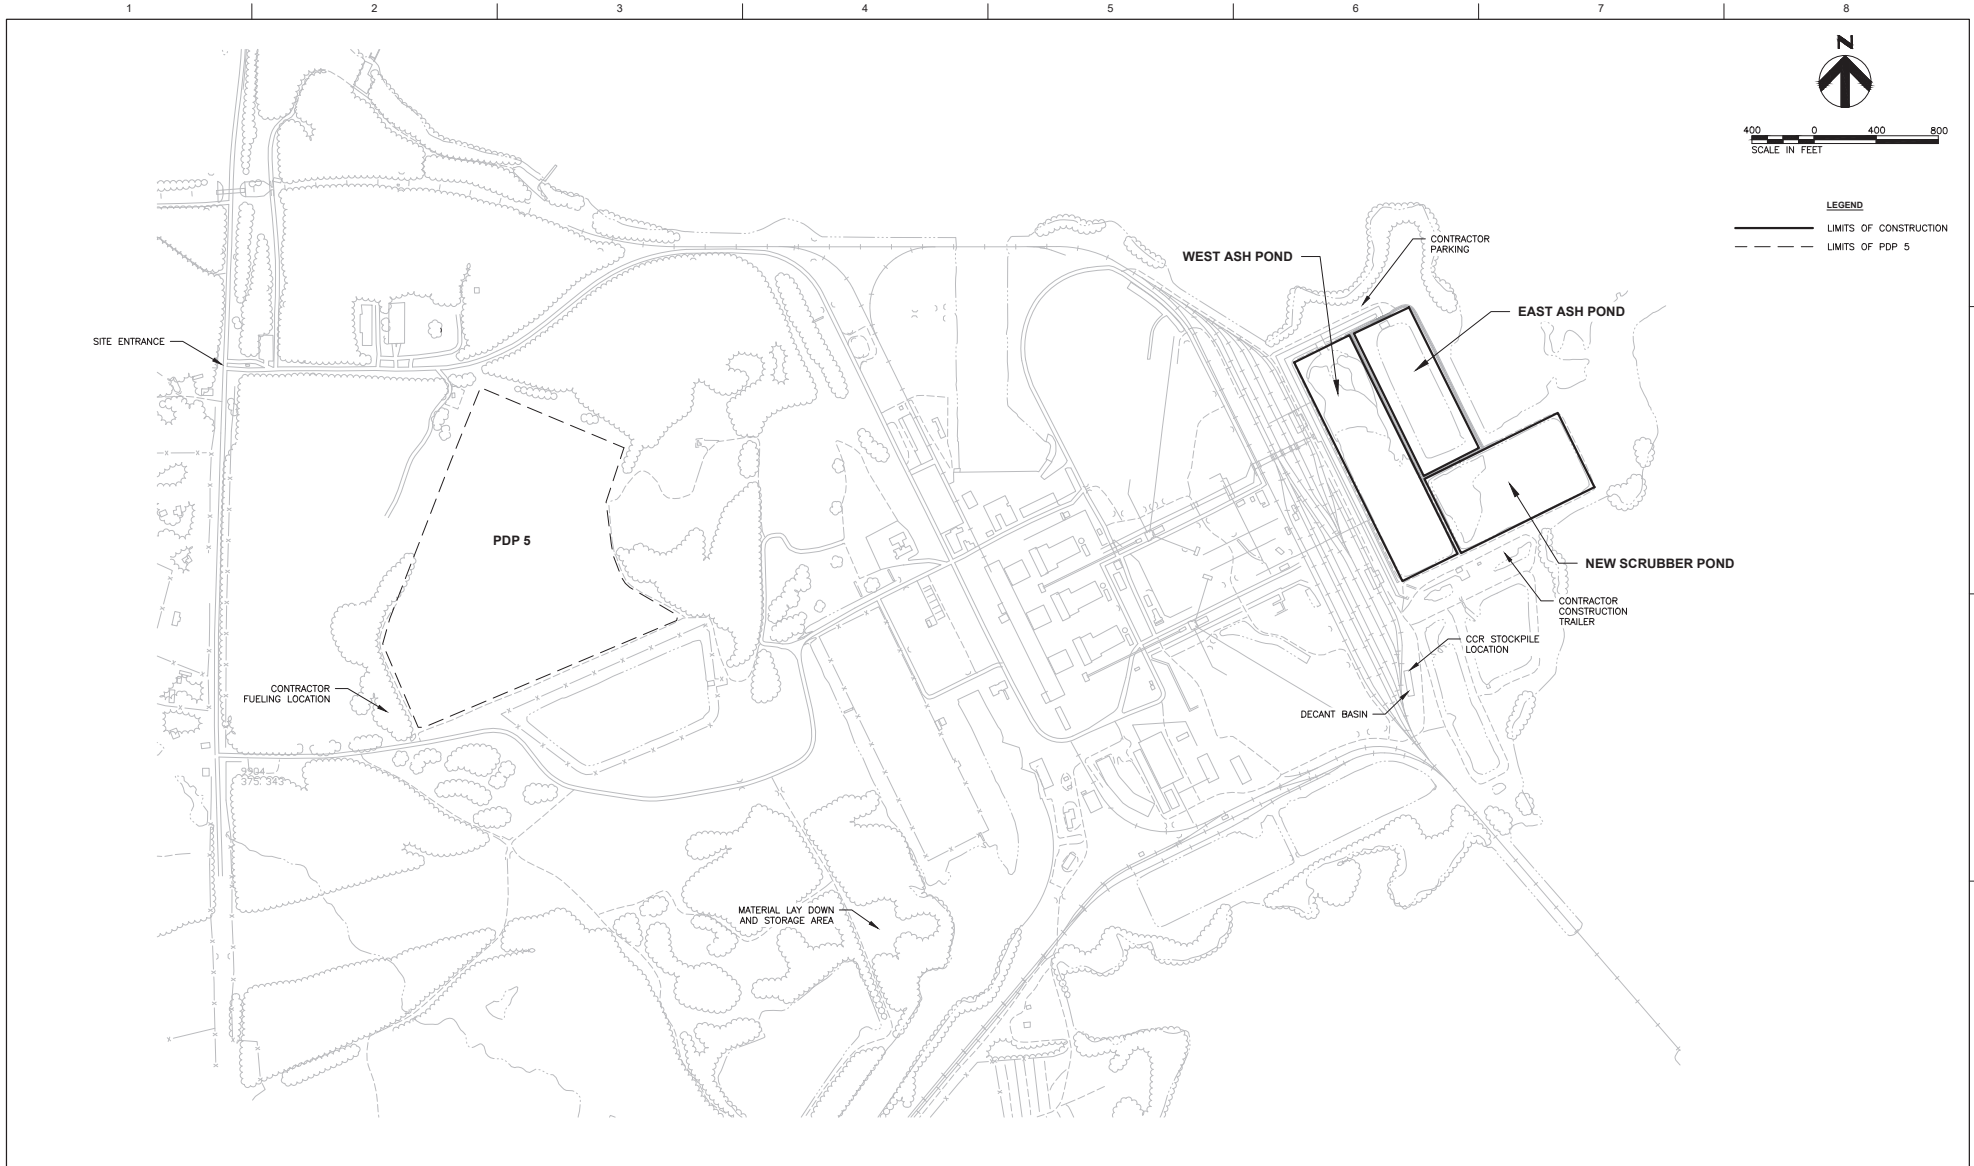

ISSUE	DATE	DESCRIPTION
A	01/31/2020	ISSUED FOR BID

PROJECT MANAGER	D. VOGT, P.E.
DESIGNED BY	K. PERERA
DRAWN BY	J. RAYMOND
CHECKED BY	M. ROBERTS
PROJECT NUMBER	10172630



MARTIN LAKE STEAM ELECTRICAL STATION
 NEW SCRUBBER POND RELINE
 RUSK COUNTY, TEXAS





SITE LAYOUT



FILENAME | 00C-01.dwg
 SCALE | 1" = 400'

SHEET
00C-01

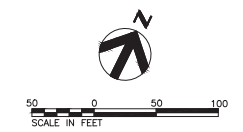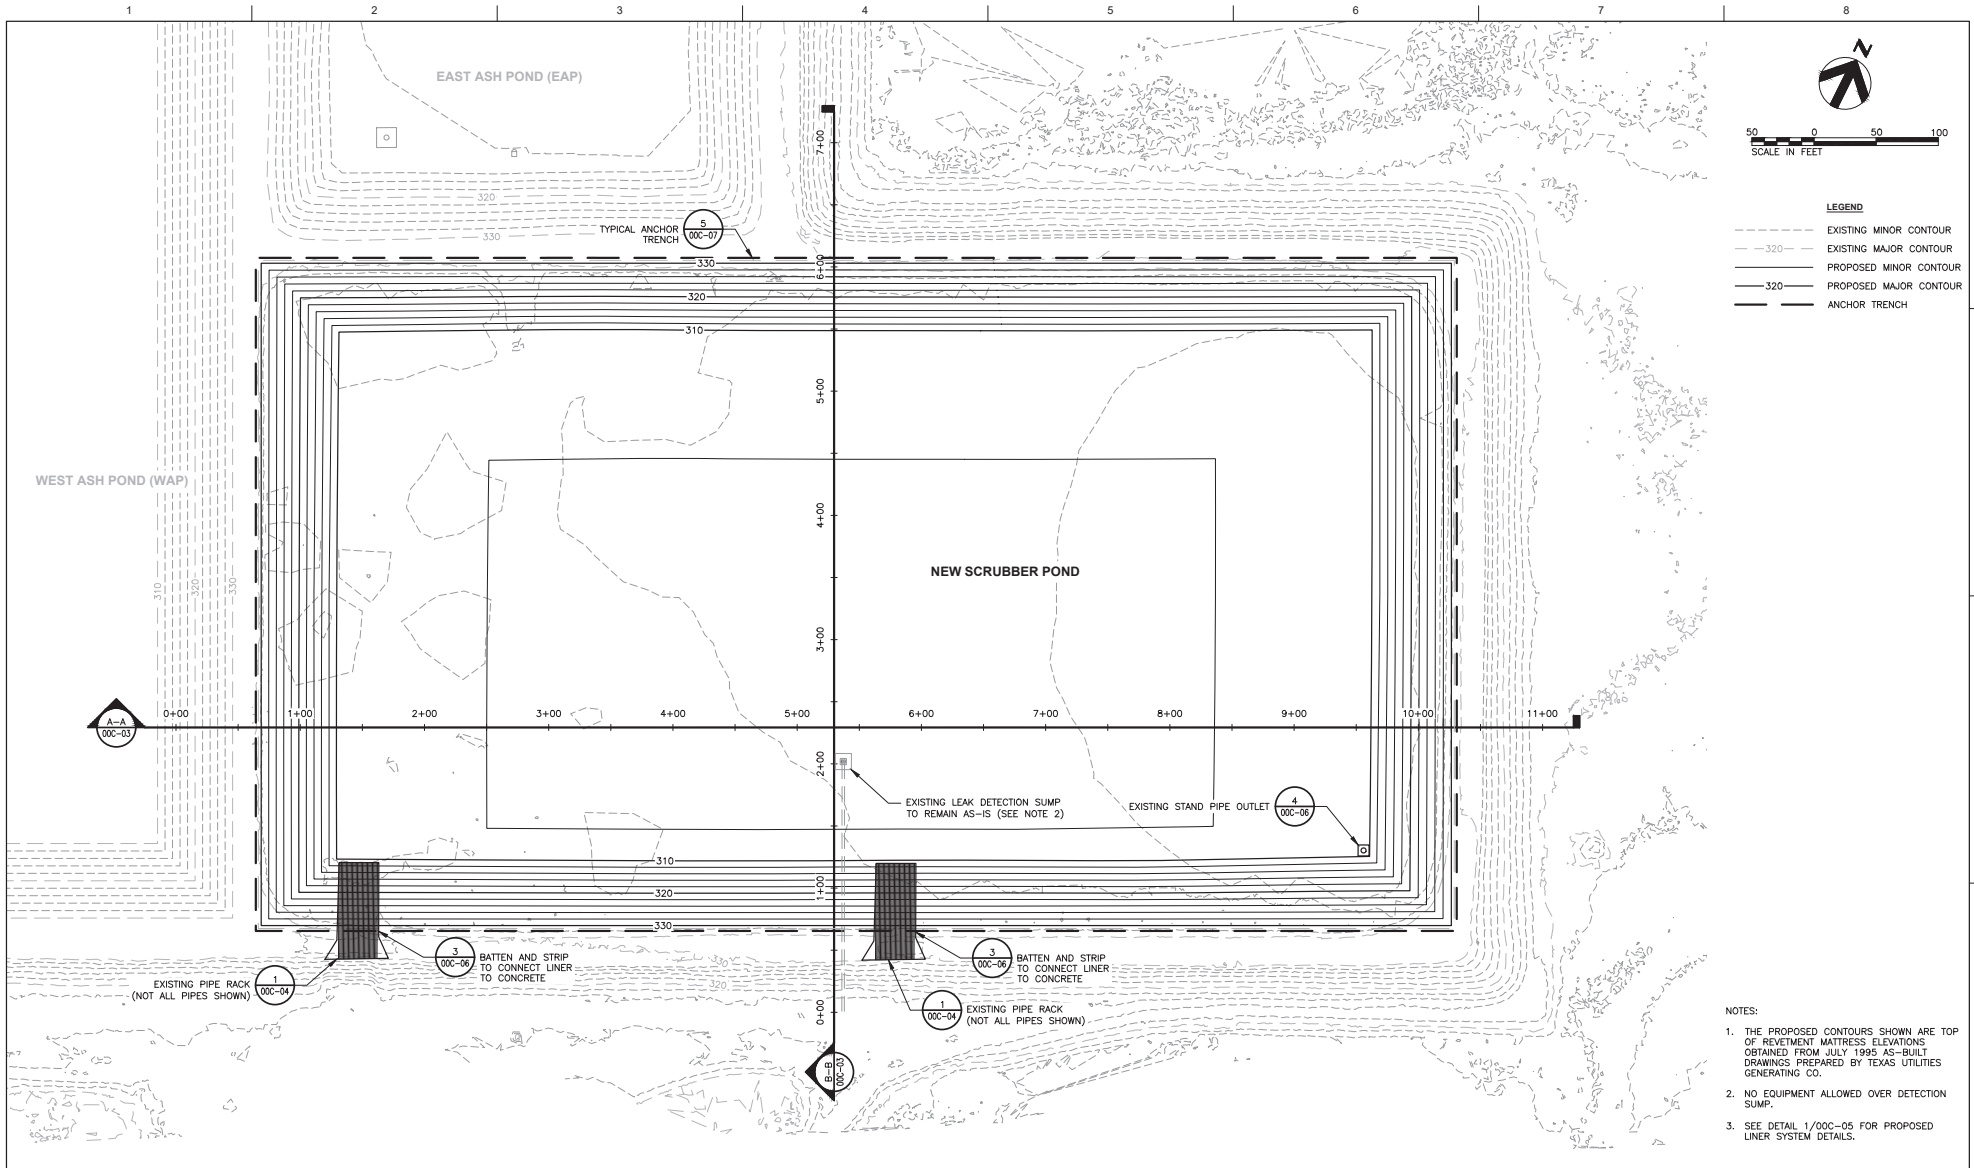


- LEGEND**
- - - - - EXISTING MINOR CONTOUR
 - - - - - EXISTING MAJOR CONTOUR
 - - - - - PROPOSED MINOR CONTOUR
 - - - - - PROPOSED MAJOR CONTOUR
 - - - - - ANCHOR TRENCH

- NOTES:**
1. THE PROPOSED CONTOURS SHOWN ARE TOP OF RETEINMENT MATRESS ELEVATIONS OBTAINED FROM JULY 1995 AS-BUILT DRAWINGS PREPARED BY TEXAS UTILITIES GENERATING CO.
 2. NO EQUIPMENT ALLOWED OVER DETECTION SUMP.
 3. SEE DETAIL 1/00C-05 FOR PROPOSED LINER SYSTEM DETAILS.



ISSUE	DATE	DESCRIPTION
A	01/31/2020	ISSUED FOR BID

PROJECT MANAGER	D. VOGT, P.E.
DESIGNED BY	K. PERERA
DRAWN BY	J. RAYMOND
CHECKED BY	M. ROBERTS
PROJECT NUMBER	10172630


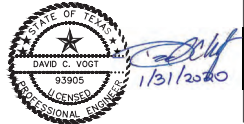


MARTIN LAKE STEAM ELECTRICAL STATION
 NEW SCRUBBER POND RELINE
 RUSK COUNTY, TEXAS





FILENAME 00C-02.dwg
 SCALE 1" = 50'

SHEET
00C-02

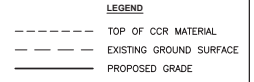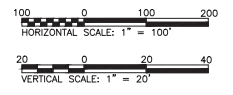


- NOTES:
- CCR ELEVATION FROM BATHYMETRIC SURVEY TAKEN FEBRUARY 2019 BY LACEY SURVEYING OF ARP, TEXAS. AT START OF PROJECT, OWNER WILL HAVE REMOVED BULK OF CCR MATERIAL FROM THE NEW SCRUBBER POND
 - CONTRACTOR WILL REMOVE REMAINING CCR MATERIAL, ROCKS AND SEDIMENT WITHIN POND BEFORE INSTALLATION OF THE LINER SYSTEM.

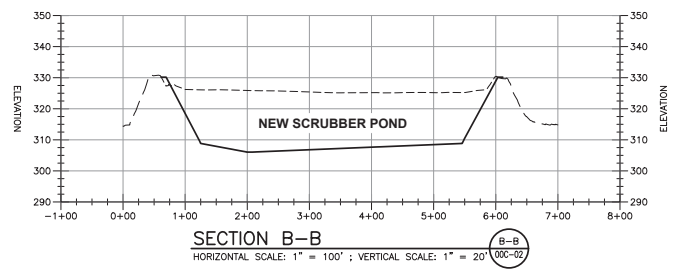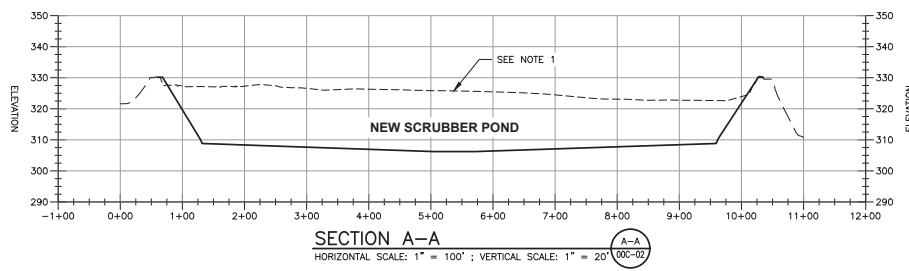

ISSUE	DATE	DESCRIPTION
A	01/31/2020	ISSUED FOR BID

PROJECT MANAGER	D. VOGT, P.E.
DESIGNED BY	K. PERERA
DRAWN BY	J. RAYMOND
CHECKED BY	M. ROBERTS
PROJECT NUMBER	10172630

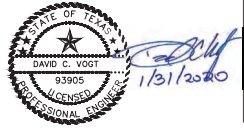

MARTIN LAKE STEAM ELECTRICAL STATION
 NEW SCRUBBER POND RELINE
 RUSK COUNTY, TEXAS




CROSS SECTIONS




FILENAME | 00C-03.dwg
 SCALE | H: 1" = 100' ; V: 1" = 20'

SHEET
00C-03


1 2 3 4 5 6 7 8

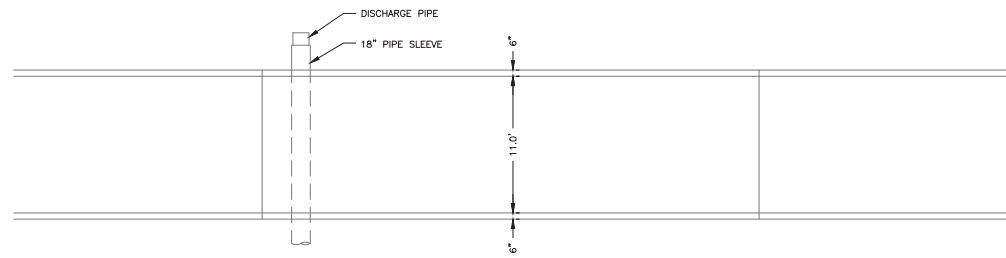


**PIPE RACK
PLAN VIEW**
NOT TO SCALE

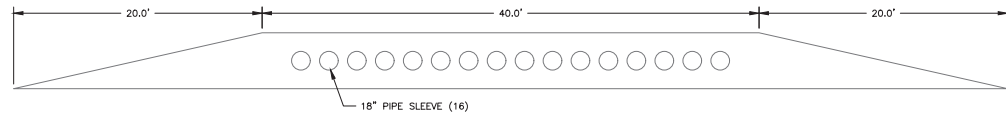


**PIPE RACK
PROFILE**
NOT TO SCALE

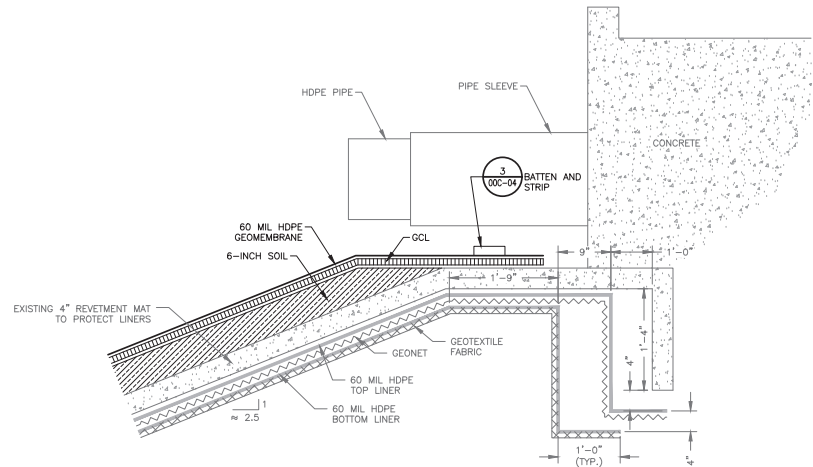


PIPE RACK SECTION
NOT TO SCALE

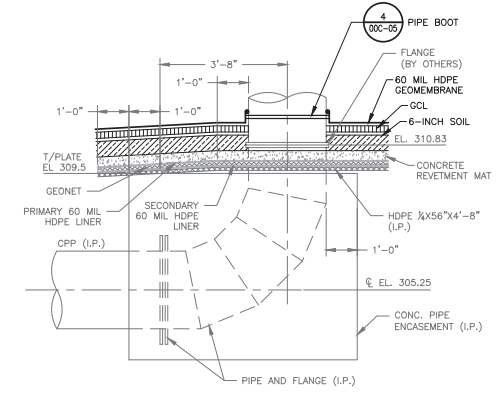

PIPE ENCASEMENT
NOT TO SCALE

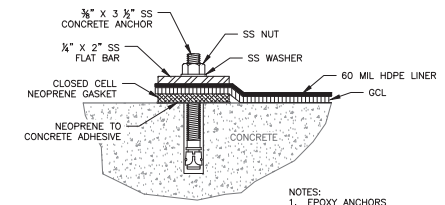

**BATTEN AND STRIP CONNECTION
AT ANCHOR TRENCH**
NOT TO SCALE

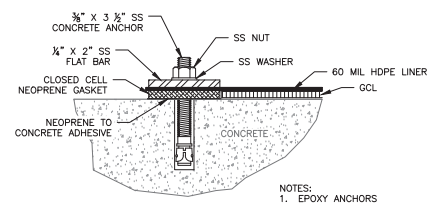

**BATTEN AND STRIP CONNECTION
BELOW WATER SURFACE**
NOT TO SCALE



ISSUE	DATE	DESCRIPTION
A	01/31/2020	ISSUED FOR BID

PROJECT MANAGER	D. VOGT, P.E.
DESIGNED BY	K. PERERA
DRAWN BY	J. RAYMOND
CHECKED BY	M. ROBERTS
PROJECT NUMBER	10172630




**MARTIN LAKE STEAM ELECTRICAL STATION
NEW SCRUBBER POND RELINE
RUSK COUNTY, TEXAS**




FILENAME: 00C-04.dwg
SCALE

SHEET
00C-04


**DETAILS
(1 OF 2)**

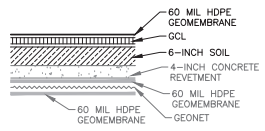


PROPOSED NEW SCRUBBER POND RETROFIT SECTION
 NOT TO SCALE 1
00C-05

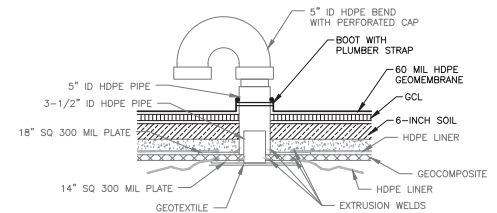

TYPICAL AIR-GAS VENT
 NOT TO SCALE 3
00C-05

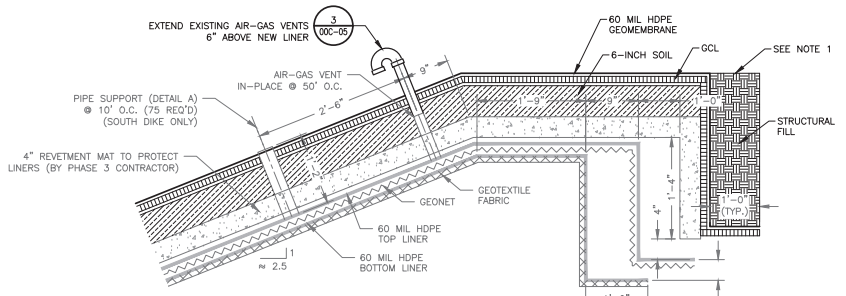

ANCHOR TRENCH
 NOT TO SCALE 2
00C-02

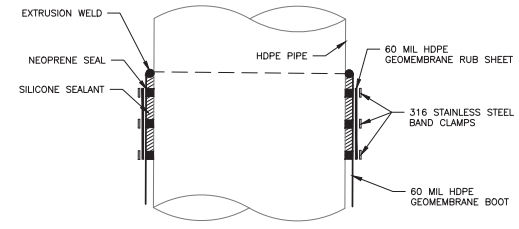

PIPE BOOT
 NOT TO SCALE 4
00C-04

NOTES:
 1. THE ANCHOR TRENCH SHALL BE INSTALLED OUTSIDE OF THE EXISTING ANCHOR TRENCH.



ISSUE	DATE	DESCRIPTION
A	01/31/2020	ISSUED FOR BID

PROJECT MANAGER	D. VOGT, P.E.
DESIGNED BY	K. PERERA
DRAWN BY	J. RAYMOND
CHECKED BY	M. ROBERTS
PROJECT NUMBER	10172630



**MARTIN LAKE STEAM ELECTRICAL STATION
 NEW SCRUBBER POND RELINE
 RUSK COUNTY, TEXAS**



**DETAILS
 (2 OF 2)**



FILENAME | 00C-05.dwg
 SCALE | NOT TO SCALE

SHEET
00C-05



N

600 0 600 1200
SCALE IN FEET

LEGEND

- LIMITS OF CONSTRUCTION
- - - LIMITS OF PDP 5
- HAUL ROUTE



ISSUE	DATE	DESCRIPTION
A	01/31/2020	ISSUED FOR BID

PROJECT MANAGER	D. VOGT, P.E.
DESIGNED BY	K. PERERA
DRAWN BY	J. RAYMOND
CHECKED BY	M. ROBERTS
PROJECT NUMBER	10172630



MARTIN LAKE STEAM ELECTRICAL STATION
NEW SCRUBBER POND RELINE
RUSK COUNTY, TEXAS



STOCKPILE AND HAUL ROUTE

FILENAME | 00C-06.dwg
SCALE | 1" = 600'

SHEET
00C-06

APPENDIX B

**EAP and WAP Pond Liner Retrofits
As-Built Drawings**



HDR
 Firm Registration No. F-754
 17111 Preston Road, Suite 300
 Dallas, Texas 75248-1229
 972.960.4400



VICINITY MAP
 NOT TO SCALE

As-built Drawings For

Martin Lake Steam Electric Station

CCR Impoundment Reline East Ash Pond As-Constructed Liner Drawings

Project No.
 10172630

Rusk County, Texas
 March 2021

THIS RECORD DRAWING IS A COMPILATION OF THE SEALED ENGINEERING DRAWINGS FOR THIS PROJECT, MODIFIED BY ADDENDA AND CHANGE ORDERS, INFORMATION BY THE CONTRACTOR OR OTHER, NOT ASSOCIATED WITH THE DESIGN ENGINEER, CANNOT BE VERIFIED FOR ACCURACY OR COMPLETENESS. THE ORIGINAL SEALED DRAWINGS ARE ON FILE AT THE OFFICES OF LUMINANT.


INDEX OF DRAWINGS

GENERAL	
00G-01	COVER SHEET
CIVIL	
00C-01	SITE LAYOUT
00C-02	EAST ASH POND
00C-03	CROSS SECTIONS
00C-04	DETAILS (1 OF 2)
00C-05	DETAILS (2 OF 2)
00C-06	GCL PANEL LAYOUT
00C-07	HDPE PANEL LAYOUT






LEGEND
 ——— LIMITS OF CONSTRUCTION
 - - - - - LIMITS OF PDP 5

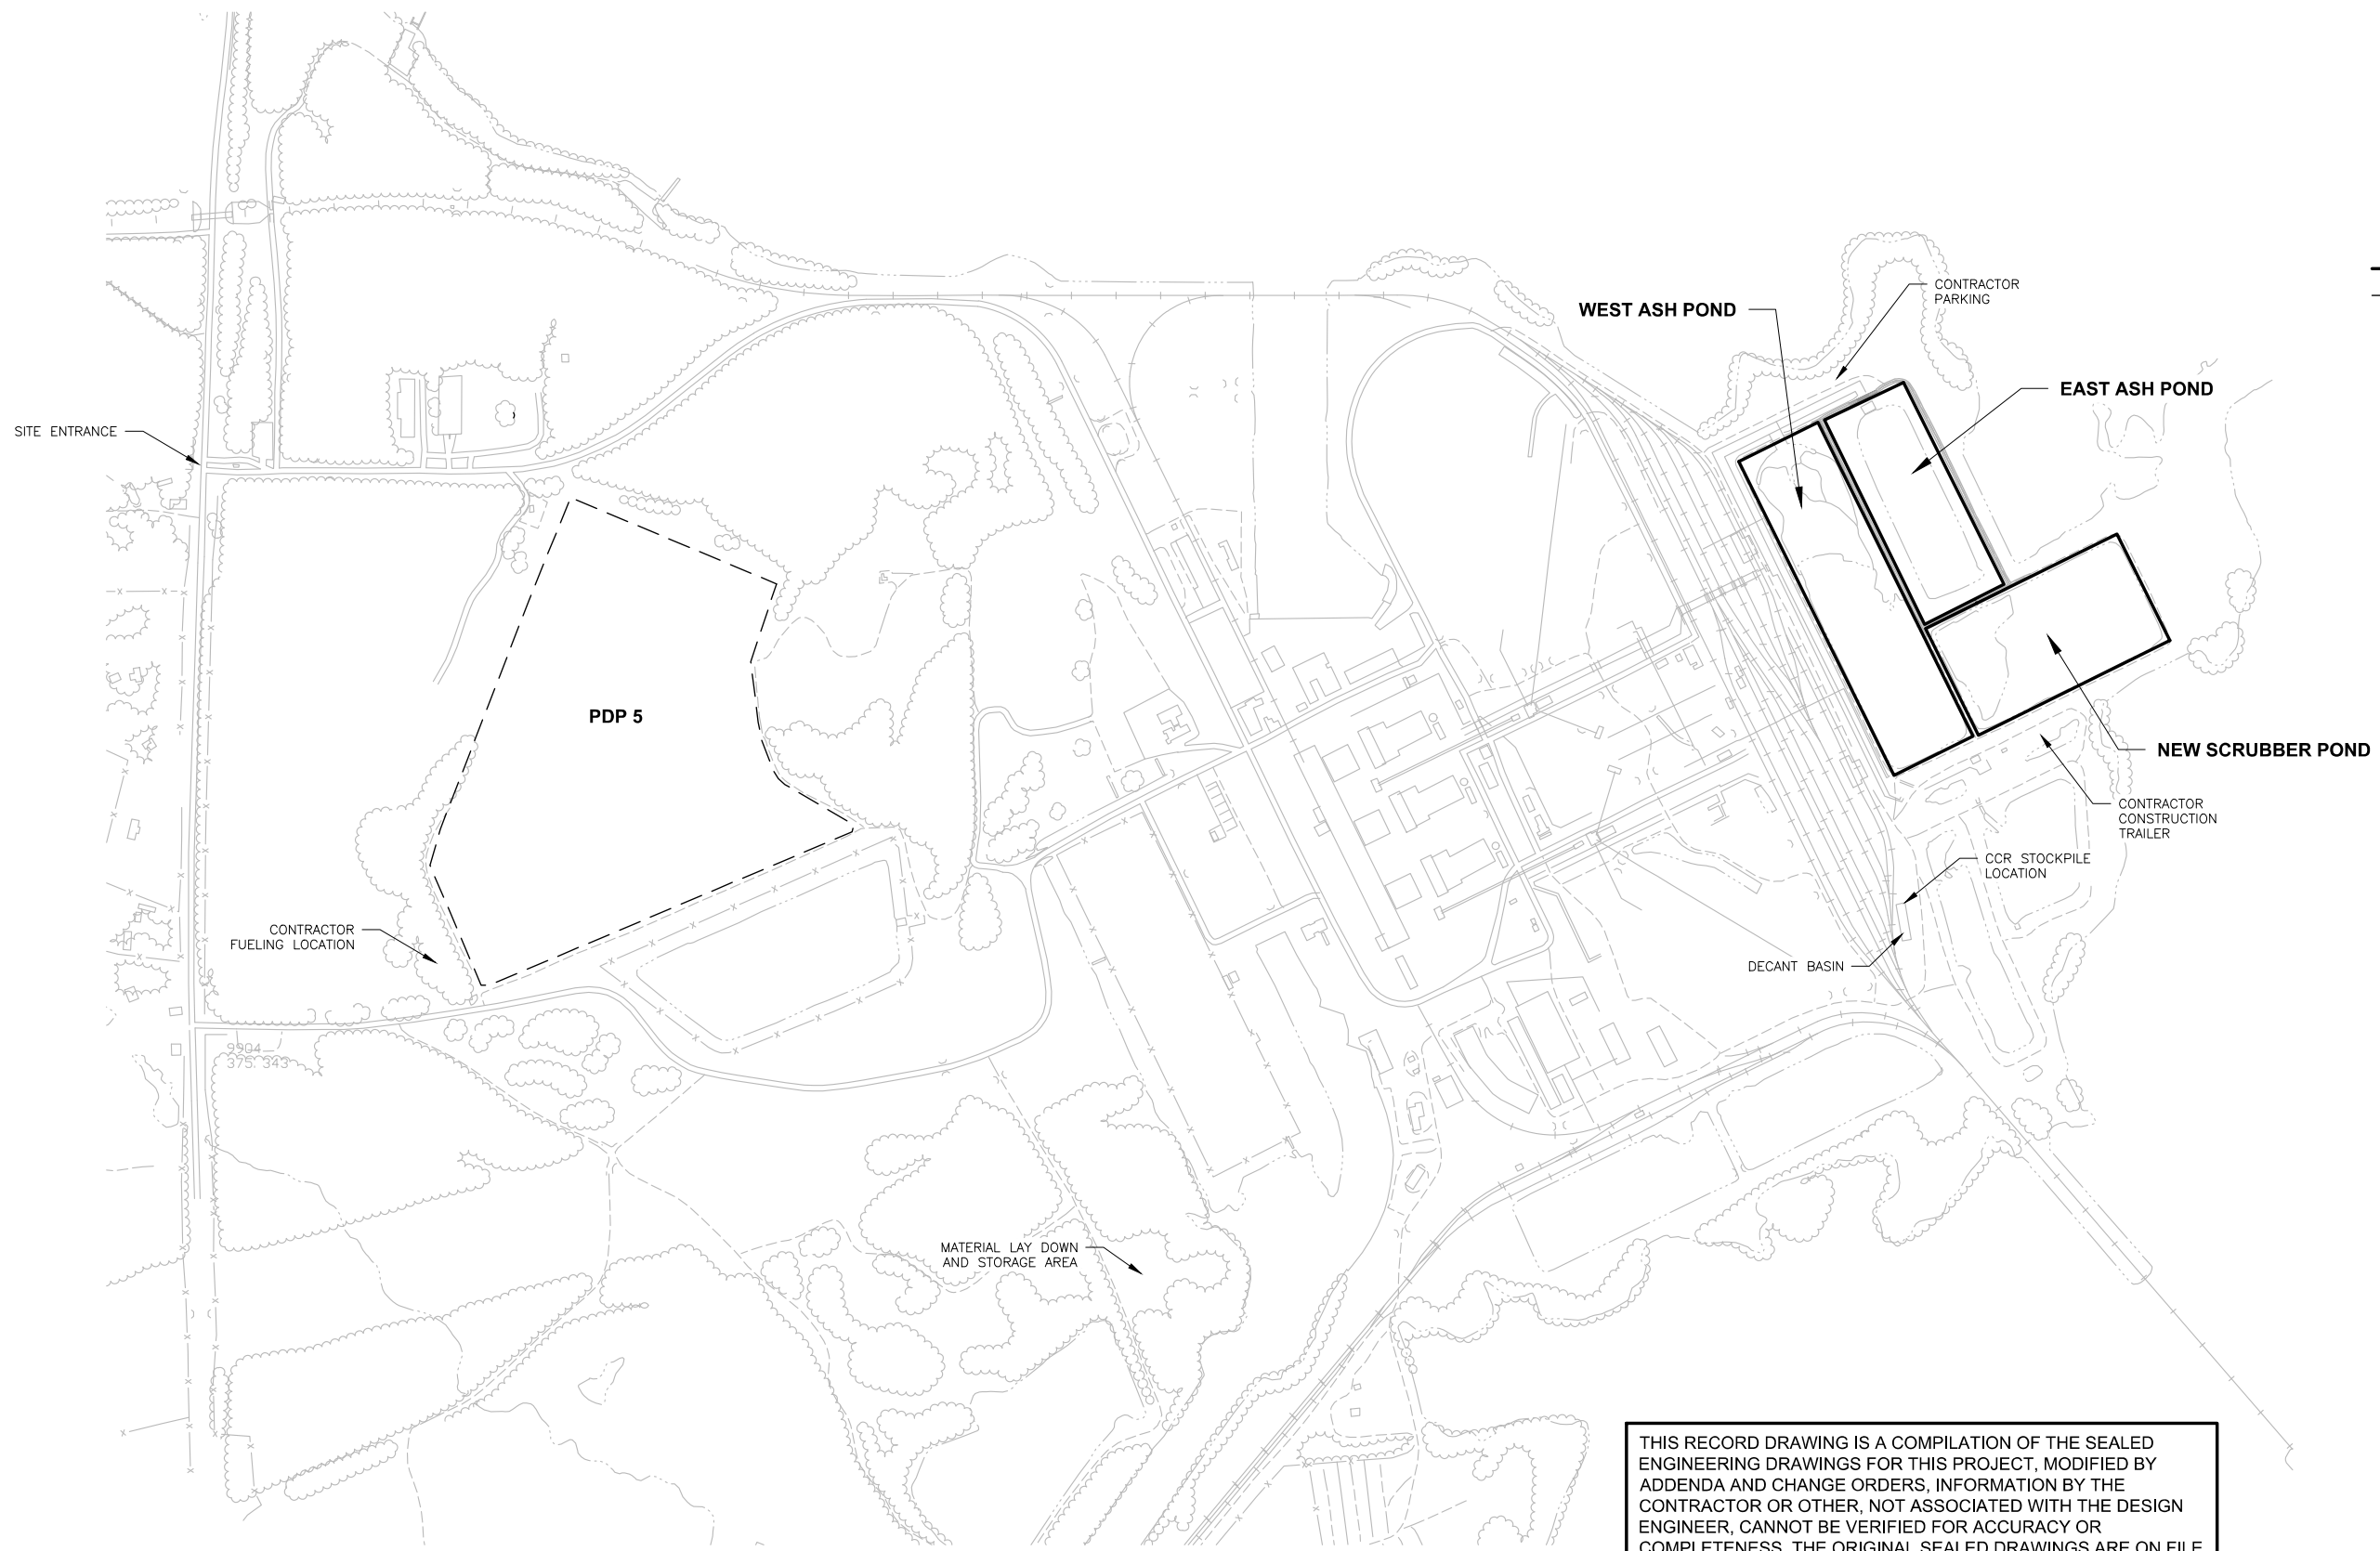


THIS RECORD DRAWING IS A COMPILATION OF THE SEALED ENGINEERING DRAWINGS FOR THIS PROJECT, MODIFIED BY ADDENDA AND CHANGE ORDERS. INFORMATION BY THE CONTRACTOR OR OTHER, NOT ASSOCIATED WITH THE DESIGN ENGINEER, CANNOT BE VERIFIED FOR ACCURACY OR COMPLETENESS. THE ORIGINAL SEALED DRAWINGS ARE ON FILE AT THE OFFICES OF LUMINANT.

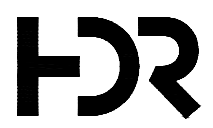

ISSUE	DATE	DESCRIPTION
B	03/26/21	AS-CONSTRUCTED LINER DRAWINGS
A	10/16/20	AS-BUILTS

PROJECT MANAGER	D. VOGT, P.E.
DESIGNED BY	K. PERERA
DRAWN BY	J. RAYMOND
CHECKED BY	M. ROBERTS
PROJECT NUMBER	10172630

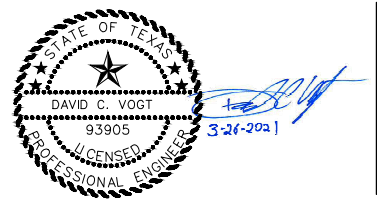


**MARTIN LAKE STEAM ELECTRICAL STATION
 EAST ASH POND RELINE
 RUSK COUNTY, TEXAS**




SITE LAYOUT



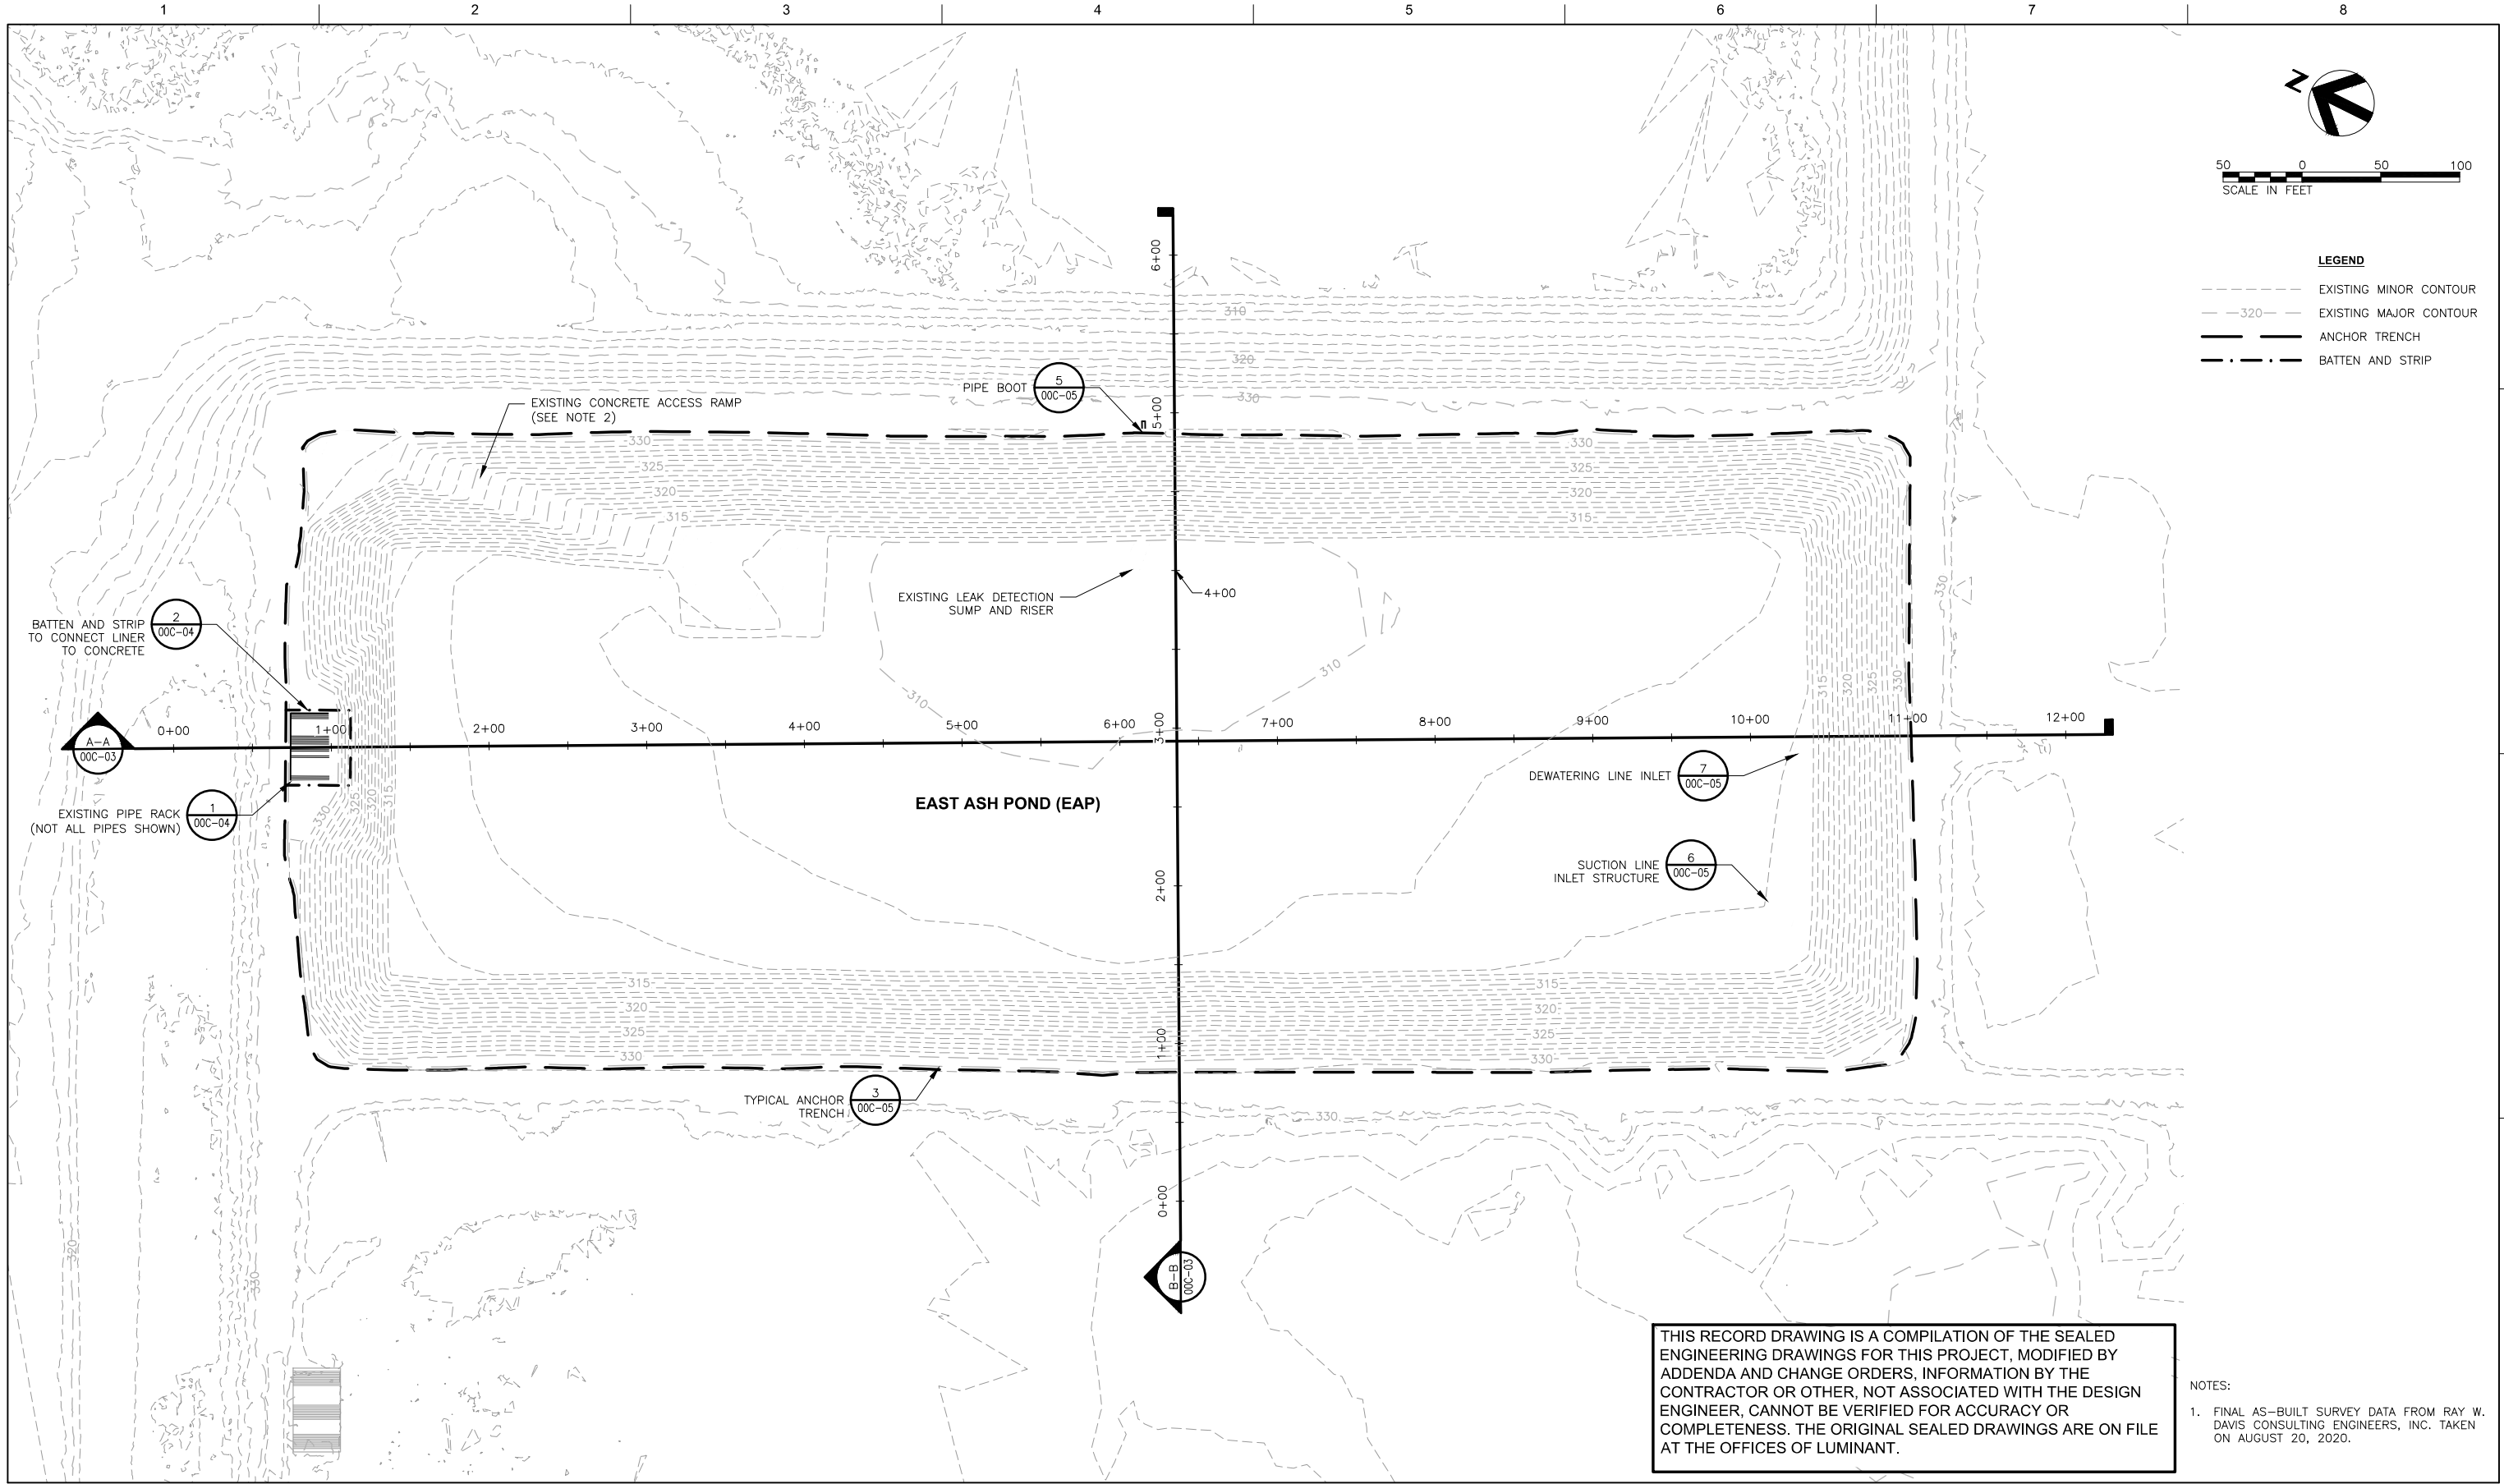


THIS RECORD DRAWING IS A COMPILATION OF THE SEALED ENGINEERING DRAWINGS FOR THIS PROJECT, MODIFIED BY ADDENDA AND CHANGE ORDERS, INFORMATION BY THE CONTRACTOR OR OTHER, NOT ASSOCIATED WITH THE DESIGN ENGINEER, CANNOT BE VERIFIED FOR ACCURACY OR COMPLETENESS. THE ORIGINAL SEALED DRAWINGS ARE ON FILE AT THE OFFICES OF LUMINANT.

- NOTES:
1. FINAL AS-BUILT SURVEY DATA FROM RAY W. DAVIS CONSULTING ENGINEERS, INC. TAKEN ON AUGUST 20, 2020.

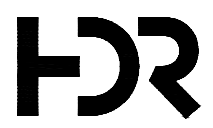






ISSUE	DATE	DESCRIPTION
B	03/26/21	AS-CONSTRUCTED LINER DRAWINGS
A	10/16/20	AS-BUILTS

PROJECT MANAGER	D. VOGT, P.E.
DESIGNED BY	K. PERERA
DRAWN BY	J. RAYMOND
CHECKED BY	M. ROBERTS
PROJECT NUMBER	10172630

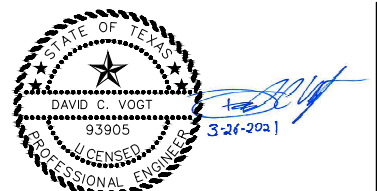


**MARTIN LAKE STEAM ELECTRICAL STATION
EAST ASH POND RELINE
RUSK COUNTY, TEXAS**

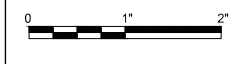

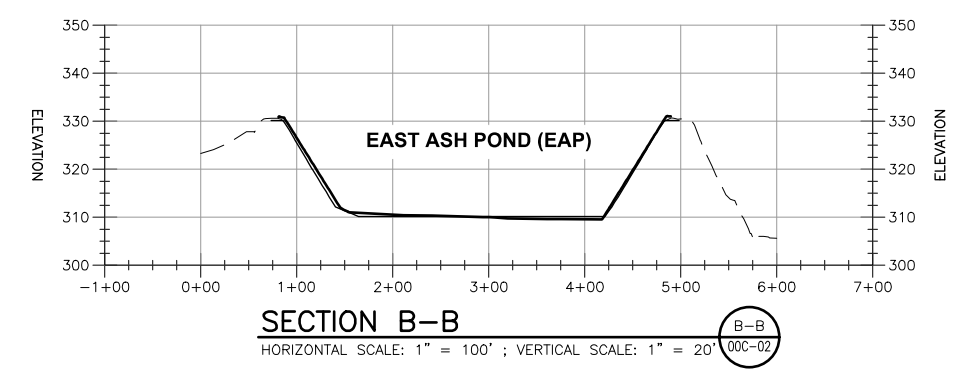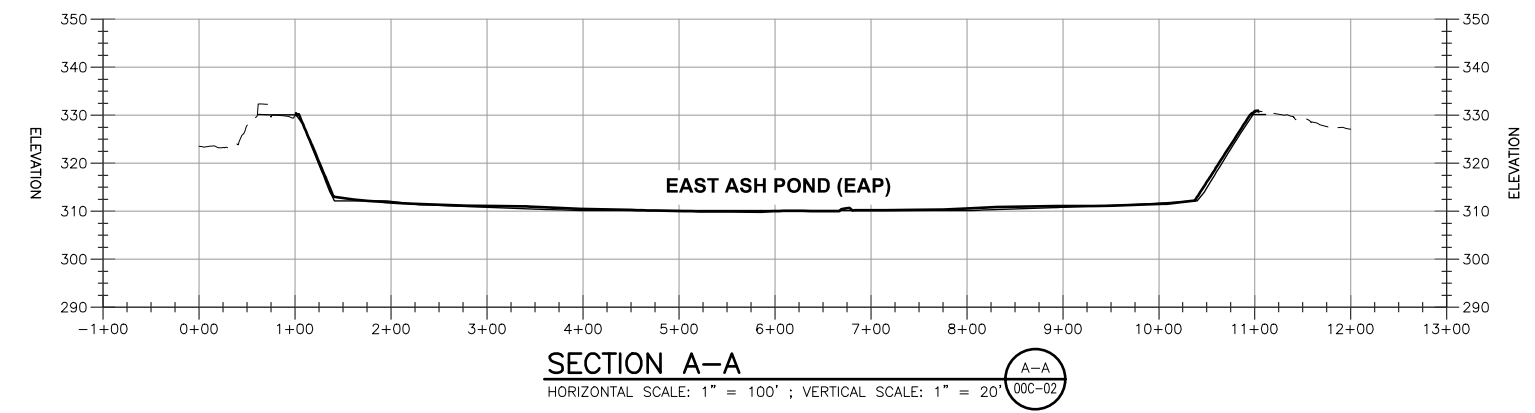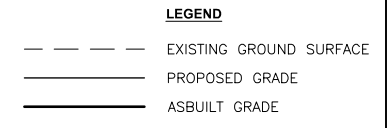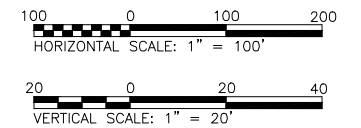


THIS RECORD DRAWING IS A COMPILATION OF THE SEALED ENGINEERING DRAWINGS FOR THIS PROJECT, MODIFIED BY ADDENDA AND CHANGE ORDERS, INFORMATION BY THE CONTRACTOR OR OTHER, NOT ASSOCIATED WITH THE DESIGN ENGINEER, CANNOT BE VERIFIED FOR ACCURACY OR COMPLETENESS. THE ORIGINAL SEALED DRAWINGS ARE ON FILE AT THE OFFICES OF LUMINANT.

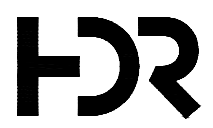

ISSUE	DATE	DESCRIPTION
B	03/26/21	AS-CONSTRUCTED LINER DRAWINGS
A	10/16/20	AS-BUILTS

PROJECT MANAGER	D. VOGT, P.E.
DESIGNED BY	K. PERERA
DRAWN BY	J. RAYMOND
CHECKED BY	M. ROBERTS
PROJECT NUMBER	10172630

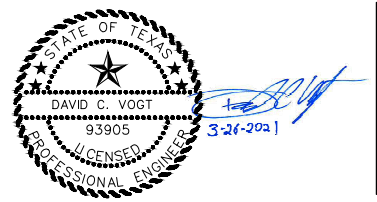


**MARTIN LAKE STEAM ELECTRICAL STATION
 EAST ASH POND RELINE
 RUSK COUNTY, TEXAS**




CROSS SECTIONS



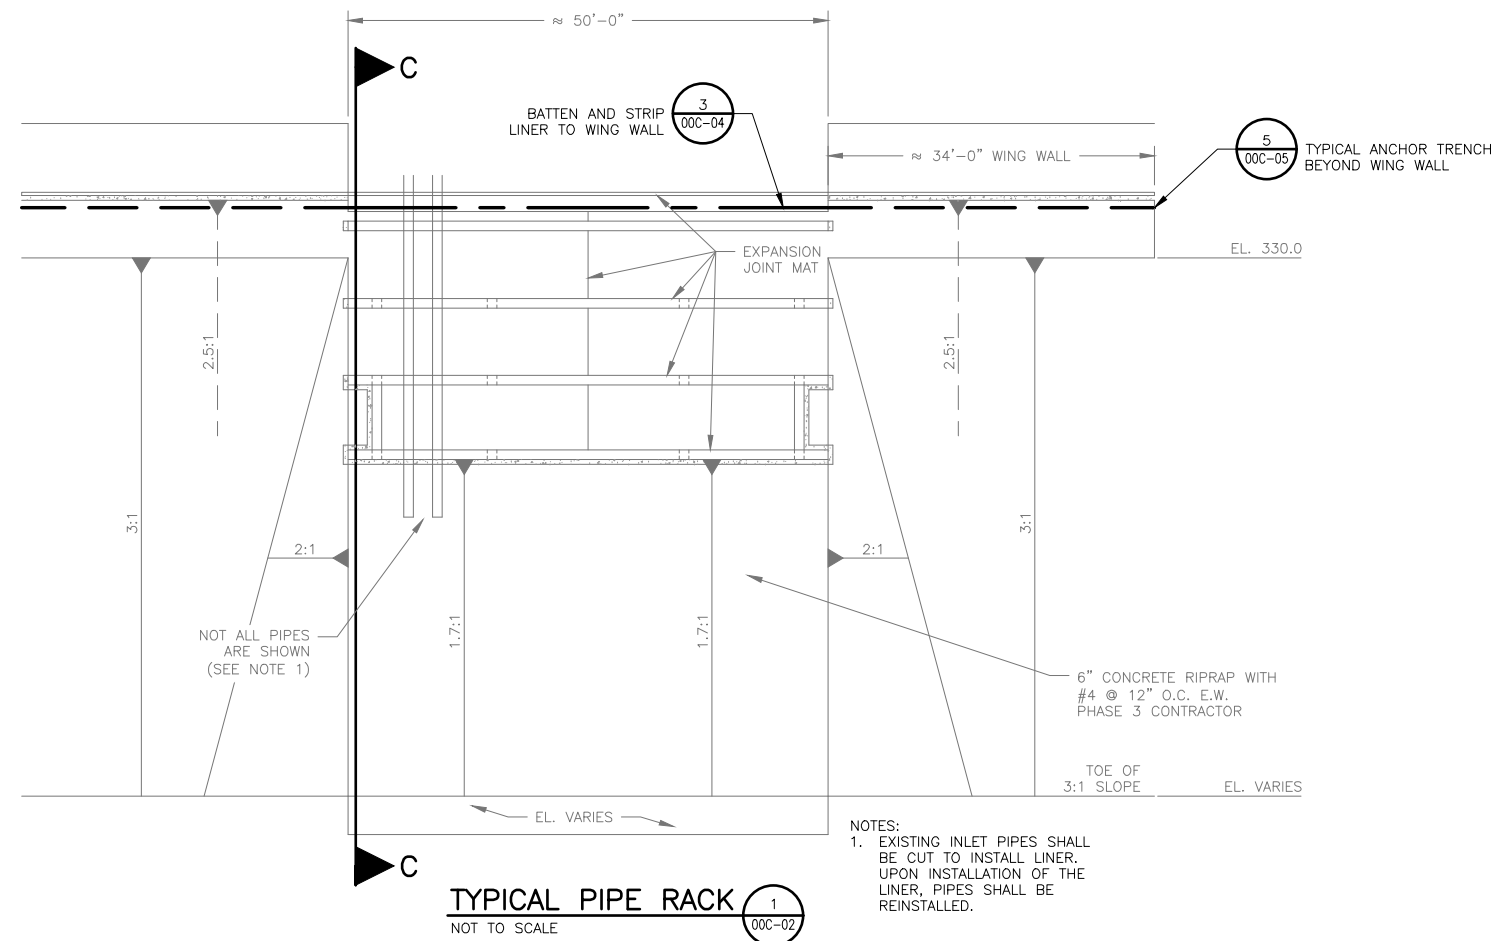


TYPICAL PIPE RACK
NOT TO SCALE

NOTES:
1. EXISTING INLET PIPES SHALL BE CUT TO INSTALL LINER. UPON INSTALLATION OF THE LINER, PIPES SHALL BE REINSTALLED.

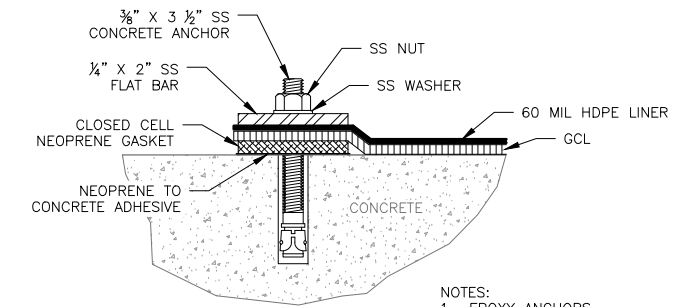


BATTEN AND STRIP CONNECTION AT ANCHOR TRENCH
NOT TO SCALE

NOTES:
1. EPOXY ANCHORS SPACED AT 6\"/>

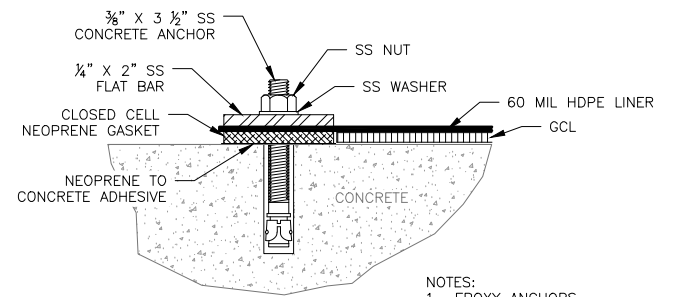

BATTEN AND STRIP CONNECTION BELOW WATER SURFACE
NOT TO SCALE

NOTES:
1. EPOXY ANCHORS SPACED AT 6\"/>

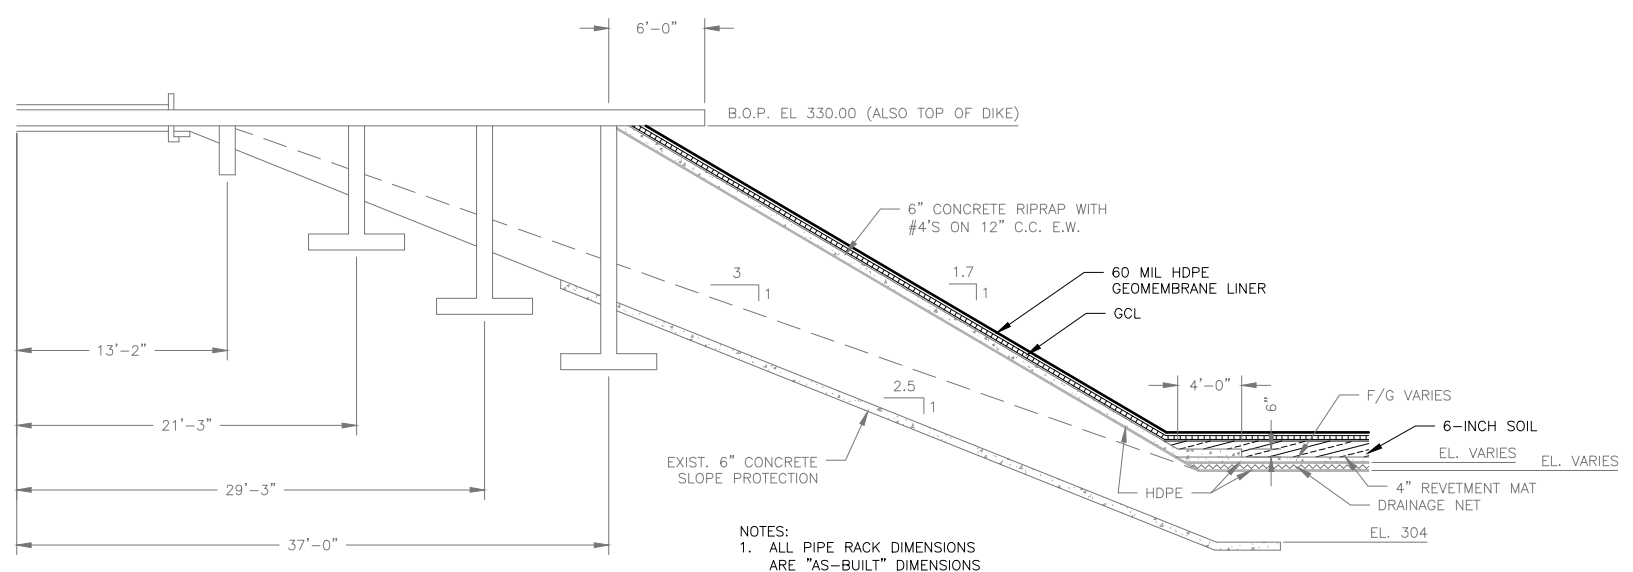

SECTION C-C
NOT TO SCALE


NOTES:
1. ALL PIPE RACK DIMENSIONS ARE \"AS-BUILT\" DIMENSIONS FOR EAST ASH POND.

THIS RECORD DRAWING IS A COMPILATION OF THE SEALED ENGINEERING DRAWINGS FOR THIS PROJECT, MODIFIED BY ADDENDA AND CHANGE ORDERS, INFORMATION BY THE CONTRACTOR OR OTHER, NOT ASSOCIATED WITH THE DESIGN ENGINEER, CANNOT BE VERIFIED FOR ACCURACY OR COMPLETENESS. THE ORIGINAL SEALED DRAWINGS ARE ON FILE AT THE OFFICES OF LUMINANT.



ISSUE	DATE	DESCRIPTION
B	03/26/21	AS-CONSTRUCTED LINER DRAWINGS
A	10/16/20	AS-BUILTS


PROJECT MANAGER	D. VOGT, P.E.
DESIGNED BY	K. PERERA
DRAWN BY	J. RAYMOND
CHECKED BY	M. ROBERTS
PROJECT NUMBER	10172630

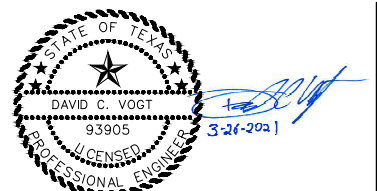


**MARTIN LAKE STEAM ELECTRICAL STATION
EAST ASH POND RELINE
RUSK COUNTY, TEXAS**




**DETAILS
(1 OF 2)**

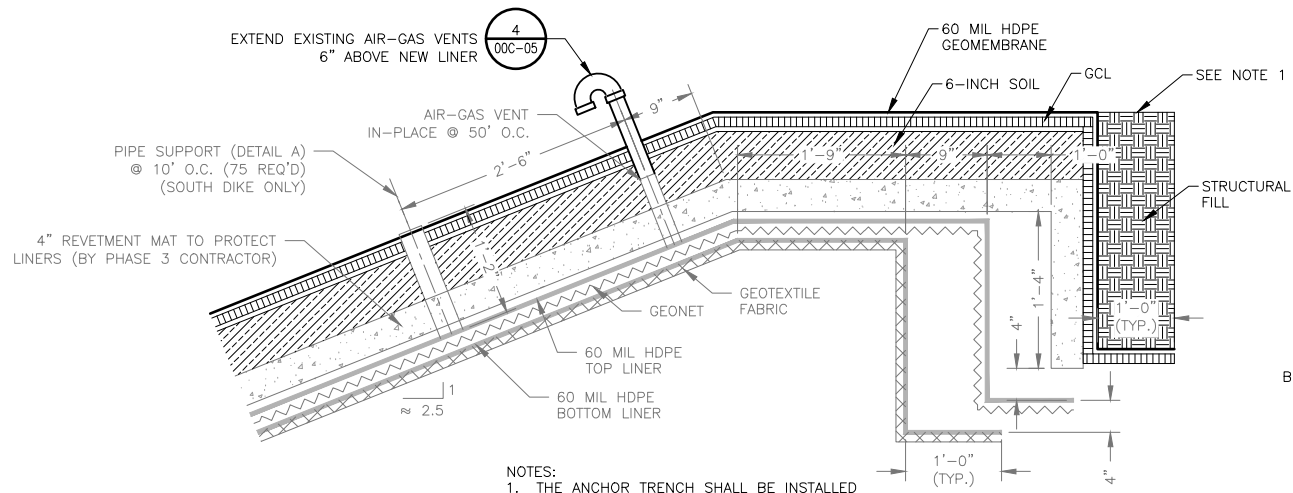


ANCHOR TRENCH
NOT TO SCALE

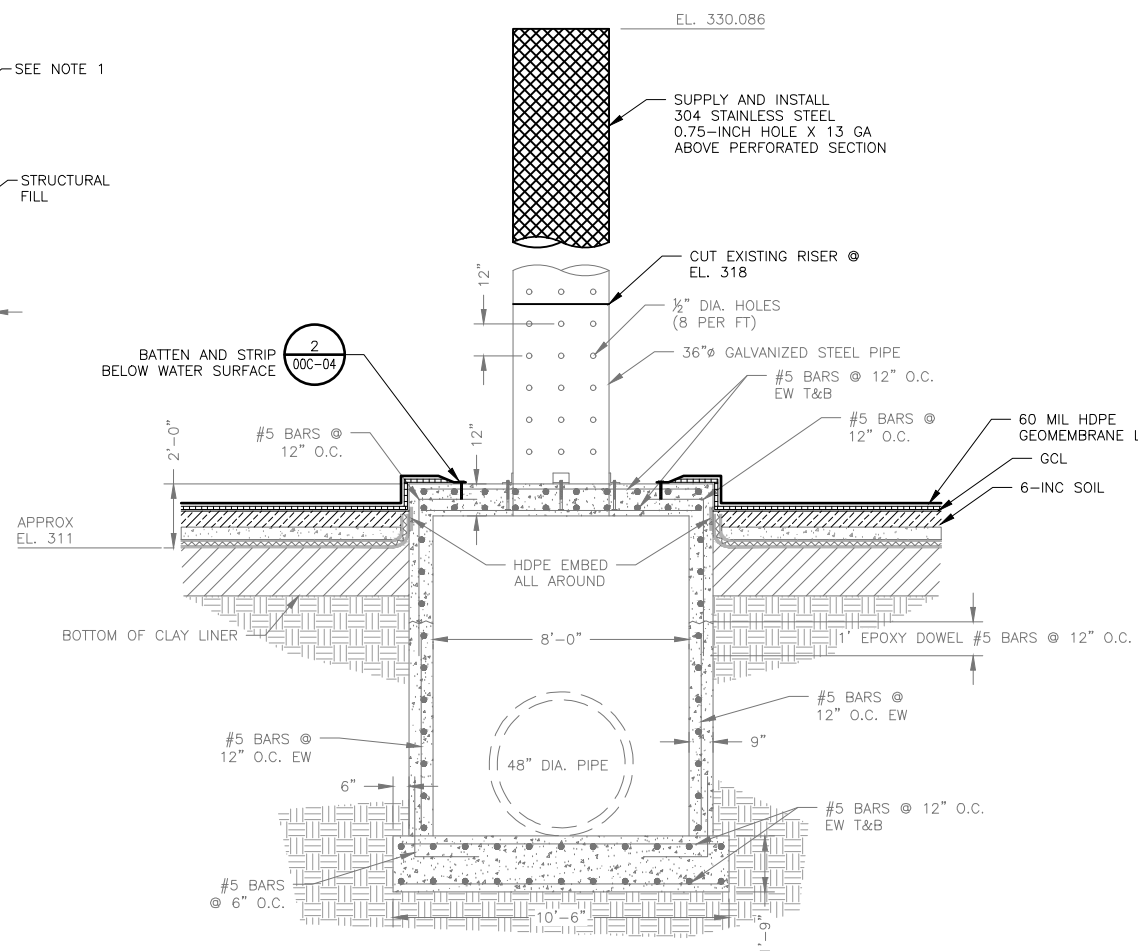


SUCTION LINE INLET STRUCTURE
NOT TO SCALE

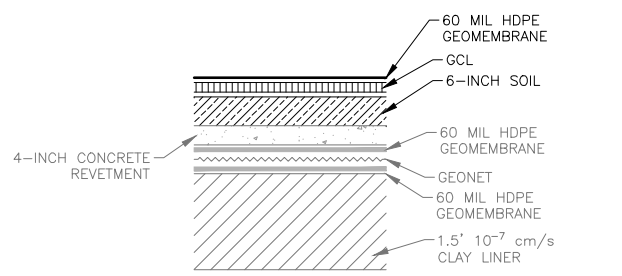


PROPOSED EAP RETROFIT SECTION (FLOOR)
NOT TO SCALE

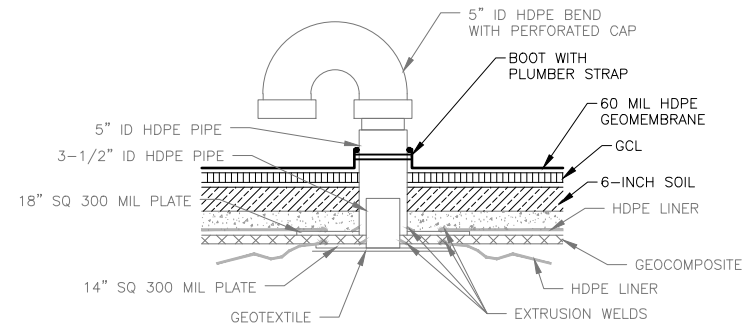


TYPICAL AIR-GAS VENT
NOT TO SCALE

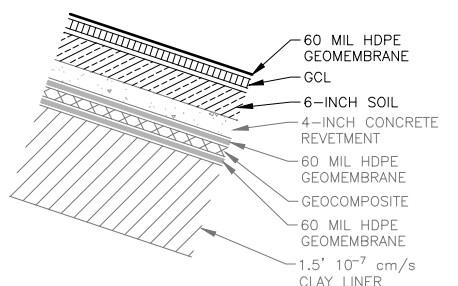

PROPOSED EAP RETROFIT SECTION (SIDESLOPE)
NOT TO SCALE

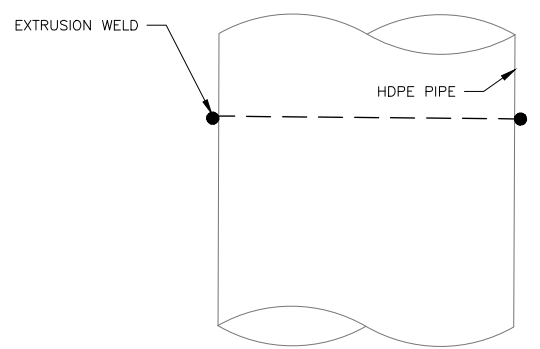


PIPE BOOT
NOT TO SCALE

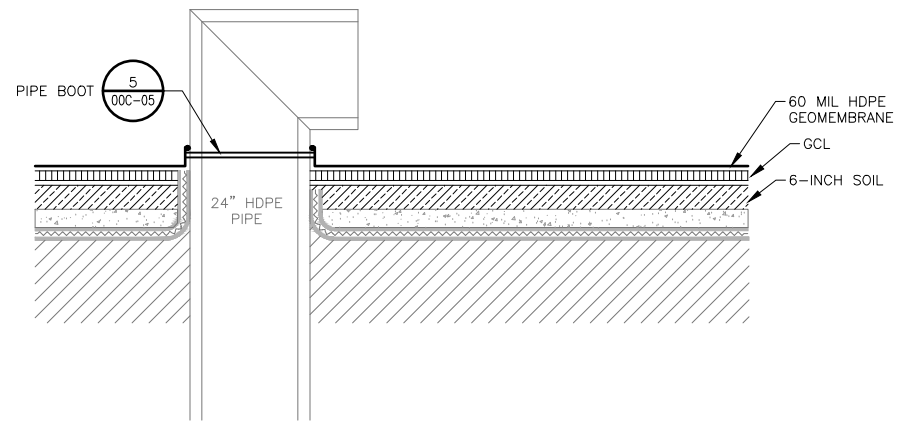


24\"/>

THIS RECORD DRAWING IS A COMPILATION OF THE SEALED ENGINEERING DRAWINGS FOR THIS PROJECT, MODIFIED BY ADDENDA AND CHANGE ORDERS. INFORMATION BY THE CONTRACTOR OR OTHER, NOT ASSOCIATED WITH THE DESIGN ENGINEER, CANNOT BE VERIFIED FOR ACCURACY OR COMPLETENESS. THE ORIGINAL SEALED DRAWINGS ARE ON FILE AT THE OFFICES OF LUMINANT.

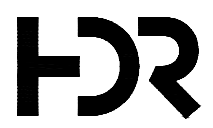

ISSUE	DATE	DESCRIPTION
B	03/26/21	AS-CONSTRUCTED LINER DRAWINGS
A	10/16/20	AS-BUILTS

PROJECT MANAGER	D. VOGT, P.E.
DESIGNED BY	K. PERERA
DRAWN BY	J. RAYMOND
CHECKED BY	M. ROBERTS
PROJECT NUMBER	10172630

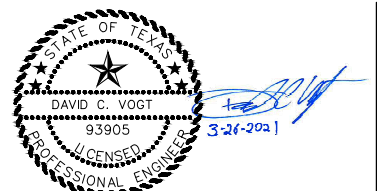


**MARTIN LAKE STEAM ELECTRICAL STATION
EAST ASH POND RELINE
RUSK COUNTY, TEXAS**




**DETAILS
(2 OF 2)**



40 0 40 80
SCALE IN FEET

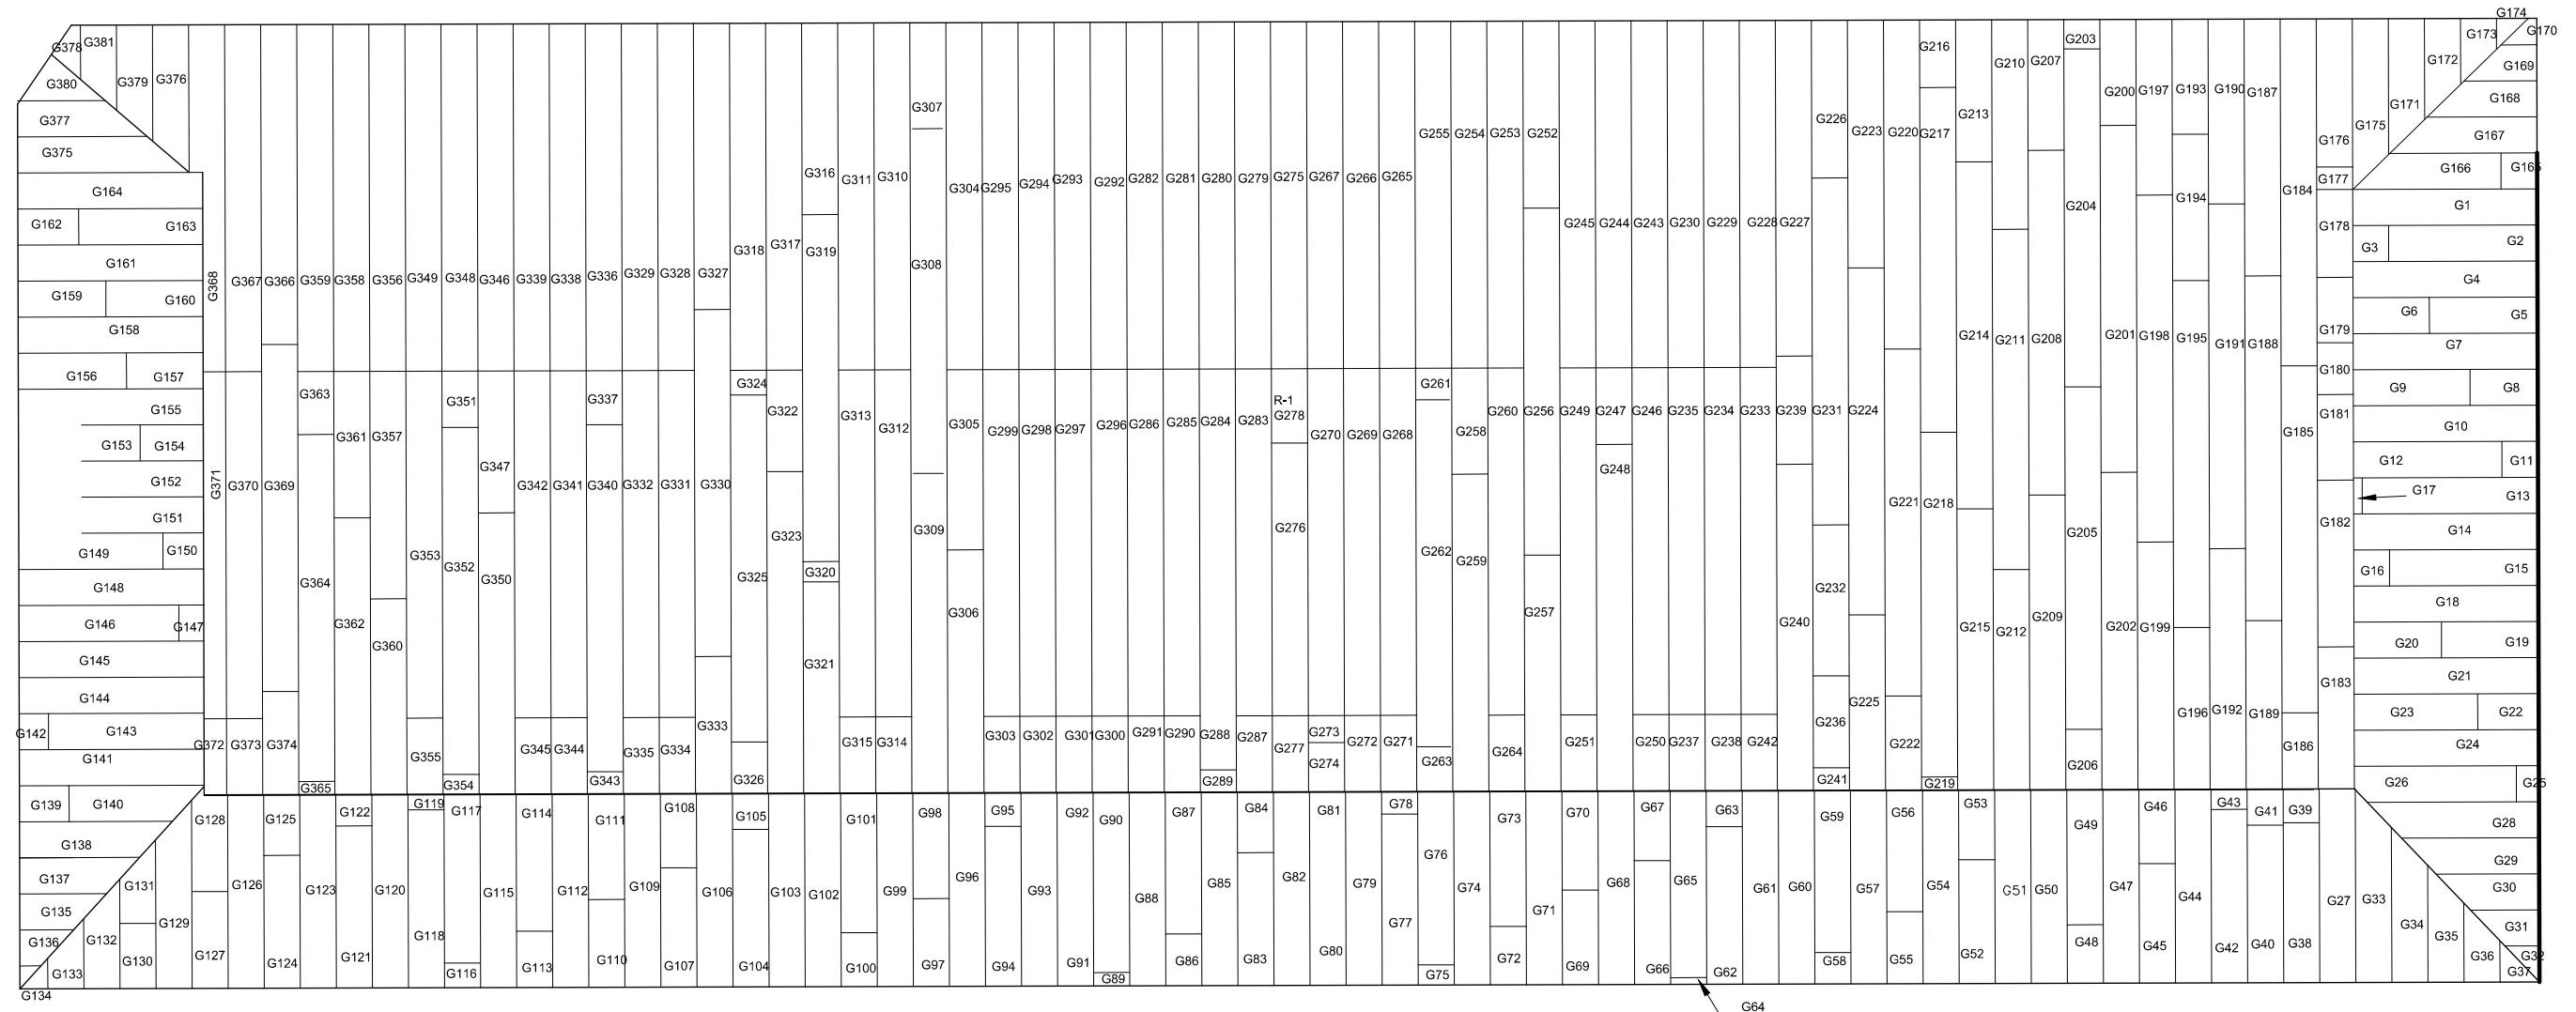


THIS RECORD DRAWING IS A COMPILATION OF THE SEALED ENGINEERING DRAWINGS FOR THIS PROJECT, MODIFIED BY ADDENDA AND CHANGE ORDERS. INFORMATION BY THE CONTRACTOR OR OTHER, NOT ASSOCIATED WITH THE DESIGN ENGINEER, CANNOT BE VERIFIED FOR ACCURACY OR COMPLETENESS. THE ORIGINAL SEALED DRAWINGS ARE ON FILE AT THE OFFICES OF LUMINANT.

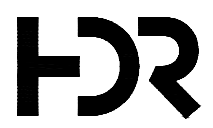

ISSUE	DATE	DESCRIPTION
B	03/26/21	AS-CONSTRUCTED LINER DRAWINGS
A	10/16/20	AS-BUILTS

PROJECT MANAGER	D. VOGT, P.E.
DESIGNED BY	K. PERERA
DRAWN BY	J. RAYMOND
CHECKED BY	M. ROBERTS
PROJECT NUMBER	10172630

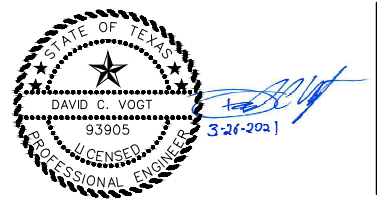


**MARTIN LAKE STEAM ELECTRICAL STATION
EAST ASH POND RELINE
RUSK COUNTY, TEXAS**




GCL PANEL LAYOUT



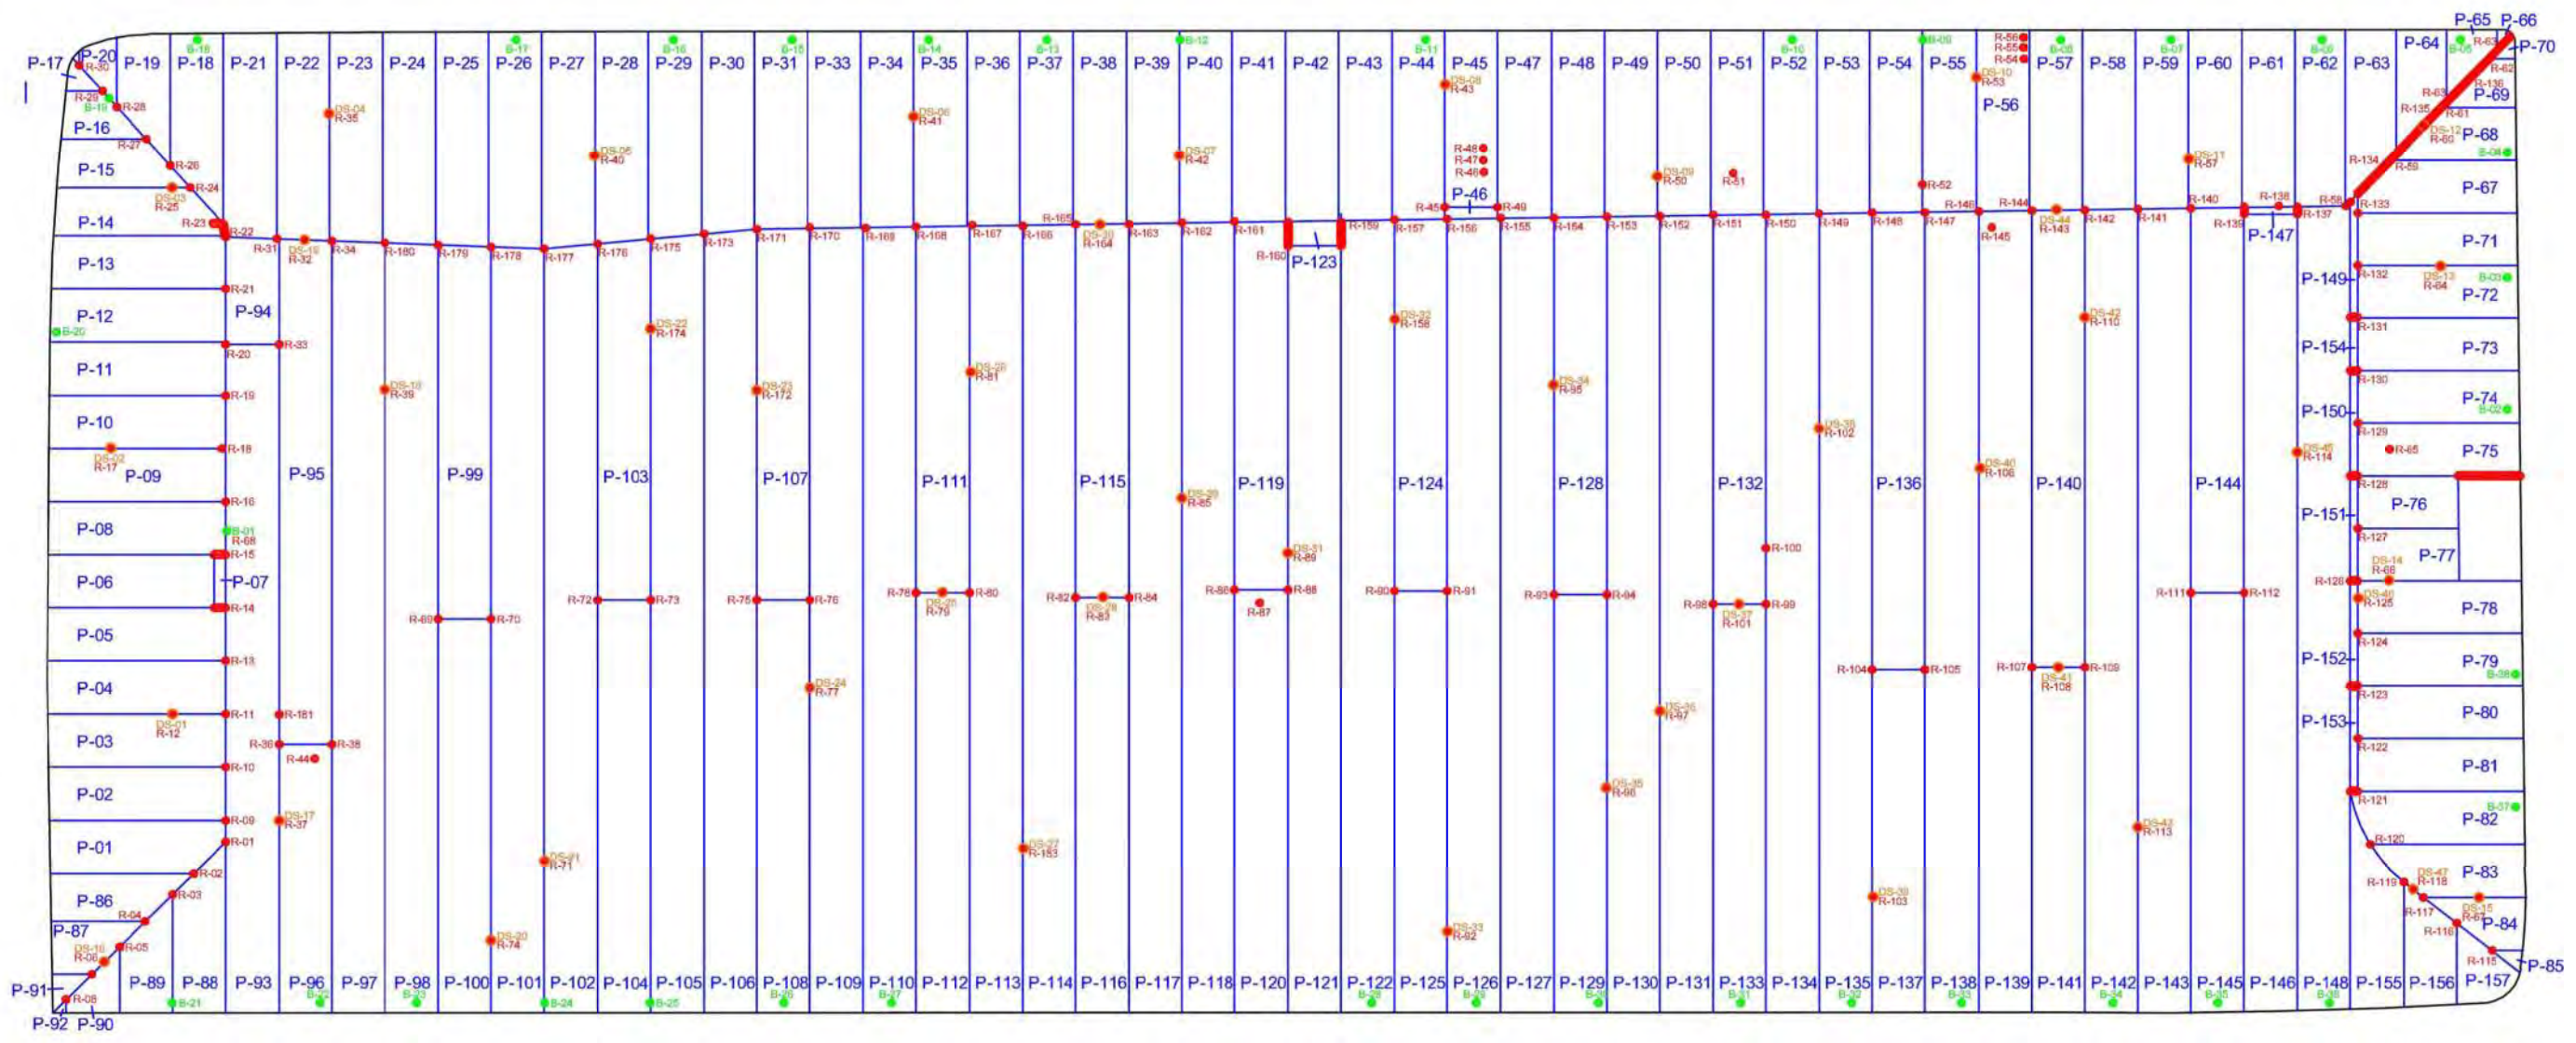

- GEOMEMBRANE SEAM
- REPAIR
- DESTRUCT
- BOOT

THIS RECORD DRAWING IS A COMPILATION OF THE SEALED ENGINEERING DRAWINGS FOR THIS PROJECT, MODIFIED BY ADDENDA AND CHANGE ORDERS, INFORMATION BY THE CONTRACTOR OR OTHER, NOT ASSOCIATED WITH THE DESIGN ENGINEER, CANNOT BE VERIFIED FOR ACCURACY OR COMPLETENESS. THE ORIGINAL SEALED DRAWINGS ARE ON FILE AT THE OFFICES OF LUMINANT.

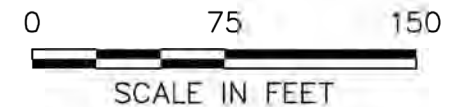

Lone Star Lining Company
 1675 American Way
 Cedar Hill, TX 75104
 Phone: (972) 291-5494
 Fax: (972) 291-5515

LUMINANT, MARTIN LAKE TATUM, TEXAS		EAST ASH POND RE LINE RECORD DRAWING	
11" x 17"	SIZE	DWG NO.	REV
AS SHOWN	SCALE	9/18/2020	DATE SHEET
		22028-rd	



ISSUE	DATE	DESCRIPTION
B	03/26/21	AS-CONSTRUCTED LINER DRAWINGS
A	10/16/20	AS-BUILTS

PROJECT MANAGER	D. VOGT, P.E.
DESIGNED BY	K. PERERA
DRAWN BY	J. RAYMOND
CHECKED BY	M. ROBERTS
PROJECT NUMBER	10172630



**MARTIN LAKE STEAM ELECTRICAL STATION
 EAST ASH POND RELINE
 RUSK COUNTY, TEXAS**



HDPE PANEL LAYOUT





HDR
 Firm Registration No. F-754
 17111 Preston Road, Suite 300
 Dallas, Texas 75248-1229
 972.960.4400



VICINITY MAP
 NOT TO SCALE

As-Built Drawings For

Martin Lake Steam Electric Station

CCR Impoundment Reline West Ash Pond


Project No.
 10172630

Rusk County, Texas
 February 2022


THIS RECORD DRAWING IS A COMPILATION OF THE SEALED ENGINEERING DRAWINGS FOR THIS PROJECT, MODIFIED BY ADDENDA AND CHANGE ORDERS, INFORMATION BY THE CONTRACTOR OR OTHER, NOT ASSOCIATED WITH THE DESIGN ENGINEER. CANNOT BE VERIFIED FOR ACCURACY OR COMPLETENESS. THE ORIGINAL SEALED DRAWINGS ARE ON FILE AT THE OFFICES OF LUMINANT.

INDEX OF DRAWINGS


GENERAL	
00G-01	COVER SHEET
CIVIL	
00C-01	SITE LAYOUT
00C-02	WEST ASH POND
00C-03	CROSS SECTIONS
00C-04	DETAILS (1 OF 2)
00C-05	DETAILS (2 OF 2)
00C-06	HDPE PANEL LAYOUT

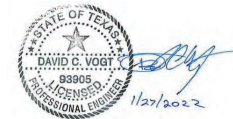

1 2 3 4 5 6 7 8

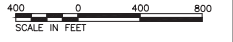

LEGEND
 ——— LIMITS OF CONSTRUCTION
 - - - - - LIMITS OF PDP 5

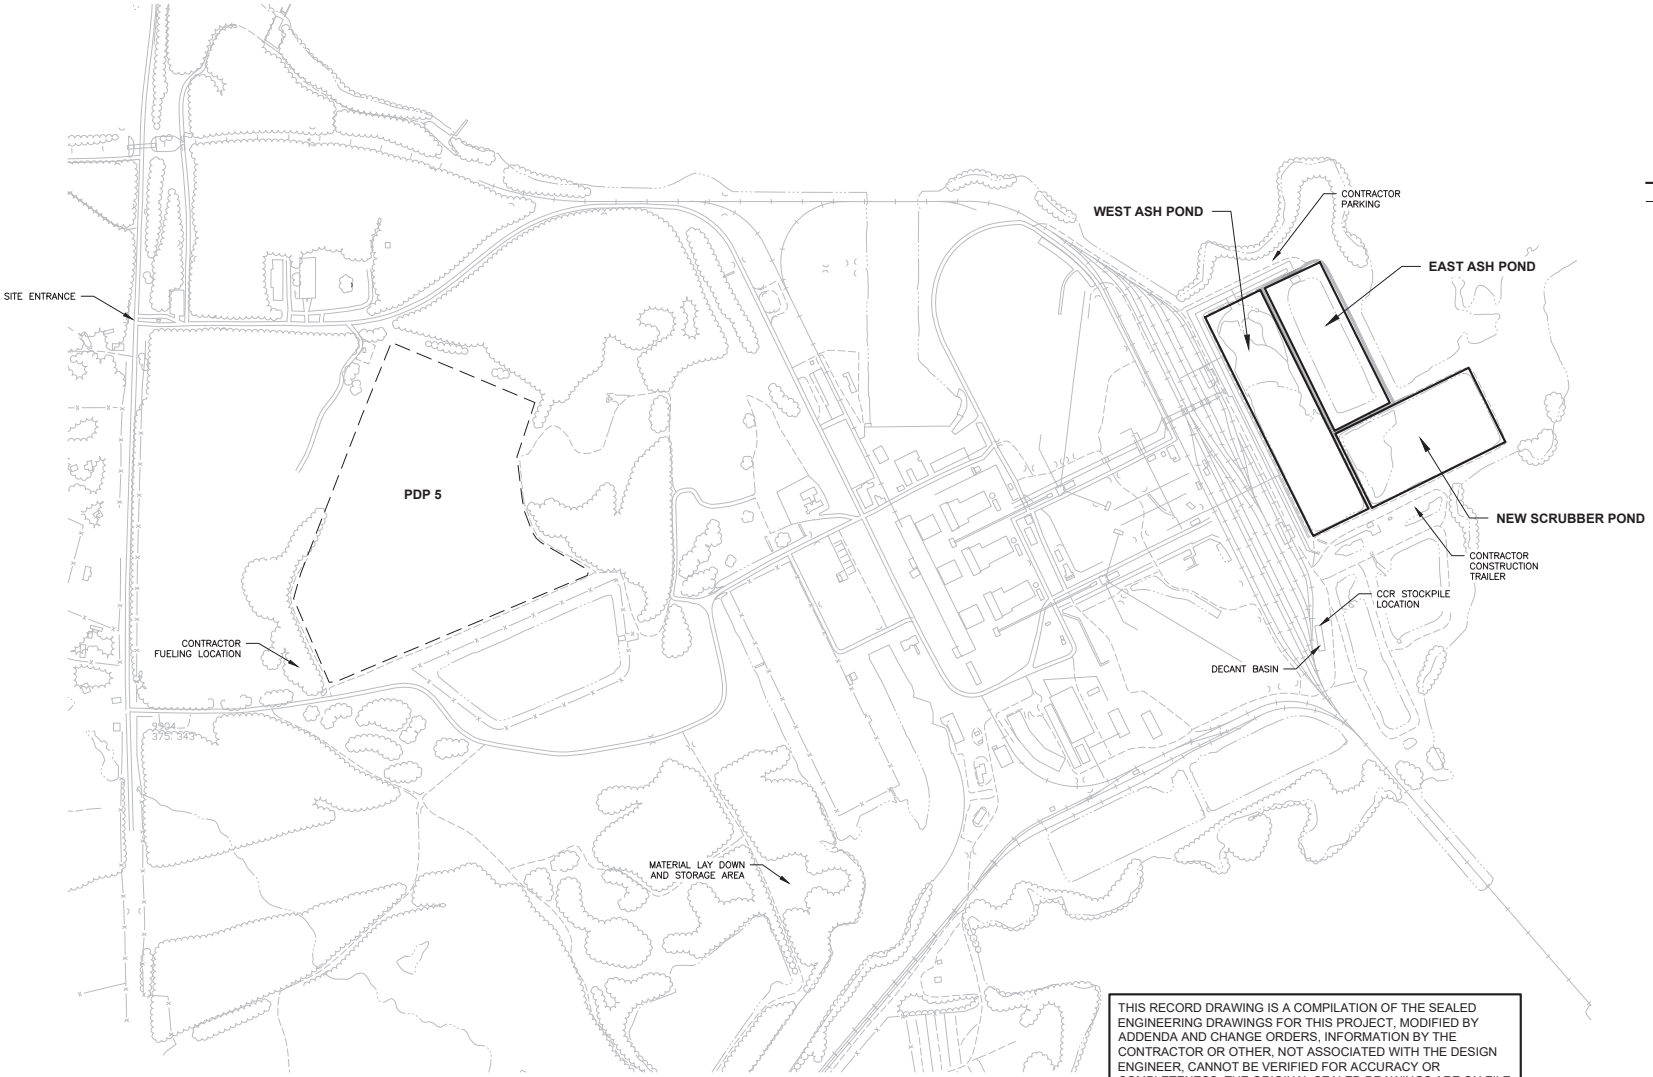

THIS RECORD DRAWING IS A COMPILATION OF THE SEALED ENGINEERING DRAWINGS FOR THIS PROJECT, MODIFIED BY ADDENDA AND CHANGE ORDERS. INFORMATION BY THE CONTRACTOR OR OTHER, NOT ASSOCIATED WITH THE DESIGN ENGINEER, CANNOT BE VERIFIED FOR ACCURACY OR COMPLETENESS. THE ORIGINAL SEALED DRAWINGS ARE ON FILE AT THE OFFICES OF LUMINANT.



ISSUE	DATE	DESCRIPTION
C	02/07/2022	AS-CONSTRUCTED LINER DRAWINGS
B	09/02/2021	ADDED ACCESS RAMP
A	01/31/2020	ISSUED FOR BID

PROJECT MANAGER	D. VOGT, P.E.
DESIGNED BY	K. PERERA
DRAWN BY	J. RAYMOND
CHECKED BY	M. ROBERTS
PROJECT NUMBER	10172630




Martin Lake West Ash Pond CCR Report
 Page 15 of 682

**MARTIN LAKE STEAM ELECTRICAL STATION
 WEST ASH POND RELINE
 RUSK COUNTY, TEXAS**



FILENAME | 00C-01.dwg
 SCALE | 1" = 400'

SHEET
00C-01

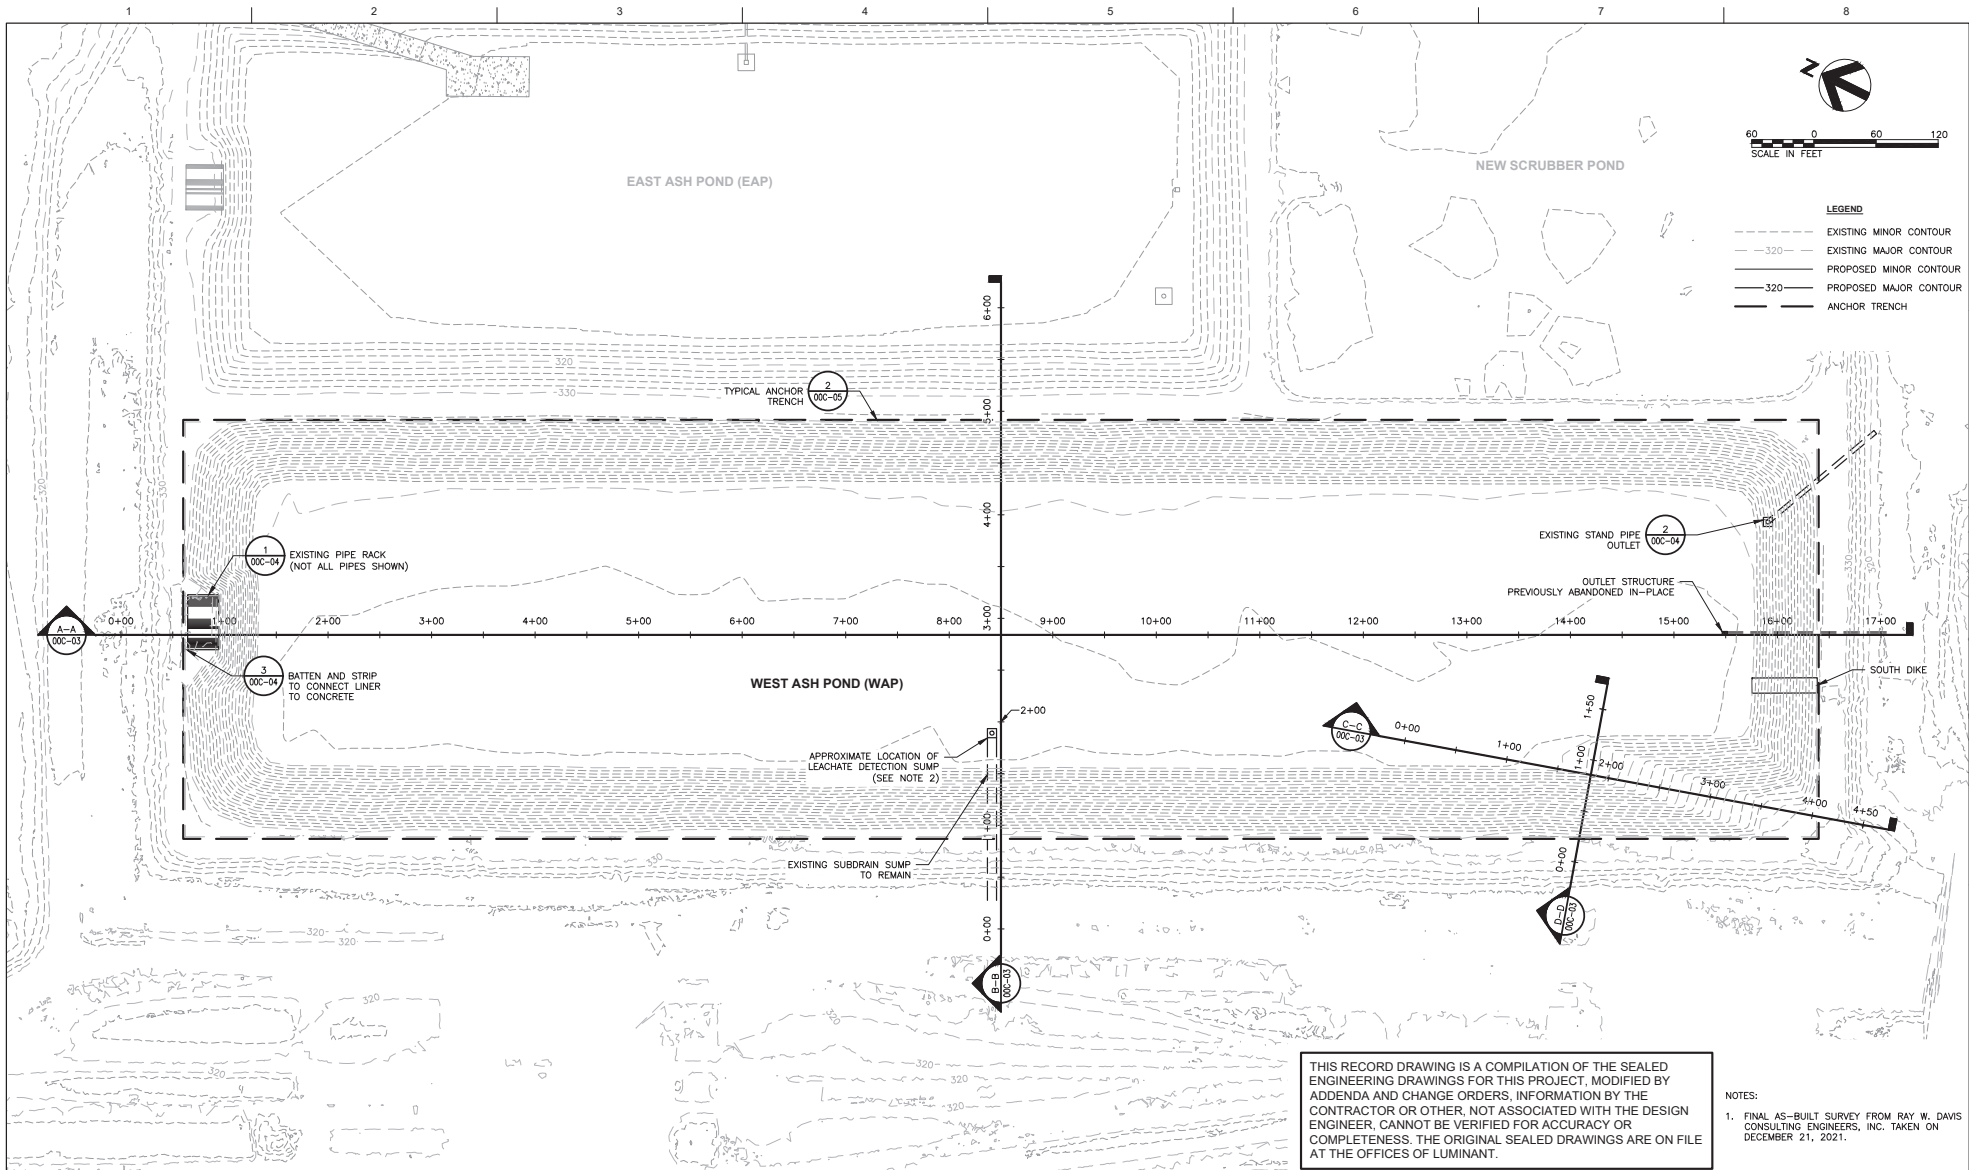

THIS RECORD DRAWING IS A COMPILATION OF THE SEALED ENGINEERING DRAWINGS FOR THIS PROJECT, MODIFIED BY ADDENDA AND CHANGE ORDERS. INFORMATION BY THE CONTRACTOR OR OTHER, NOT ASSOCIATED WITH THE DESIGN ENGINEER, CANNOT BE VERIFIED FOR ACCURACY OR COMPLETENESS. THE ORIGINAL SEALED DRAWINGS ARE ON FILE AT THE OFFICES OF LUMINANT.

- NOTES:
1. FINAL AS-BUILT SURVEY FROM RAY W. DAVIS CONSULTING ENGINEERS, INC. TAKEN ON DECEMBER 21, 2021.



ISSUE	DATE	DESCRIPTION
C	02/07/2022	AS-CONSTRUCTED LINER DRAWINGS
B	09/02/2021	ADDED ACCESS RAMP
A	01/31/2020	ISSUED FOR BID

PROJECT MANAGER	D. VOGT, P.E.
DESIGNED BY	K. PERERA
DRAWN BY	J. RAYMOND
CHECKED BY	M. ROBERTS
PROJECT NUMBER	10172630



Martin Lake West Ash Pond CDA Report
Page 16 of 682


MARTIN LAKE STEAM ELECTRICAL STATION
WEST ASH POND RELINE
RUSK COUNTY, TEXAS




FILENAME 00C-02.dwg
SCALE 1" = 60'

WEST ASH POND


SHEET
00C-02

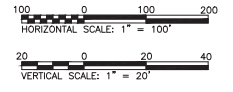


LEGEND
 - - - - - EXISTING GROUND SURFACE
 _____ PROPOSED GRADE
 _____ ASBUILT GRADE

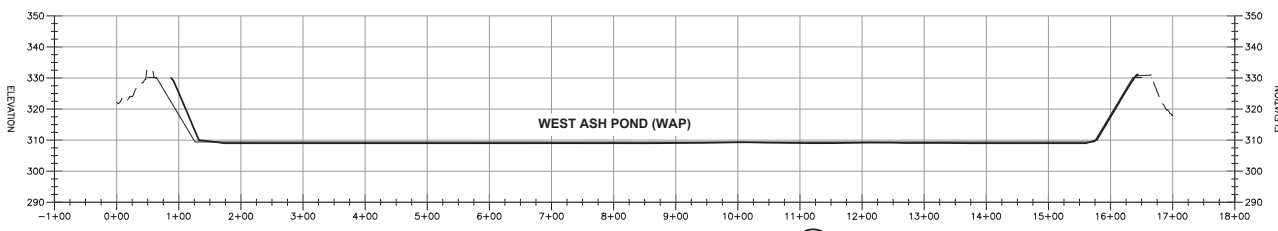


SECTION A-A
 HORIZONTAL SCALE: 1" = 100'; VERTICAL SCALE: 1" = 20' A-A
00C-02

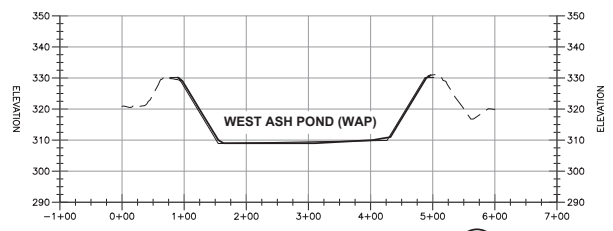

SECTION B-B
 HORIZONTAL SCALE: 1" = 100'; VERTICAL SCALE: 1" = 20' B-B
00C-02

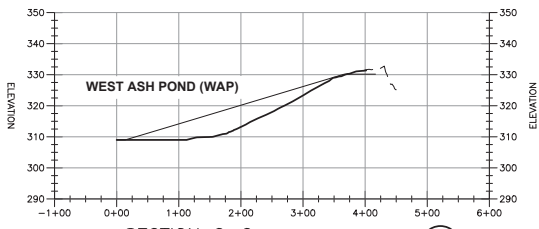

SECTION C-C
 HORIZONTAL SCALE: 1" = 100'; VERTICAL SCALE: 1" = 20' C-C
00C-02

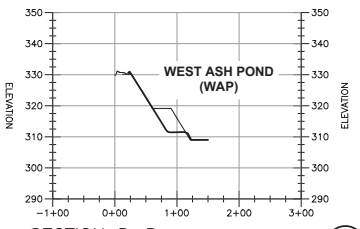


SECTION D-D
 HORIZONTAL SCALE: 1" = 100'; VERTICAL SCALE: 1" = 20' D-D
00C-02

THIS RECORD DRAWING IS A COMPILATION OF THE SEALED ENGINEERING DRAWINGS FOR THIS PROJECT, MODIFIED BY ADDENDA AND CHANGE ORDERS. INFORMATION BY THE CONTRACTOR OR OTHER, NOT ASSOCIATED WITH THE DESIGN ENGINEER, CANNOT BE VERIFIED FOR ACCURACY OR COMPLETENESS. THE ORIGINAL SEALED DRAWINGS ARE ON FILE AT THE OFFICES OF LUMINANT.



ISSUE	DATE	DESCRIPTION
C	02/07/2022	AS-CONSTRUCTED LINER DRAWINGS
B	09/02/2021	ADDED ACCESS RAMP
A	01/31/2020	ISSUED FOR BID

PROJECT MANAGER	D. VOGT, P.E.
DESIGNED BY	K. PERERA
DRAWN BY	J. RAYMOND
CHECKED BY	M. ROBERTS
PROJECT NUMBER	10172630

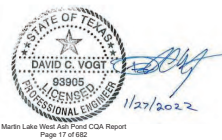


**MARTIN LAKE STEAM ELECTRICAL STATION
 WEST ASH POND RELINE
 RUSK COUNTY, TEXAS**



CROSS SECTIONS




FILENAME: 00C-03.dwg
 SHEET: **00C-03**

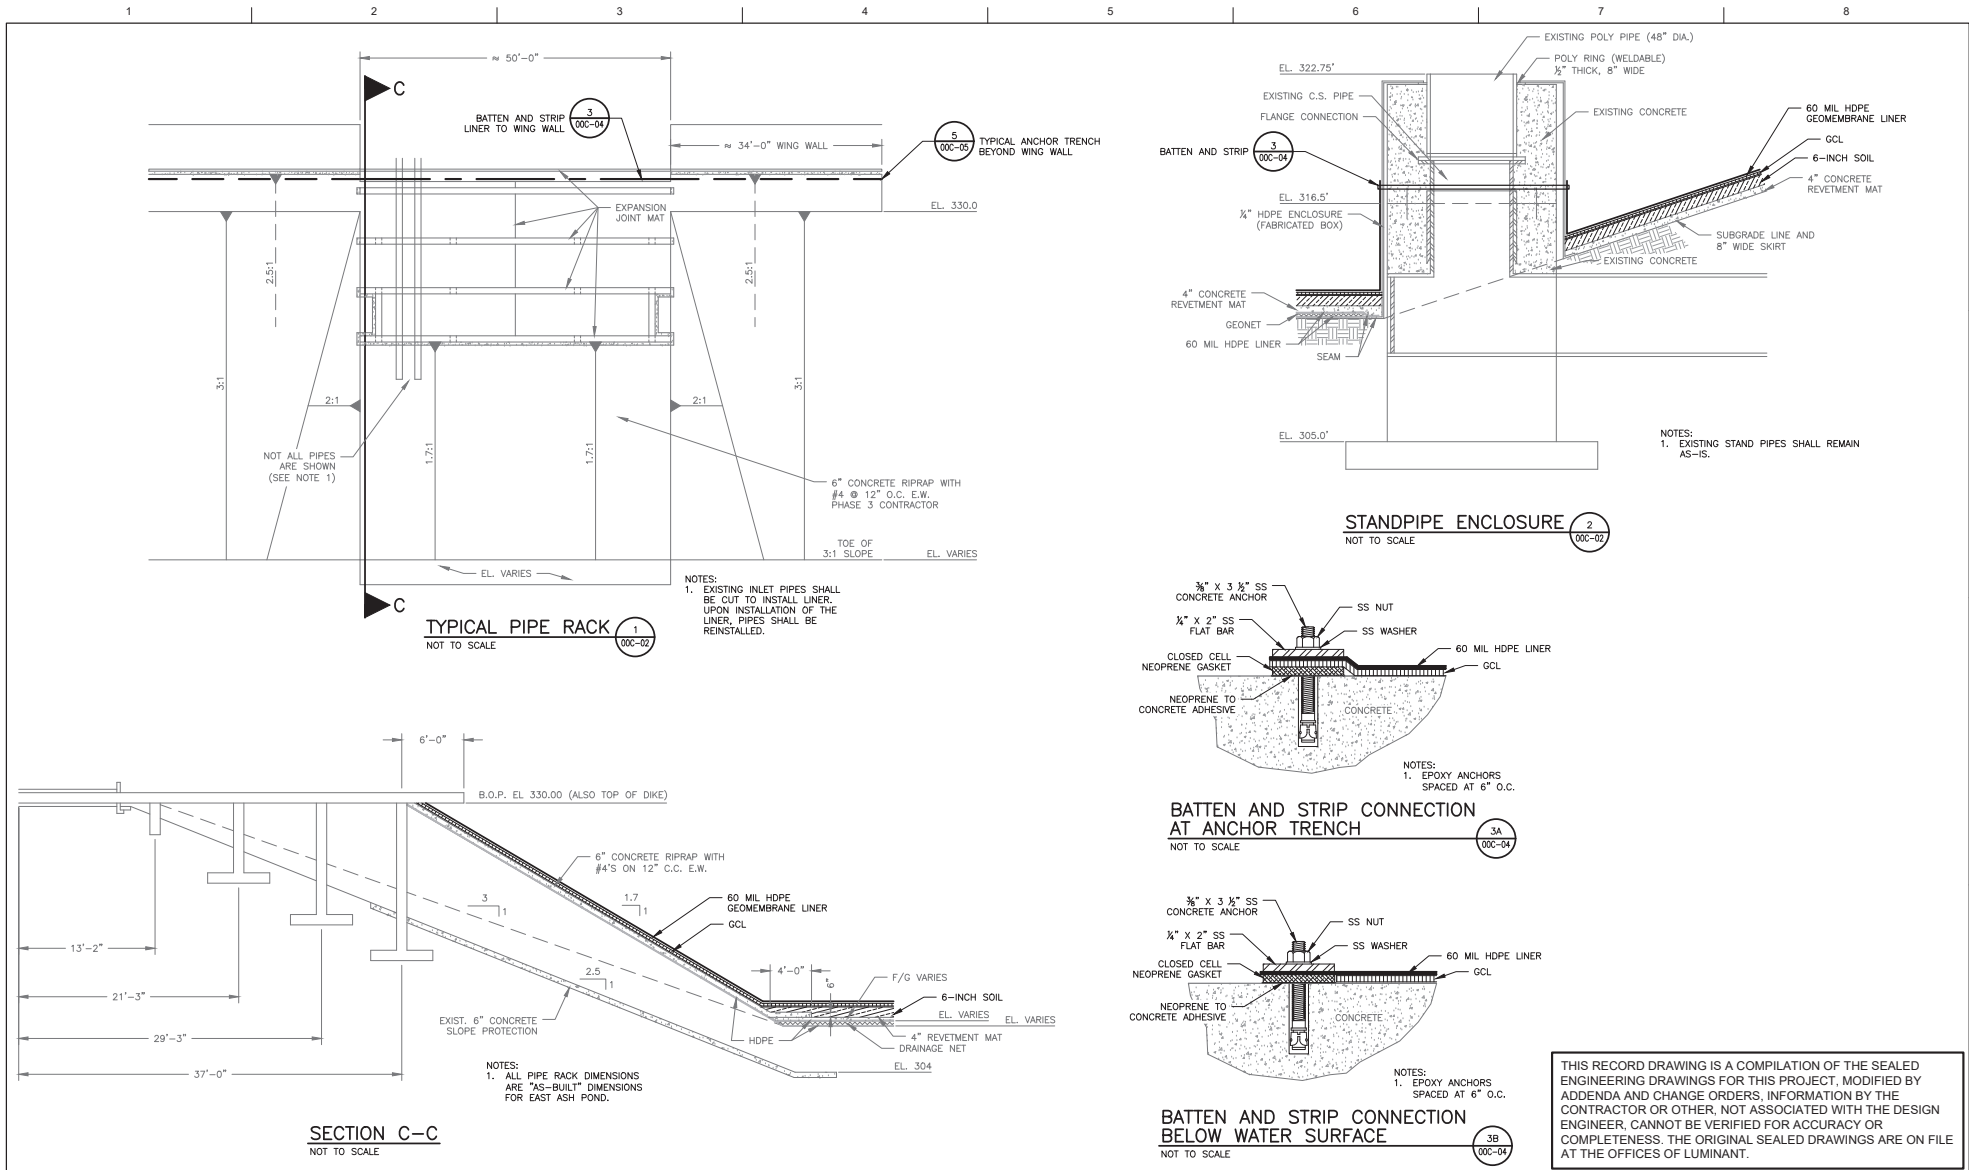

ISSUE	DATE	DESCRIPTION
C	02/07/2022	AS-CONSTRUCTED LINER DRAWINGS
B	09/02/2021	ADDED ACCESS RAMP
A	01/31/2020	ISSUED FOR BID

PROJECT MANAGER	D. VOGT, P.E.
DESIGNED BY	K. PERERA
DRAWN BY	J. RAYMOND
CHECKED BY	M. ROBERTS
PROJECT NUMBER	10172630

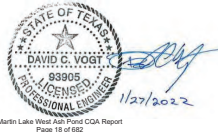


MARTIN LAKE STEAM ELECTRICAL STATION
WEST ASH POND RELINE
RUSK COUNTY, TEXAS




FILENAME | 00C-04.dwg
SCALE

SHEET
00C-04


THIS RECORD DRAWING IS A COMPILATION OF THE SEALED ENGINEERING DRAWINGS FOR THIS PROJECT, MODIFIED BY ADDENDA AND CHANGE ORDERS. INFORMATION BY THE CONTRACTOR OR OTHER, NOT ASSOCIATED WITH THE DESIGN ENGINEER, CANNOT BE VERIFIED FOR ACCURACY OR COMPLETENESS. THE ORIGINAL SEALED DRAWINGS ARE ON FILE AT THE OFFICES OF LUMINANT.

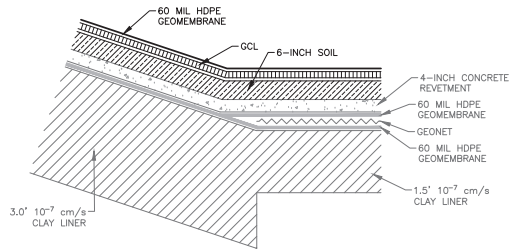

PROPOSED WAP SECTION 1
NOT TO SCALE 00C-05

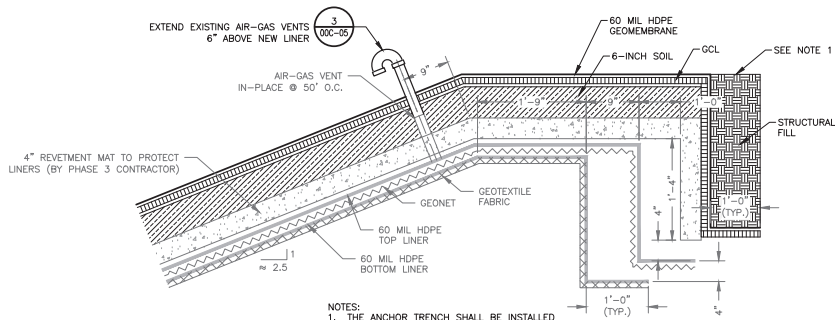

ANCHOR TRENCH 2
NOT TO SCALE 00C-02

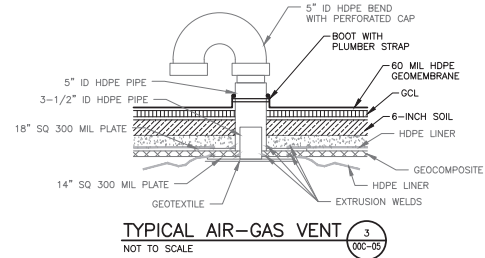


TYPICAL AIR-GAS VENT 3
NOT TO SCALE 00C-05

THIS RECORD DRAWING IS A COMPILATION OF THE SEALED ENGINEERING DRAWINGS FOR THIS PROJECT, MODIFIED BY ADDENDA AND CHANGE ORDERS. INFORMATION BY THE CONTRACTOR OR OTHER, NOT ASSOCIATED WITH THE DESIGN ENGINEER, CANNOT BE VERIFIED FOR ACCURACY OR COMPLETENESS. THE ORIGINAL SEALED DRAWINGS ARE ON FILE AT THE OFFICES OF LUMINANT.



ISSUE	DATE	DESCRIPTION
C	02/07/2022	AS-CONSTRUCTED LINER DRAWINGS
B	02/26/2021	REVISED DETAIL 2
A	01/31/2020	ISSUED FOR BID

PROJECT MANAGER	D. VOGT, P.E.
DESIGNED BY	K. PERERA
DRAWN BY	J. RAYMOND
CHECKED BY	M. ROBERTS
PROJECT NUMBER	10172630

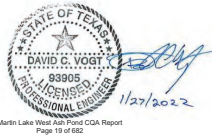


**MARTIN LAKE STEAM ELECTRICAL STATION
WEST ASH POND RELINE
RUSK COUNTY, TEXAS**




FILENAME 00C-05.dwg
SCALE NOT TO SCALE


SHEET
00C-05

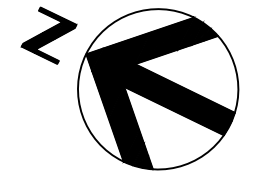

60 0 60 120
SCALE IN FEET

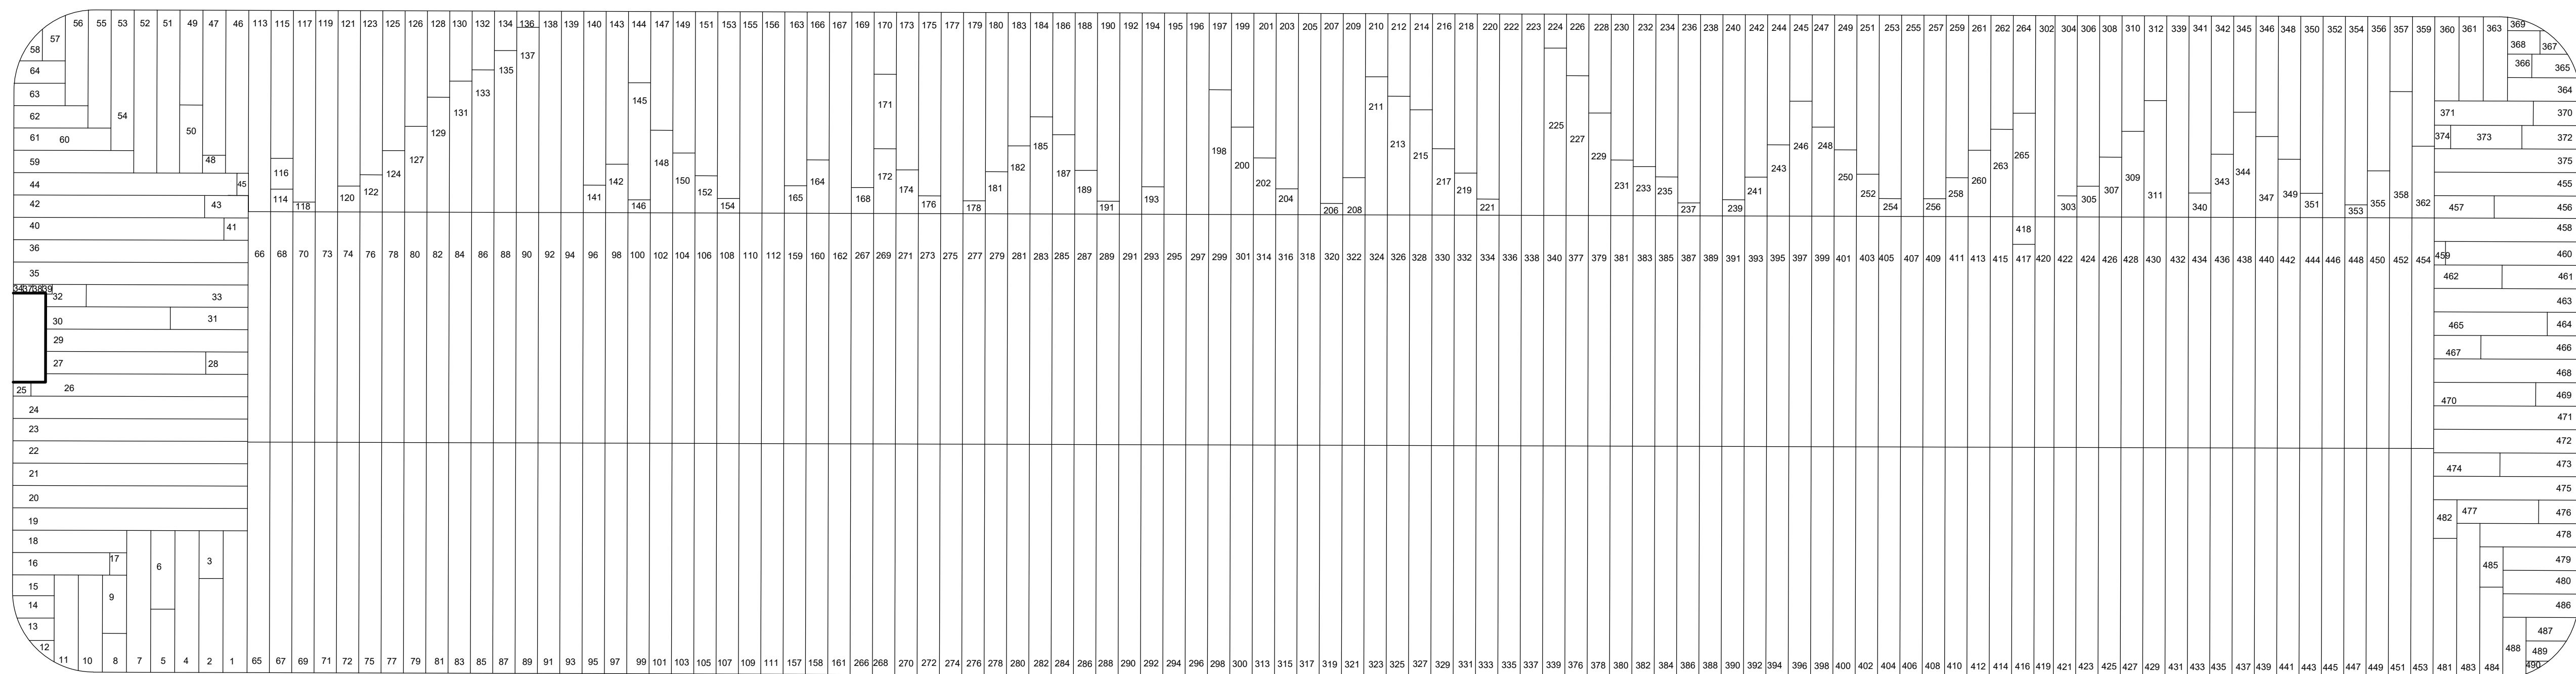

THIS RECORD DRAWING IS A COMPILATION OF THE SEALED ENGINEERING DRAWINGS FOR THIS PROJECT, MODIFIED BY ADDENDA AND CHANGE ORDERS. INFORMATION BY THE CONTRACTOR OR OTHER, NOT ASSOCIATED WITH THE DESIGN ENGINEER, CANNOT BE VERIFIED FOR ACCURACY OR COMPLETENESS. THE ORIGINAL SEALED DRAWINGS ARE ON FILE AT THE OFFICES OF LUMINANT.

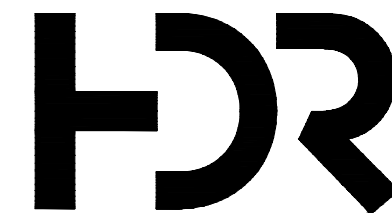

ISSUE	DATE	DESCRIPTION
C	02/07/2022	AS-CONSTRUCTED LINER DRAWINGS
B	08/02/2021	ADDED ACCESS RAMP
A	01/31/2020	ISSUED FOR BID


PROJECT MANAGER	D. VOGT, P.E.
DESIGNED BY	K. PERERA
DRAWN BY	J. RAYMOND
CHECKED BY	M. ROBERTS
PROJECT NUMBER	10172630



**MARTIN LAKE STEAM ELECTRICAL STATION
WEST ASH POND RELINE
RUSK COUNTY, TEXAS**




GCL PANEL LAYOUT

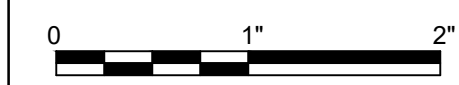

FILENAME | 00C-07.dwg
SCALE | 1" = 60'

SHEET
00C-07

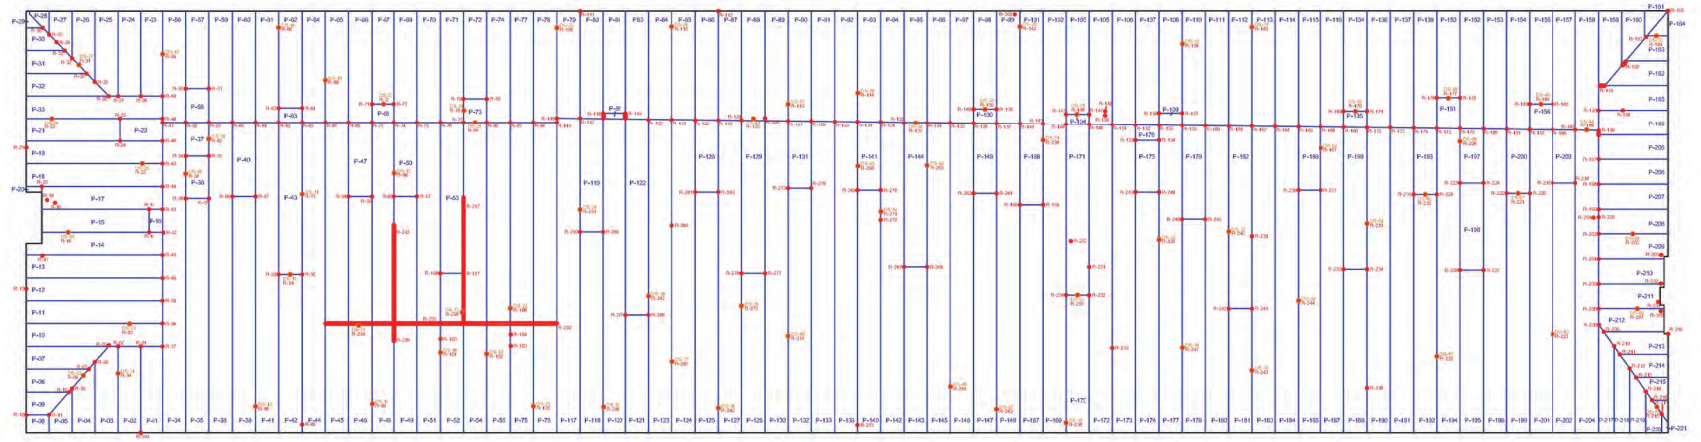


— GEOMEMBRANE SEAM
 ● REPAIR
 ● DESTRICT

THIS RECORD DRAWING IS A COMPILATION OF THE SEALED ENGINEERING DRAWINGS FOR THIS PROJECT, MODIFIED BY ADDENDA AND CHANGE ORDERS. INFORMATION BY THE CONTRACTOR OR OTHER, NOT ASSOCIATED WITH THE DESIGN ENGINEER, CANNOT BE VERIFIED FOR ACCURACY OR COMPLETENESS. THE ORIGINAL SEALED DRAWINGS ARE ON FILE AT THE OFFICES OF LUMINANT.




Lone Star Lining Company
 1675 American Way
 Cedar Hill, TX 75104
 Phone: (972) 291-5494
 Fax: (972) 291-5515

LUMINANT MARTIN LAKE TATUM, TEXAS		WEST ASH POND RECORD DRAWING	
11" x 17"	SIZE	DWG NO.	REV
AS SHOWN	SCALE	12/20/2021	DATE SHEET

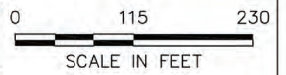

ISSUE	DATE	DESCRIPTION
C	02/07/2022	AS-CONSTRUCTED LINER DRAWINGS
B	09/02/2021	ADDED ACCESS RAMP
A	01/31/2020	ISSUED FOR BID


PROJECT MANAGER	D. VOGT, P.E.
DESIGNED BY	K. PERERA
DRAWN BY	J. RAYMOND
CHECKED BY	M. ROBERTS
PROJECT NUMBER	10172630

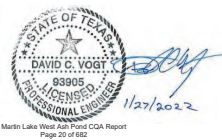

**MARTIN LAKE STEAM ELECTRICAL STATION
 WEST ASH POND RELINE
 RUSK COUNTY, TEXAS**



HDPE PANEL LAYOUT

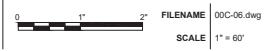

SHEET
00C-06